



- ## WASTEWATER CALCULATIONS

WATER MAIN JOINT DEFLECTION NOTE (PVC 4"-24")



UTILITY NOTES

- ### UTILITY DISCLAIMER

APPROVAL OF THESE PLANS SHALL NOT BE CONSTRUED TO BE A PERMIT FOR, OR AN APPROVAL OF, ANY VIOLATION OF ANY OF THE PROVISIONS OF THE STATE OR COUNTY LAWS. FIRE FLOW = 2,000 G.P.M. AT 20 PSI RESIDUAL.

Avoid overhead power line contact. It's costly.

Call
before you
Overhead
1-702-227-2929

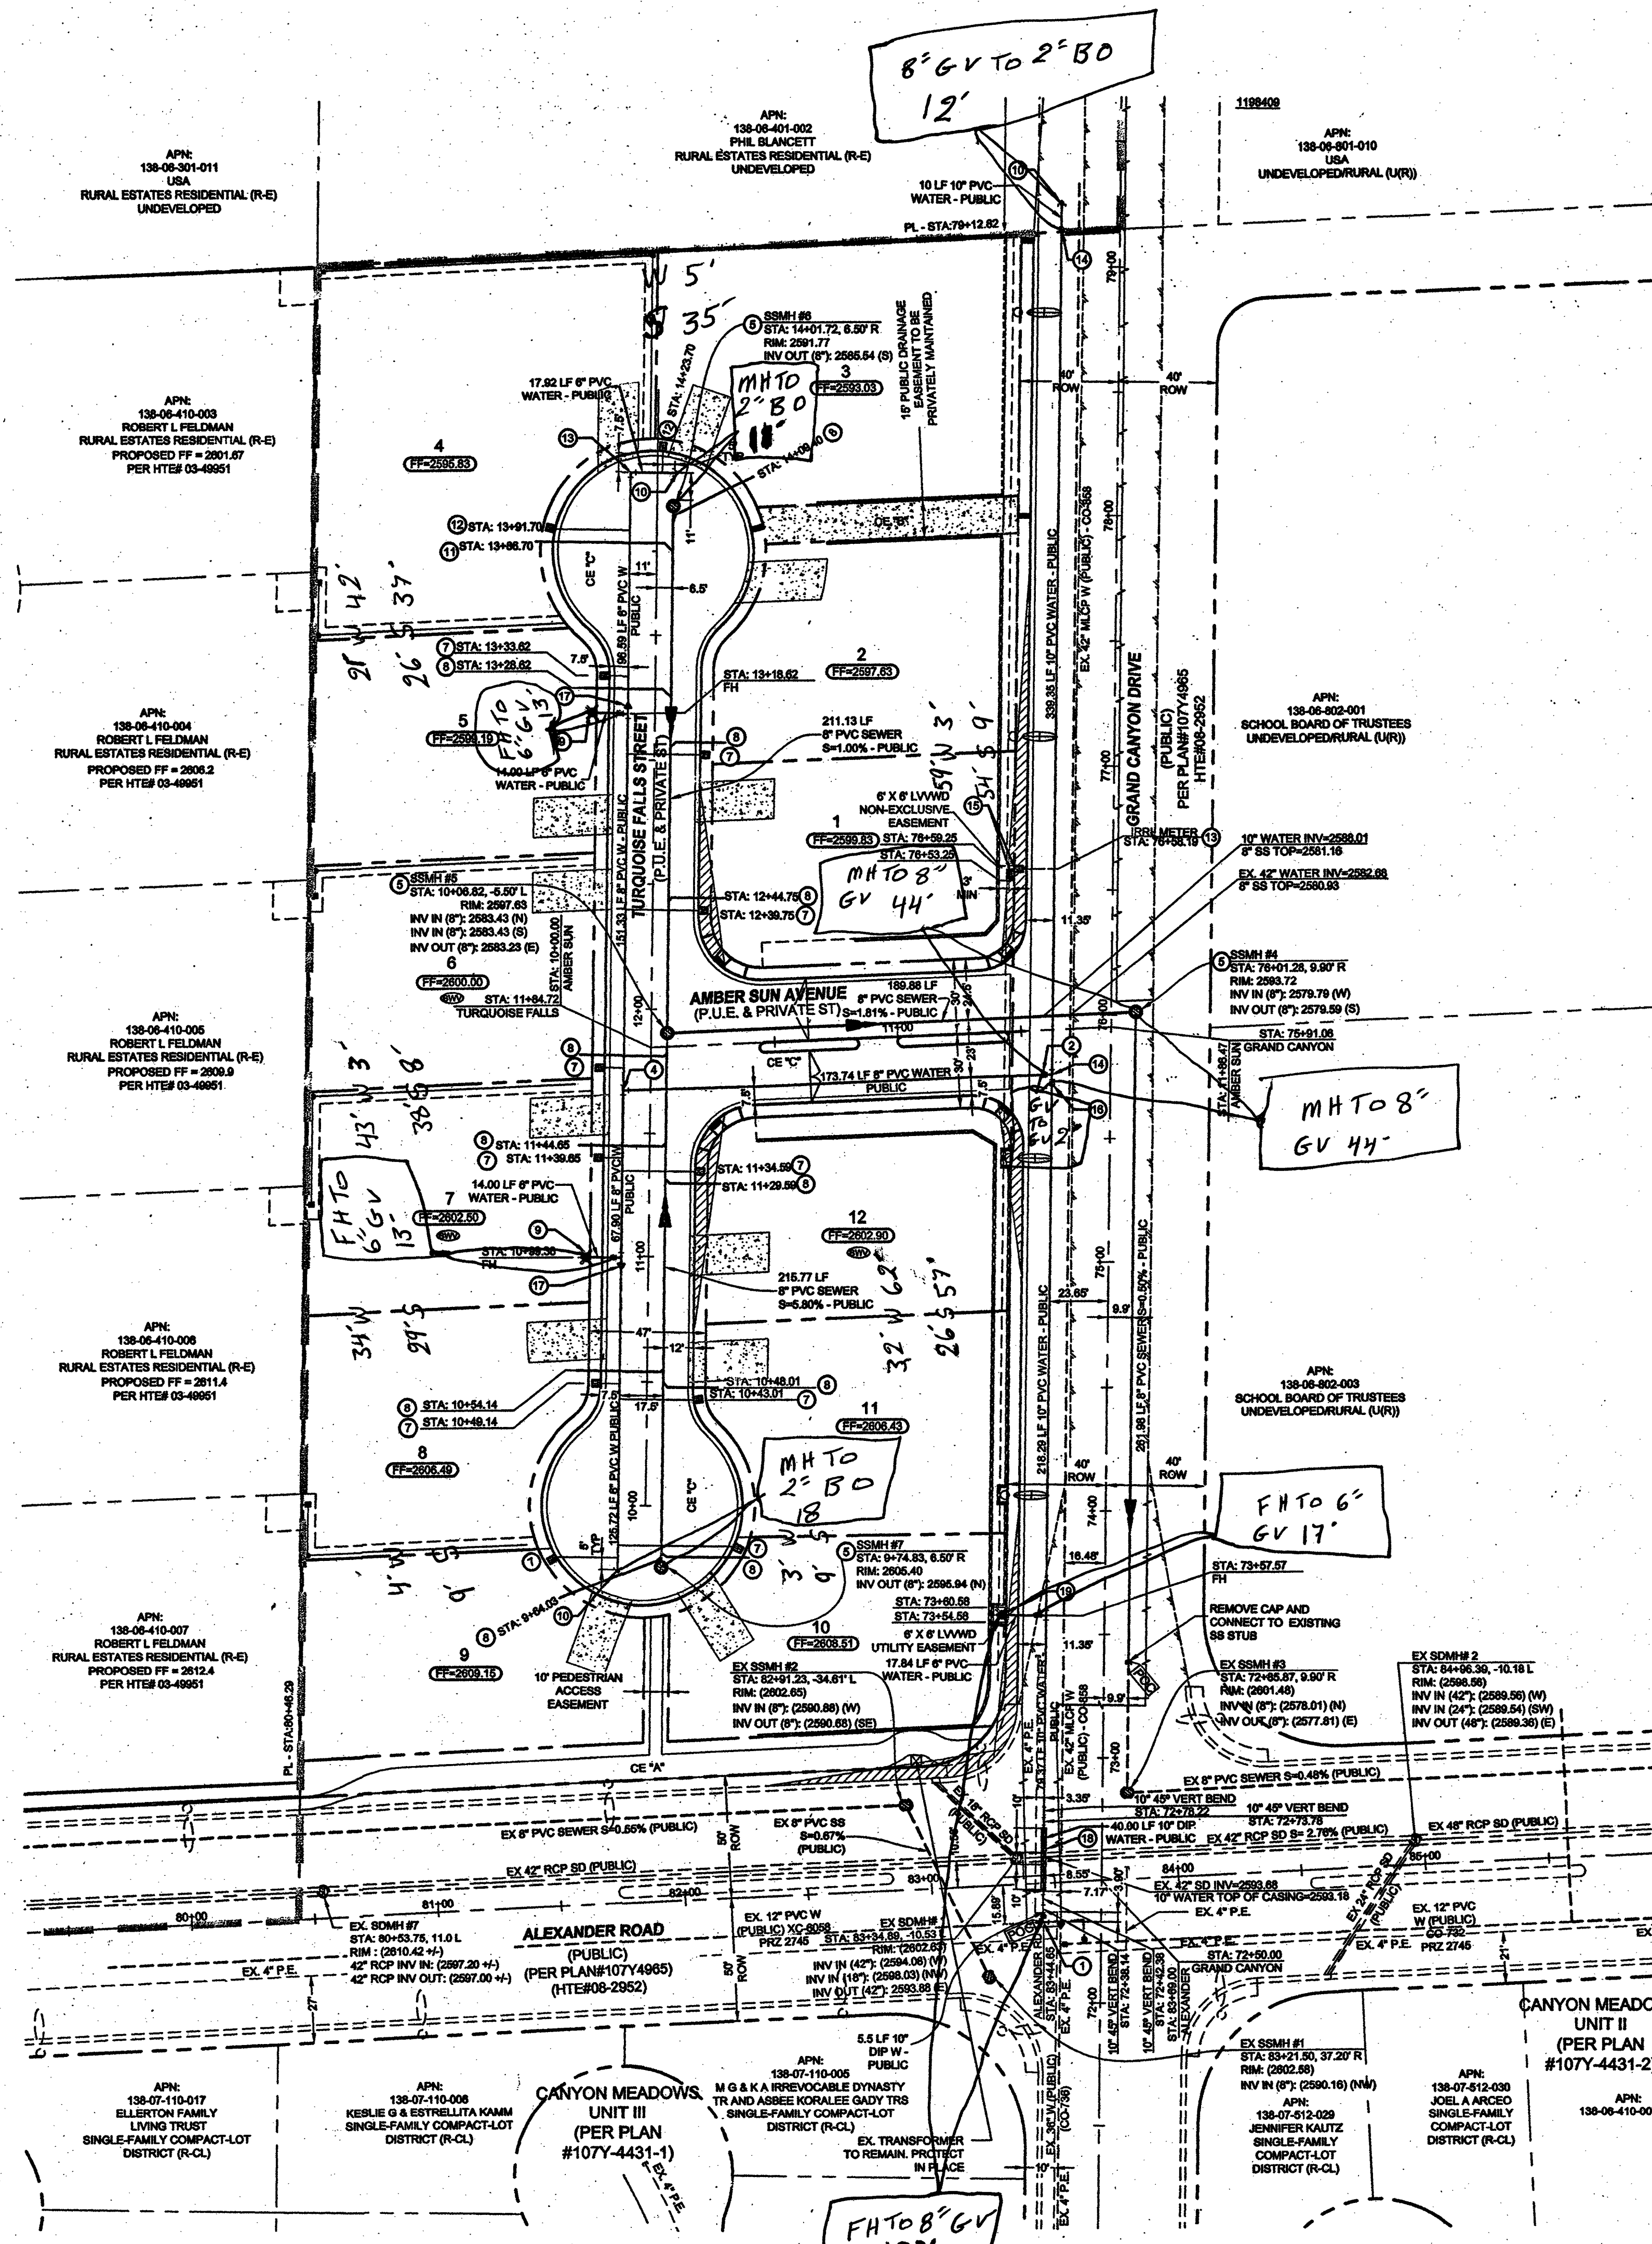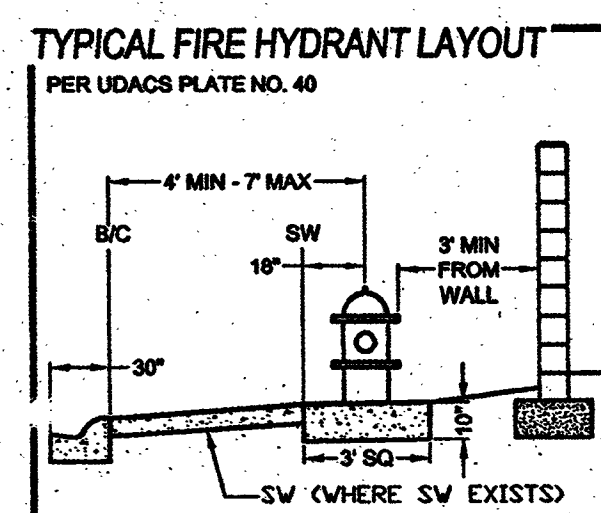

DATE:		5/24/16	
SCALE:		5/24/2016	
JOB NO:		ADV-15-012	
DESIGNED BY:		BP	CHECKED BY: BM
SHEET NAME:		UT1	
SHEET NUMBER:		9 OF 10	
CC		HTE#16-13915	
CLV 107K5043		8366A	