
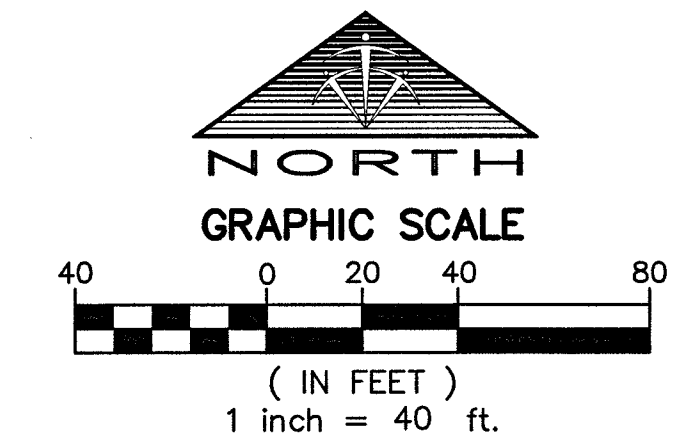


MONUMENT TIE MAP HUALAPAI / SEVERENCE

AS SHOWN BY MAP THERE OF ON FILE IN THE CLARK COUNTY RECORDER'S OFFICE IN
BOOK 151, PAGE 89 OF PLATS, BEING A SUBDIVISION OF GOVERNMENT LOTS 31, 32, 33 AND 34
OF SECTION 18, TOWNSHIP 19 SOUTH, RANGE 60 EAST, M.D.M.,
CITY OF LAS VEGAS, CLARK COUNTY, NEVADA.

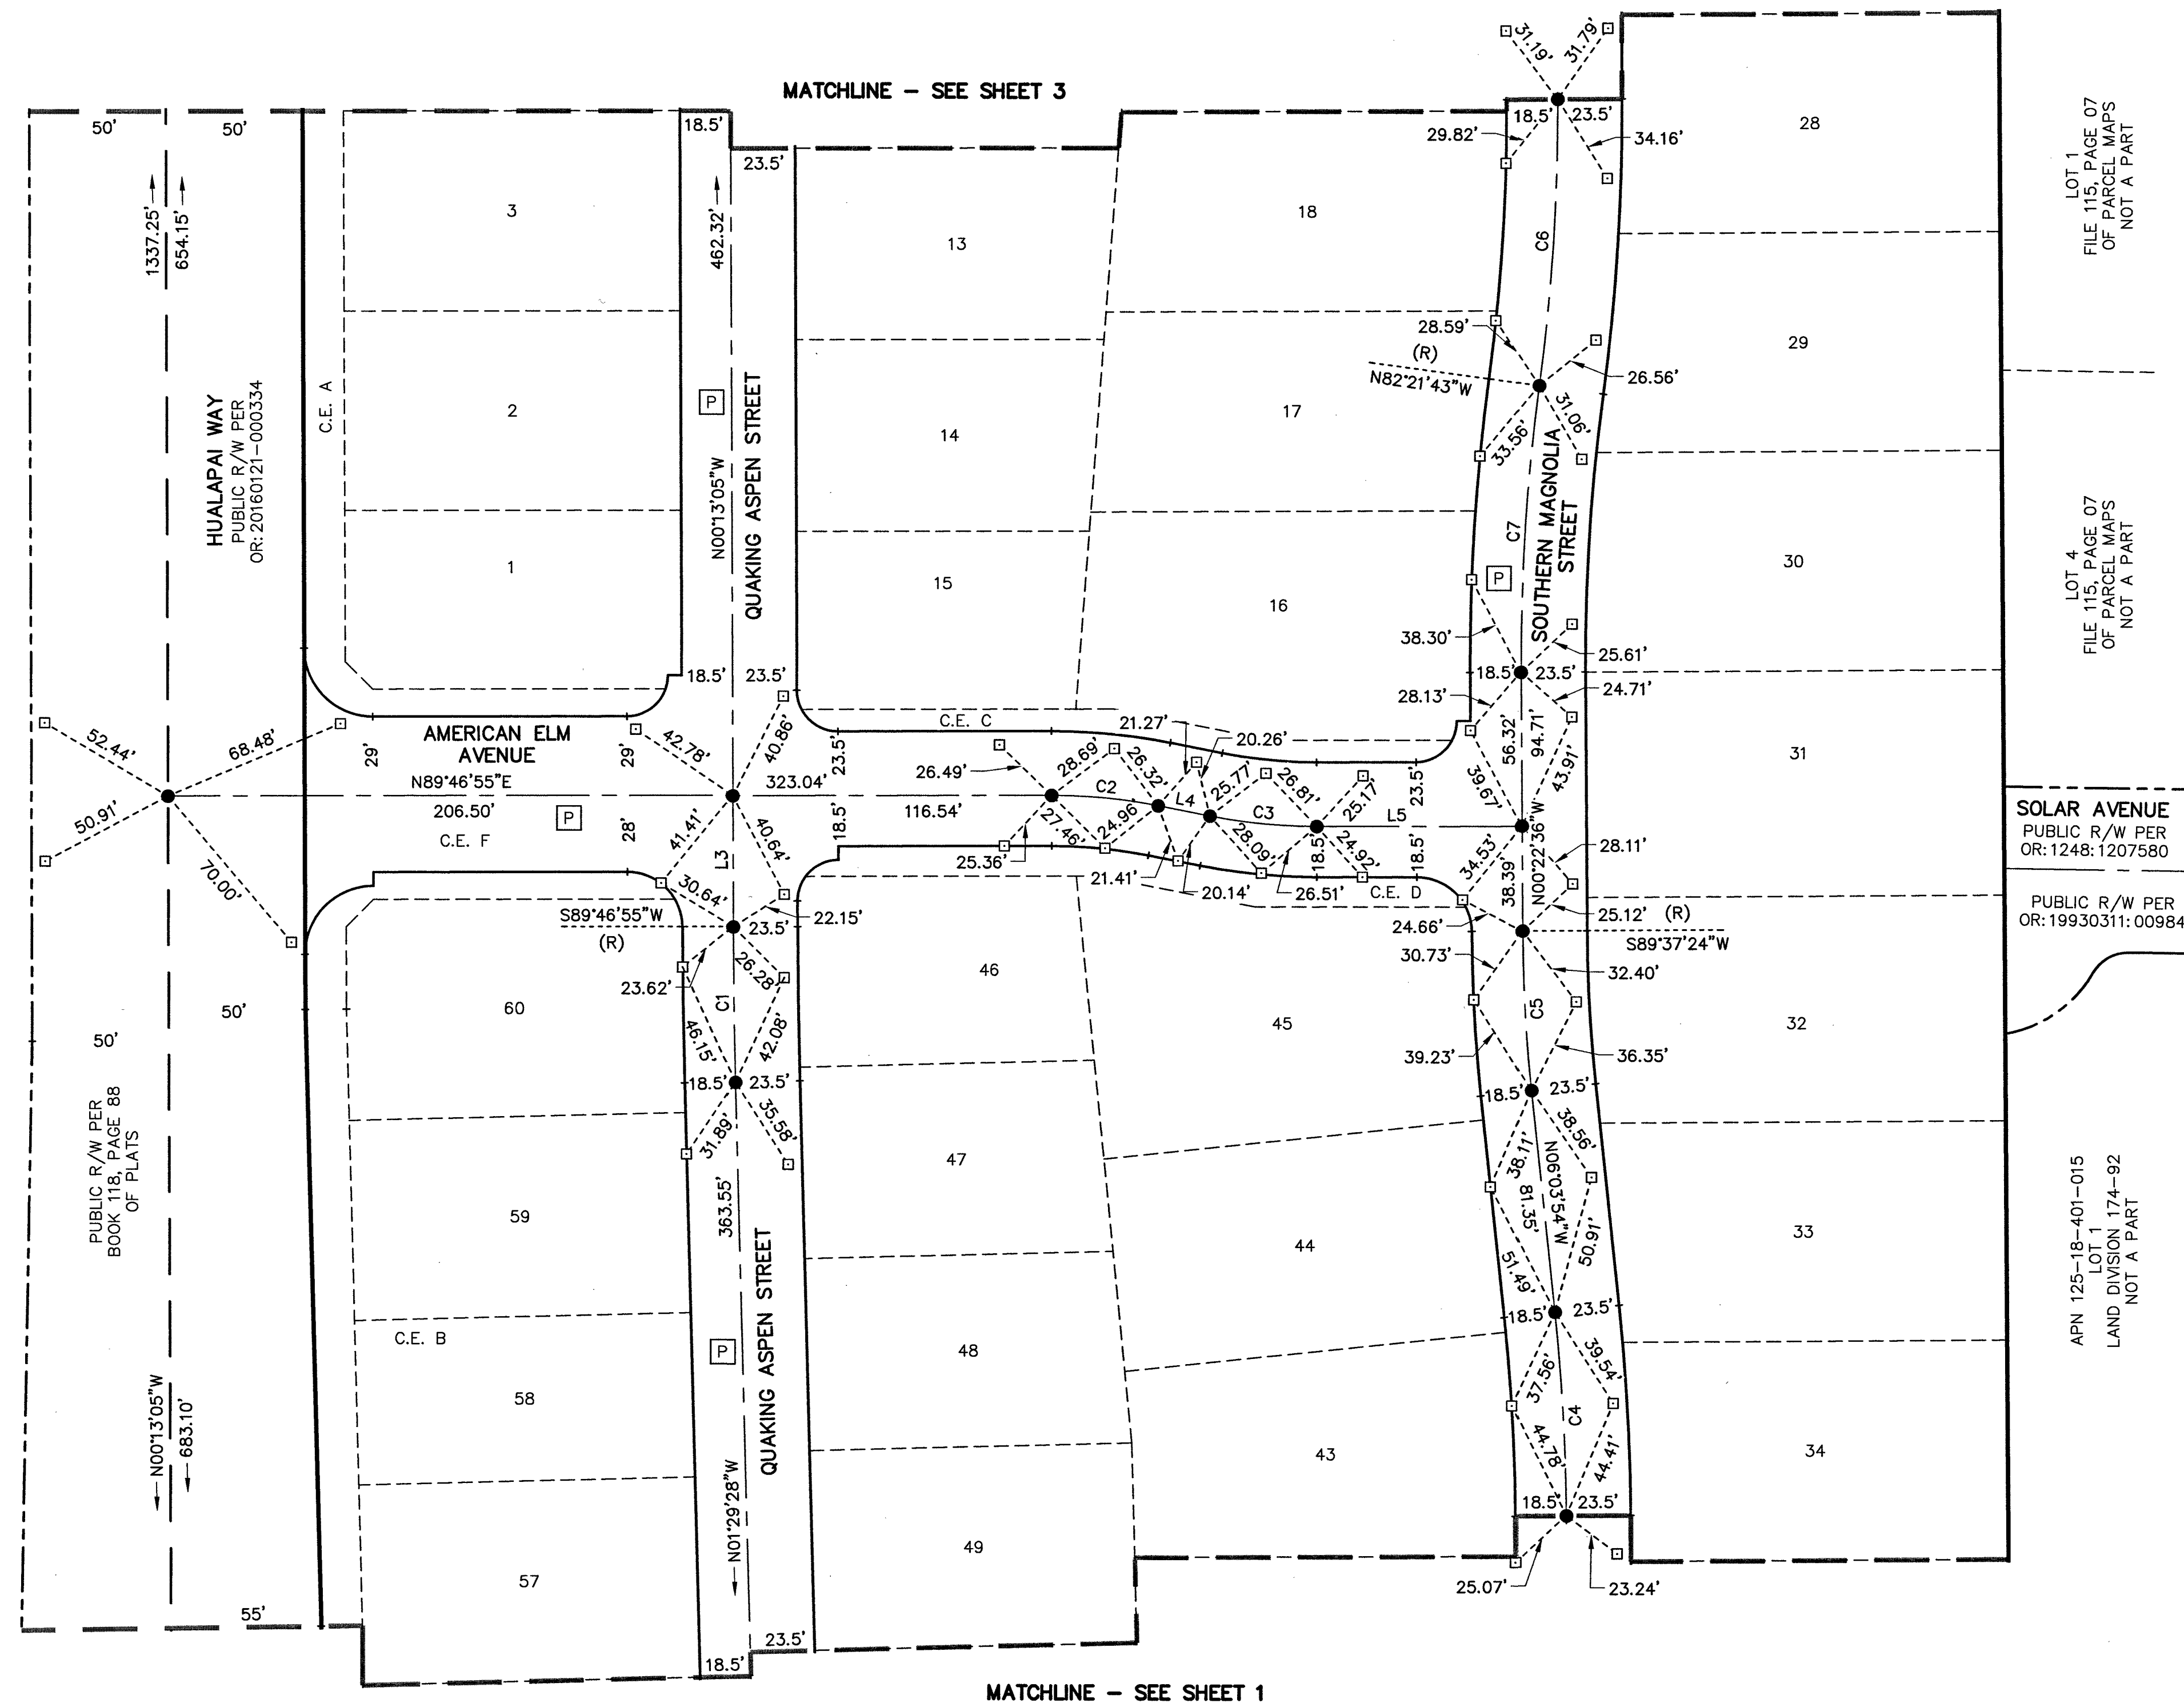

LEGEND

- SUBDIVISION BOUNDARY LINE
- SECTION LINE
- ALIQUOT LINE
- ASSESSOR'S PARCEL LINE
- EXISTING RIGHT-OF-WAY LINE
- STREET CENTERLINE
- MONUMENT TIE LINE
- MATCHLINE
- FOUND MONUMENT AS DESCRIBED
- SET TYPE III MONUMENT STAMPED "PLS 14414"
- SET TYPE IV-A REFERENCE MONUMENTS STAMPED "PLS 14414" WITH DISTANCE AS NOTED
- P PRIVATE STREET, P.U.E., PUBLIC SEWER EASEMENT AND PUBLIC DRAINAGE EASEMENT PER BOOK 151, PAGE 89 OF PLATS
- C.E. COMMON ELEMENT LOT
- L1 LINE SEGMENT
- C1 CURVE SEGMENT
- (R) RADIAL BEARING
- APN ASSESSOR'S PARCEL NUMBER
- P.U.E. PUBLIC UTILITY EASEMENT
- R/W RIGHT-OF-WAY
- OR: OFFICIAL RECORDS, CLARK COUNTY, NEVADA

SOLAR AVENUE
PUBLIC R/W PER
OR: 1248:1207580


PUBLIC R/W PER
OR: 19930311:00984

APN 125-18-401-015
LOT 1
LAND DIVISION 174-92
NOT A PART

LINE TABLE		
LINE	BEARING	LENGTH
L3	N00°13'05"W	48.00'
L4	N78°58'05"W	19.29'
L5	N89°46'55"E	75.00'

CURVE TABLE				
CURVE	DELTA	RADIUS	LENGTH	TANGENT
C1	1°16'23"	2552.38'	56.71'	28.36'
C2	11°15'00"	200.00'	39.27'	19.70'
C3	11°15'00"	200.00'	39.27'	19.70'
C4	5°41'18"	750.00'	74.46'	37.26'
C5	5°41'18"	588.02'	58.38'	29.21'
C6	8°00'52"	750.00'	104.91'	52.54'
C7	8°00'52"	750.00'	104.91'	52.54'

AS SHOWN BY MAP THERE OF ON FILE IN THE CLARK COUNTY RECORDER'S OFFICE IN
BOOK 151, PAGE 89 OF PLATS, BEING A SUBDIVISION OF GOVERNMENT LOTS 31, 32, 33 AND 34
OF SECTION 18, TOWNSHIP 19 SOUTH, RANGE 60 EAST, M.D.M.,
CITY OF LAS VEGAS, CLARK COUNTY, NEVADA.

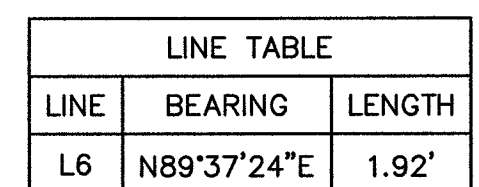

A circular professional seal for a land surveyor in the state of Nevada. The outer ring contains the text "PROFESSIONAL LAND SURVEYOR" at the top and "STATE OF NEVADA" at the bottom. In the center, the name "MICHAEL A. LATHAN" is printed, with "EXPIRES 12-31-19" below it and "No. 14414" at the very bottom. A handwritten signature, "M. A. Lathan", is written across the top half of the seal. Another handwritten mark, "12/31/19", is at the bottom right.