






"FIRE FLOW DATA - UFC APPENDIX III-A"

BUILDING HEIGHT	44'-0"
NUMBER OF STORY	2
CONSTRUCTION CLASSIFICATION	II-N
LARGEST AREA BETWEEN 4-HOUR WALLS	23,083 SQ. FT.
GROUND FLOOR EXISTING	16,938 SQ. FT.
2ND FLOOR EXISTING	4085 SQ. FT.
GROUND FLOOR ADDITION	1152 SQ. FT.
2ND FLOOR ADDITION	908 SQ. FT.
TOTAL	23,083 SQ. FT.
FIRE SPRINKLERS PROVIDED	YES
ESTIMATED FIRE FLOW AT 20 PSI RESIDUAL	1625 GPM

F.D. REVIEWED BY: *K. Kirk*  
 DATE: *5/14/01*

- NOTES
- ① EX. FIRE HYDRANT 2 EA. THIS SHEET
  - ② EX. 8" DETECTOR CHECK 1 EA. THIS SHEET
  - ③ EX. "FDC" 1 EA. THIS SHEET

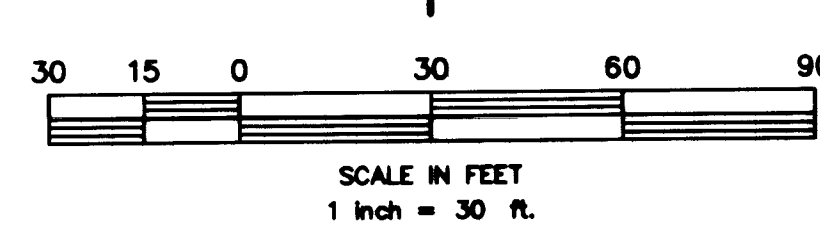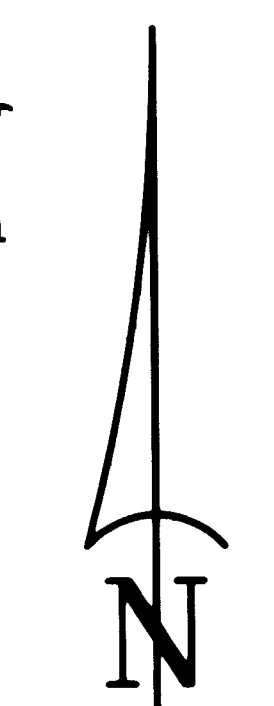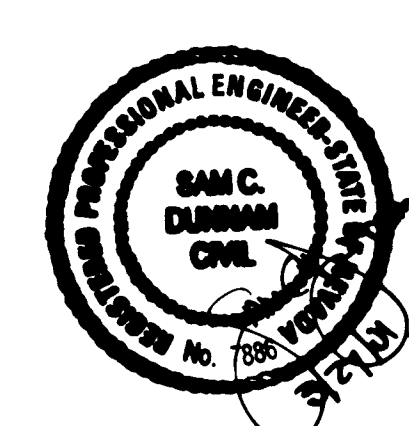

TOPOGRAPHIC MAP FOR  
 LVI PROPERTY DEVELOPMENT L P  
 LOCATED WITHIN SUMMERLIN VILLAGE 1 SOUTH PARCEL 1,  
 A COMMERCIAL SUBDIVISION, BOOK 51 PAGE 26 OF PLATS  
 A PORTION OF THE NW 1/4, OF THE NE 1/4 OF SEC. 30  
 T. 20 S., R. 60 E., M.D.M.  
 CITY OF LAS VEGAS, CLARK COUNTY, NEVADA

WESCO SURVEYS, INC. 3471 WEST OQUENDO ROAD SUITE 101 LAS VEGAS, NEVADA 89118 (702) 367-0588		SHEET <b>5</b> OF SEVEN	
			FILE NAME: LV001A.dwg
CHECKED BY:		FND NAIL & SHINER	

NO.	DATE	REVISION

**LAS VEGAS DENTAL  
 INSTITUTE  
 TOPOGRAPHY**

3254