

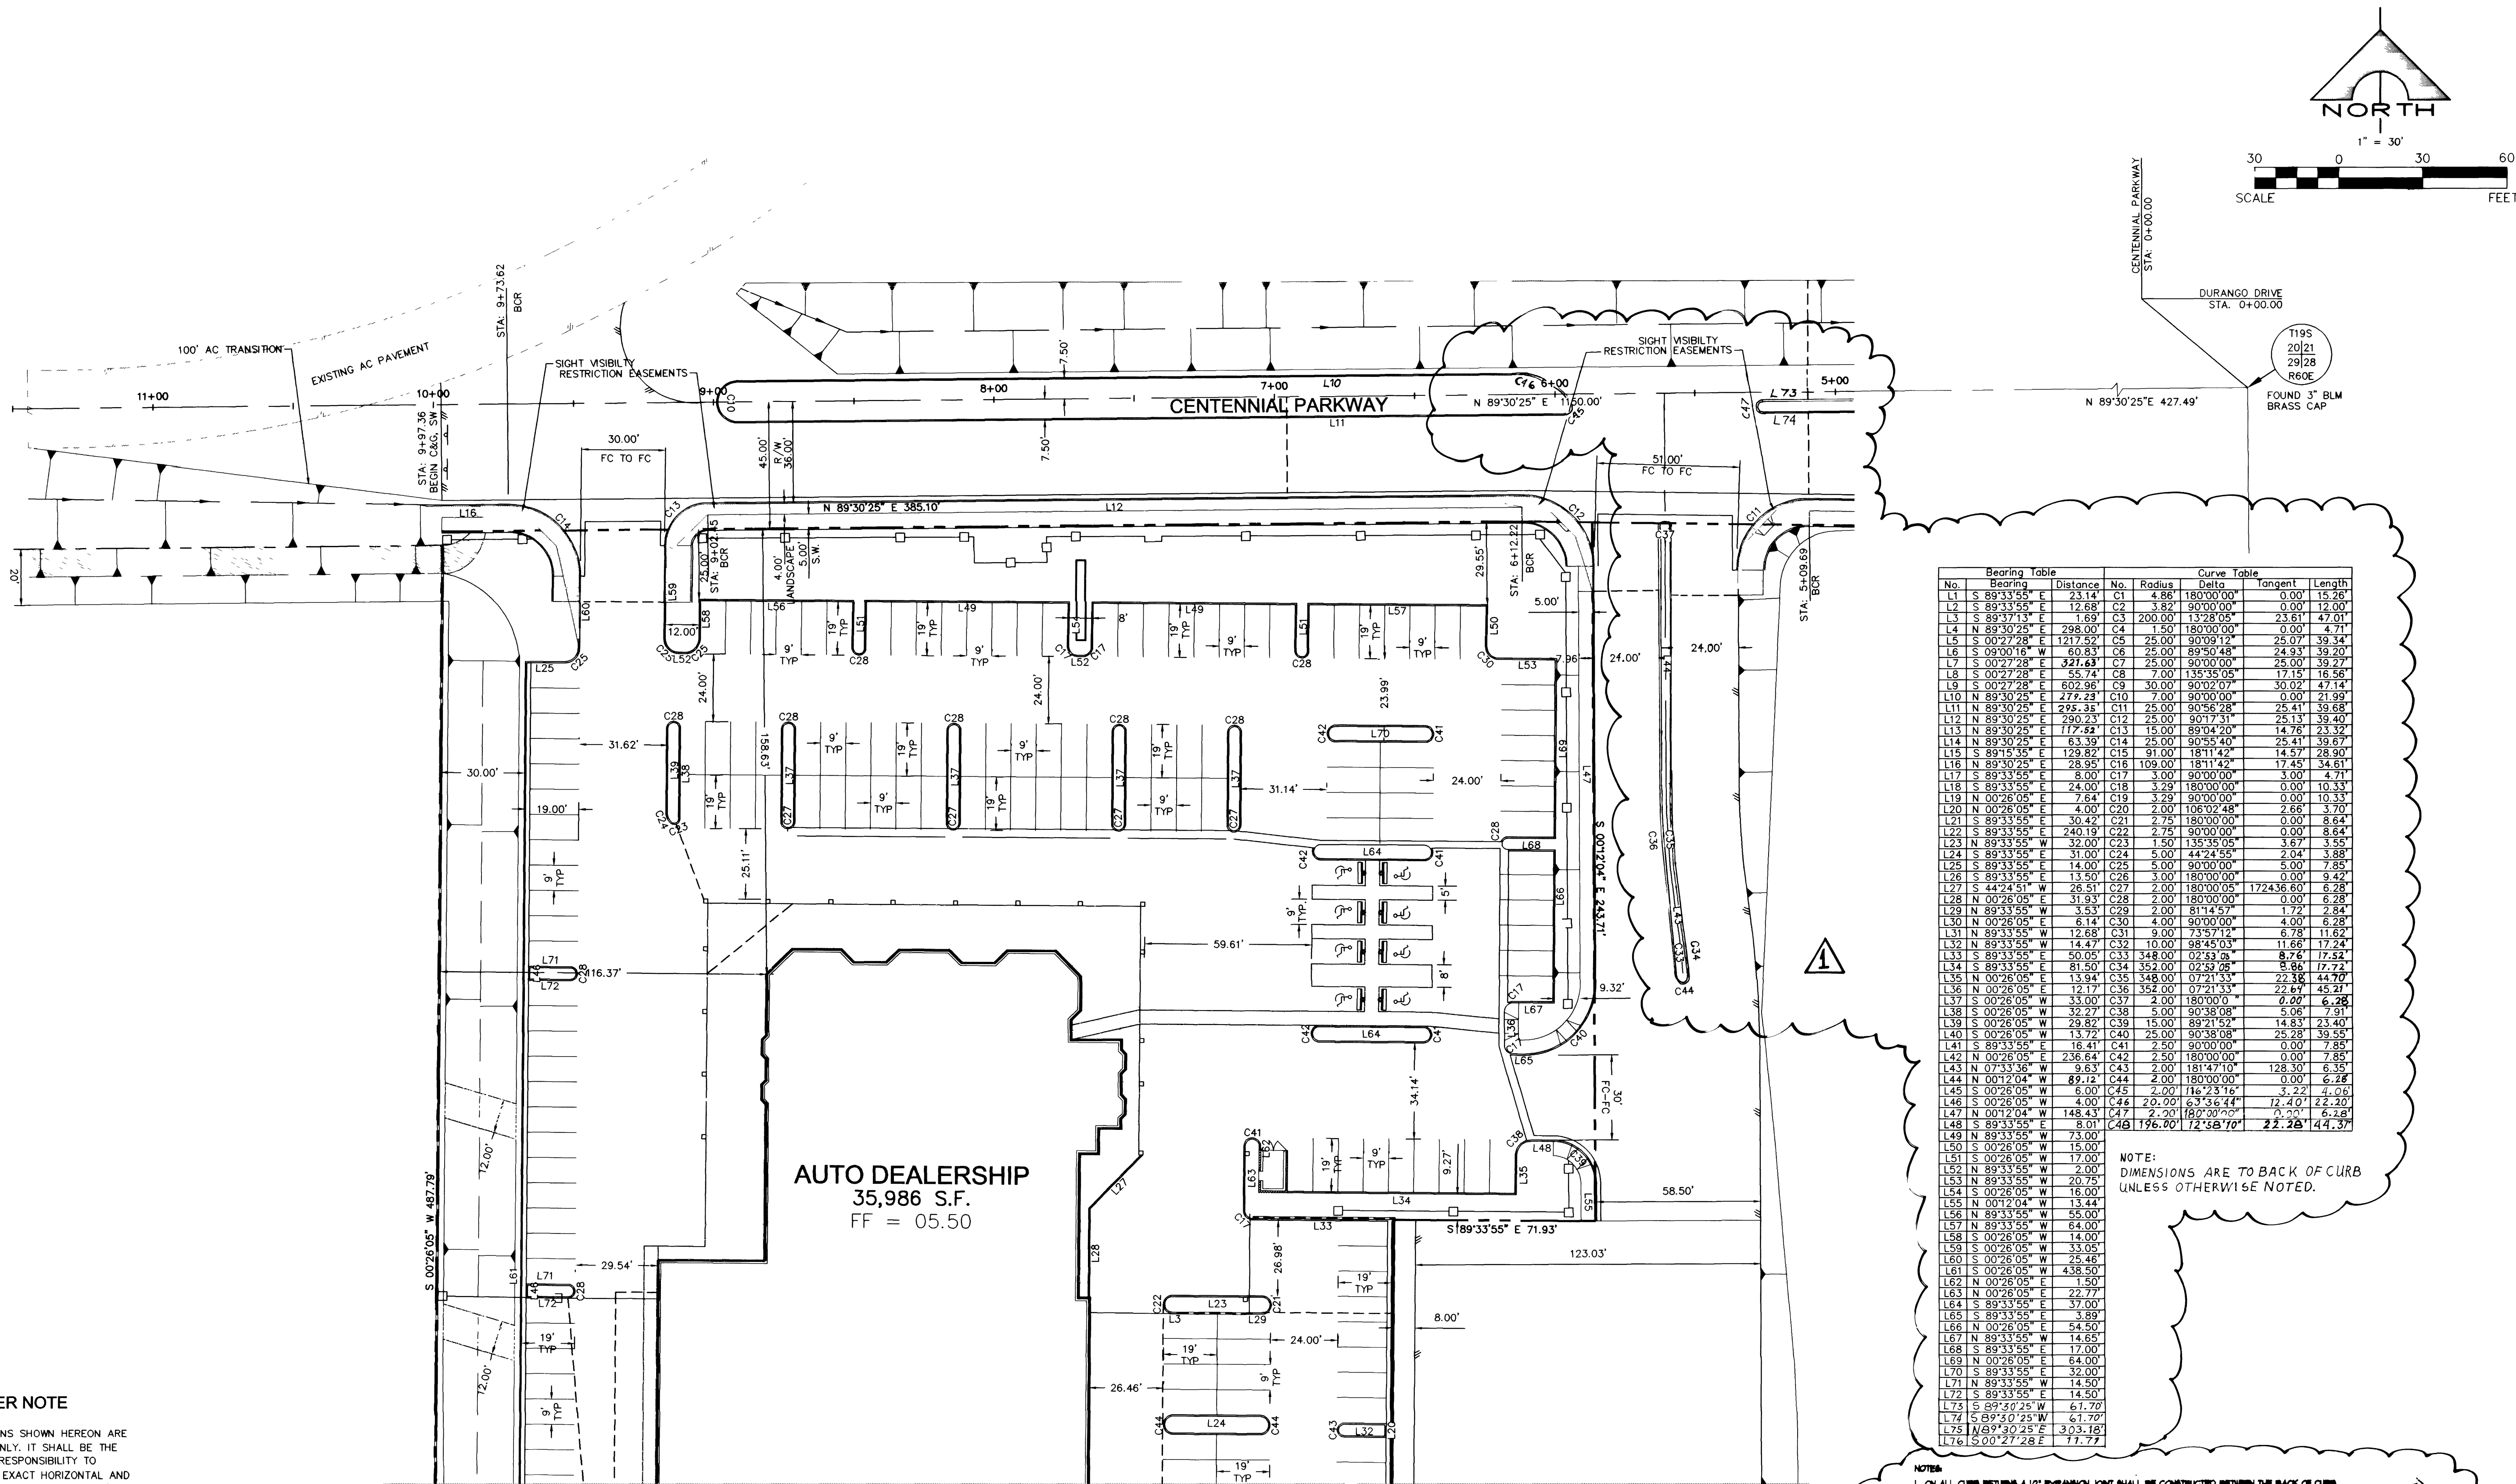
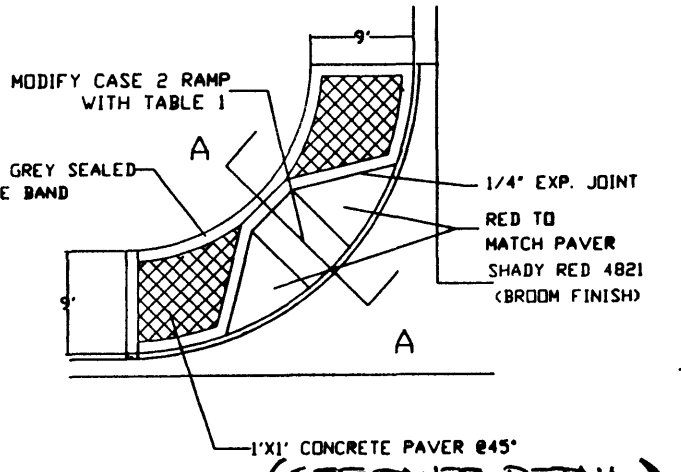


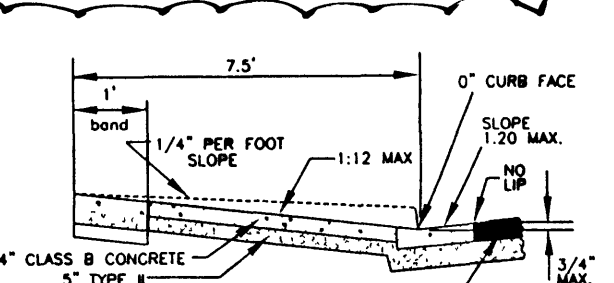

No.	Bearing	Distance	No.	Radius	Curve Table	Tangent	Length
L1	S 89°33'55" E	23.14	C1	4.86	180°00'00"	0.00	15.26
L2	S 89°33'55" E	12.68	C2	3.82	90°00'00"	0.00	12.00
L4	N 89°30'25" E	298.00	C4	1.50	180°00'00"	0.00	4.71
L5	S 00°27'28" E	1217.52	C5	25.00	90°09'12"	25.07	39.34
L6	S 09°00'18" W	60.83	C6	25.00	89°50'48"	24.93	39.20
L8	S 00°27'28" E	55.74	C8	7.00	135°35'05"	17.15	16.56
L9	S 00°27'28" E	602.96	C9	30.00	90°02'07"	30.02	47.14
L11	N 89°30'25" E	295.35	C11	25.00	90°58'28"	25.41	39.68
L12	N 89°30'25" E	290.23	C12	25.00	90°17'31"	25.13	39.40
L13	N 89°30'25" E	177.82	C13	15.00	89°04'20"	14.78	23.92
L14	N 89°30'25" E	63.39	C14	25.00	90°55'40"	25.41	39.68
L15	S 89°15'35" E	129.82	C15	91.00	181°14'42"	14.57	28.90
L16	N 89°30'25" E	28.95	C16	109.00	181°14'42"	17.45	34.61
L17	S 89°33'55" E	8.00	C17	3.00	90°00'00"	3.00	4.71
L18	S 89°33'55" E	24.00	C18	3.29	180°00'00"	0.00	10.33
L19	N 00°26'05" E	7.64	C19	3.29	90°00'00"	0.00	10.33
L20	N 00°26'05" E	4.00	C20	2.00	106°02'48"	2.66	3.70
L21	S 89°33'55" E	30.42	C21	2.75	180°00'00"	0.00	8.64
L22	S 89°33'55" E	240.19	C22	2.75	90°00'00"	0.00	8.64
L23	N 89°33'55" W	32.00	C23	1.50	135°35'05"	3.67	3.55
L24	S 89°33'55" E	31.00	C24	5.00	44°24'55"	2.04	3.88
L25	S 89°33'55" E	14.00	C25	5.00	90°00'00"	5.00	7.85
L26	S 89°33'55" E	13.50	C26	3.00	180°00'00"	0.00	9.42
L28	N 00°26'05" E	31.93	C28	2.00	180°00'00"	0.00	6.28
L29	N 89°33'55" W	3.53	C29	2.00	81°14'57"	1.72	2.84
L30	N 00°26'05" E	6.14	C30	4.00	90°00'00"	4.00	6.28
L31	N 89°33'55" W	12.68	C31	3.00	74°59'12"	6.78	11.62
L32	N 89°33'55" W	14.47	C32	10.00	98°45'03"	11.66	17.24
L49	N 89°33'55" W	73.00					
L50	N 00°26'05" W	15.00					
L51	S 00°26'05" W	17.00					
L52	N 89°33'55" W	2.00					
L53	N 89°33'55" W	20.75					
L54	S 00°26'05" W	16.00					
L55	N 00°26'05" W	13.44					
L56	N 89°33'55" W	55.00					
L57	N 89°33'55" W	64.00					
L58	N 00°26'05" W	14.00					
L59	N 00°26'05" W	33.05					
L60	S 00°26'05" W	25.46					
L61	N 00°26'05" W	438.50					
L62	N 00°26'05" W	1.50					
L63	N 00°26'05" E	22.77					
L64	S 89°33'55" E	37.00					
L65	S 89°33'55" E	3.89					
L66	N 00°26'05" E	54.50					
L67	N 89°33'55" W	14.65					
L68	S 89°33'55" E	17.00					
L69	N 00°26'05" E	64.00					
L70	S 89°33'55" E	32.00					
L71	N 89°33'55" W	14.50					
L72	S 89°33'55" E	14.50					
L73	S 89°30'25" W	61.70					
L74	S 89°30'25" W	61.70					
L75	N 89°30'25" E	303.18					
L76	S 00°27'28" E	17.77					

NOTE: DIMENSIONS ARE TO BACK OF CURB UNLESS OTHERWISE NOTED.

- NOTES:
- ON ALL CURBS RETURNING A 1/2" EXPANSION JOINT SHALL BE CONSTRUCTED BETWEEN THE BACK OF CURB AND THE SIDEWALK FOR THE ENTIRE LENGTH OF THE RETURN (V) SILICONE SEALANT AT SURFACE
 - THE TYPE II AGGREGATE BASE THICKNESS IS SHOWN ON THE TYPICAL SECTION DRAWING
 - LONGITUDINAL WEARABLE PLANE JOINT (CONTROL JOINT) REQUIRED AT MIDPOINT OF SIDEWALK W/ OR W/O B&B
 - BAND DRUM ALL JOINTS - JOINTS BETWEEN PAVEMENTS NOT TO EXCEED 1/4"
 - SEE DETAIL R 148 SHEET FOR PLAN VIEW OF PAVEMENT CONFIGURATION

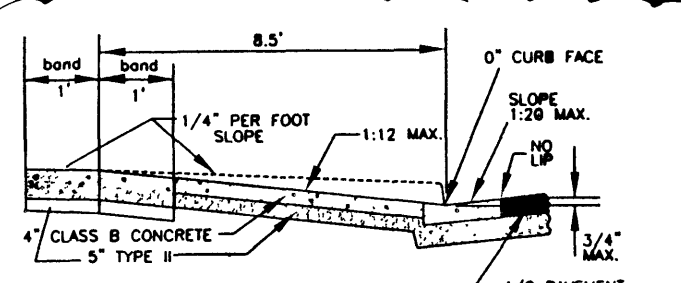

9 TYPICAL PAVEMENT DETAIL - FOR THIS PROJECT

BASIS OF BEARING

N 89°30'25" E
BEING THE NORTH LINE OF SECTION 29,
T 19 S, R 60 E, M.D.M., AS SHOWN ON
RECORD OF SURVEY MAP FILE 89, PAGE 3.

BENCHMARK

CCVC 109029E4
RIVET AND SQUARE ALUMINUM PLATE IN A CONCRETE
MONUMENT, 30 FEET NORTH AND 50 FEET WEST OF
DURANGO DRIVE AND TROPICAL PARKWAY
753.221 METERS
OR 2471.19 FEET, N.A.V.D. 88

NOTE:
"OWNER RESPONSIBLE TO PROVIDE SURVEY MONUMENTATION AS
SHOWN AND TO REPLACE ALL SURVEY MONUMENTATION DAMAGED,
DISTURBED, DESTROYED OR OBSERVED DURING CONSTRUCTION."

TETRA
Southwest

309 W. Lake Mead Dr. • Henderson, Nevada 89015
Phone: (702) 567-1820 • Fax: (702) 567-1821

JIM MARSH
AUTOMOBILE DEALERSHIP
CENTENNIAL PKWY. & DURANGO DR.
HORIZONTAL CONTROL PLAN

REVISIONS

NO.	DATE	BY	DESCRIPTION
1	10/1/2000	J.M.	REVISED MEDIAN CONFIGURATION
2	10/1/2000	J.M.	REVISED MEDIAN CONFIGURATION
SCALE (H) 1"=30'

SCALE (V) 1"=30'