
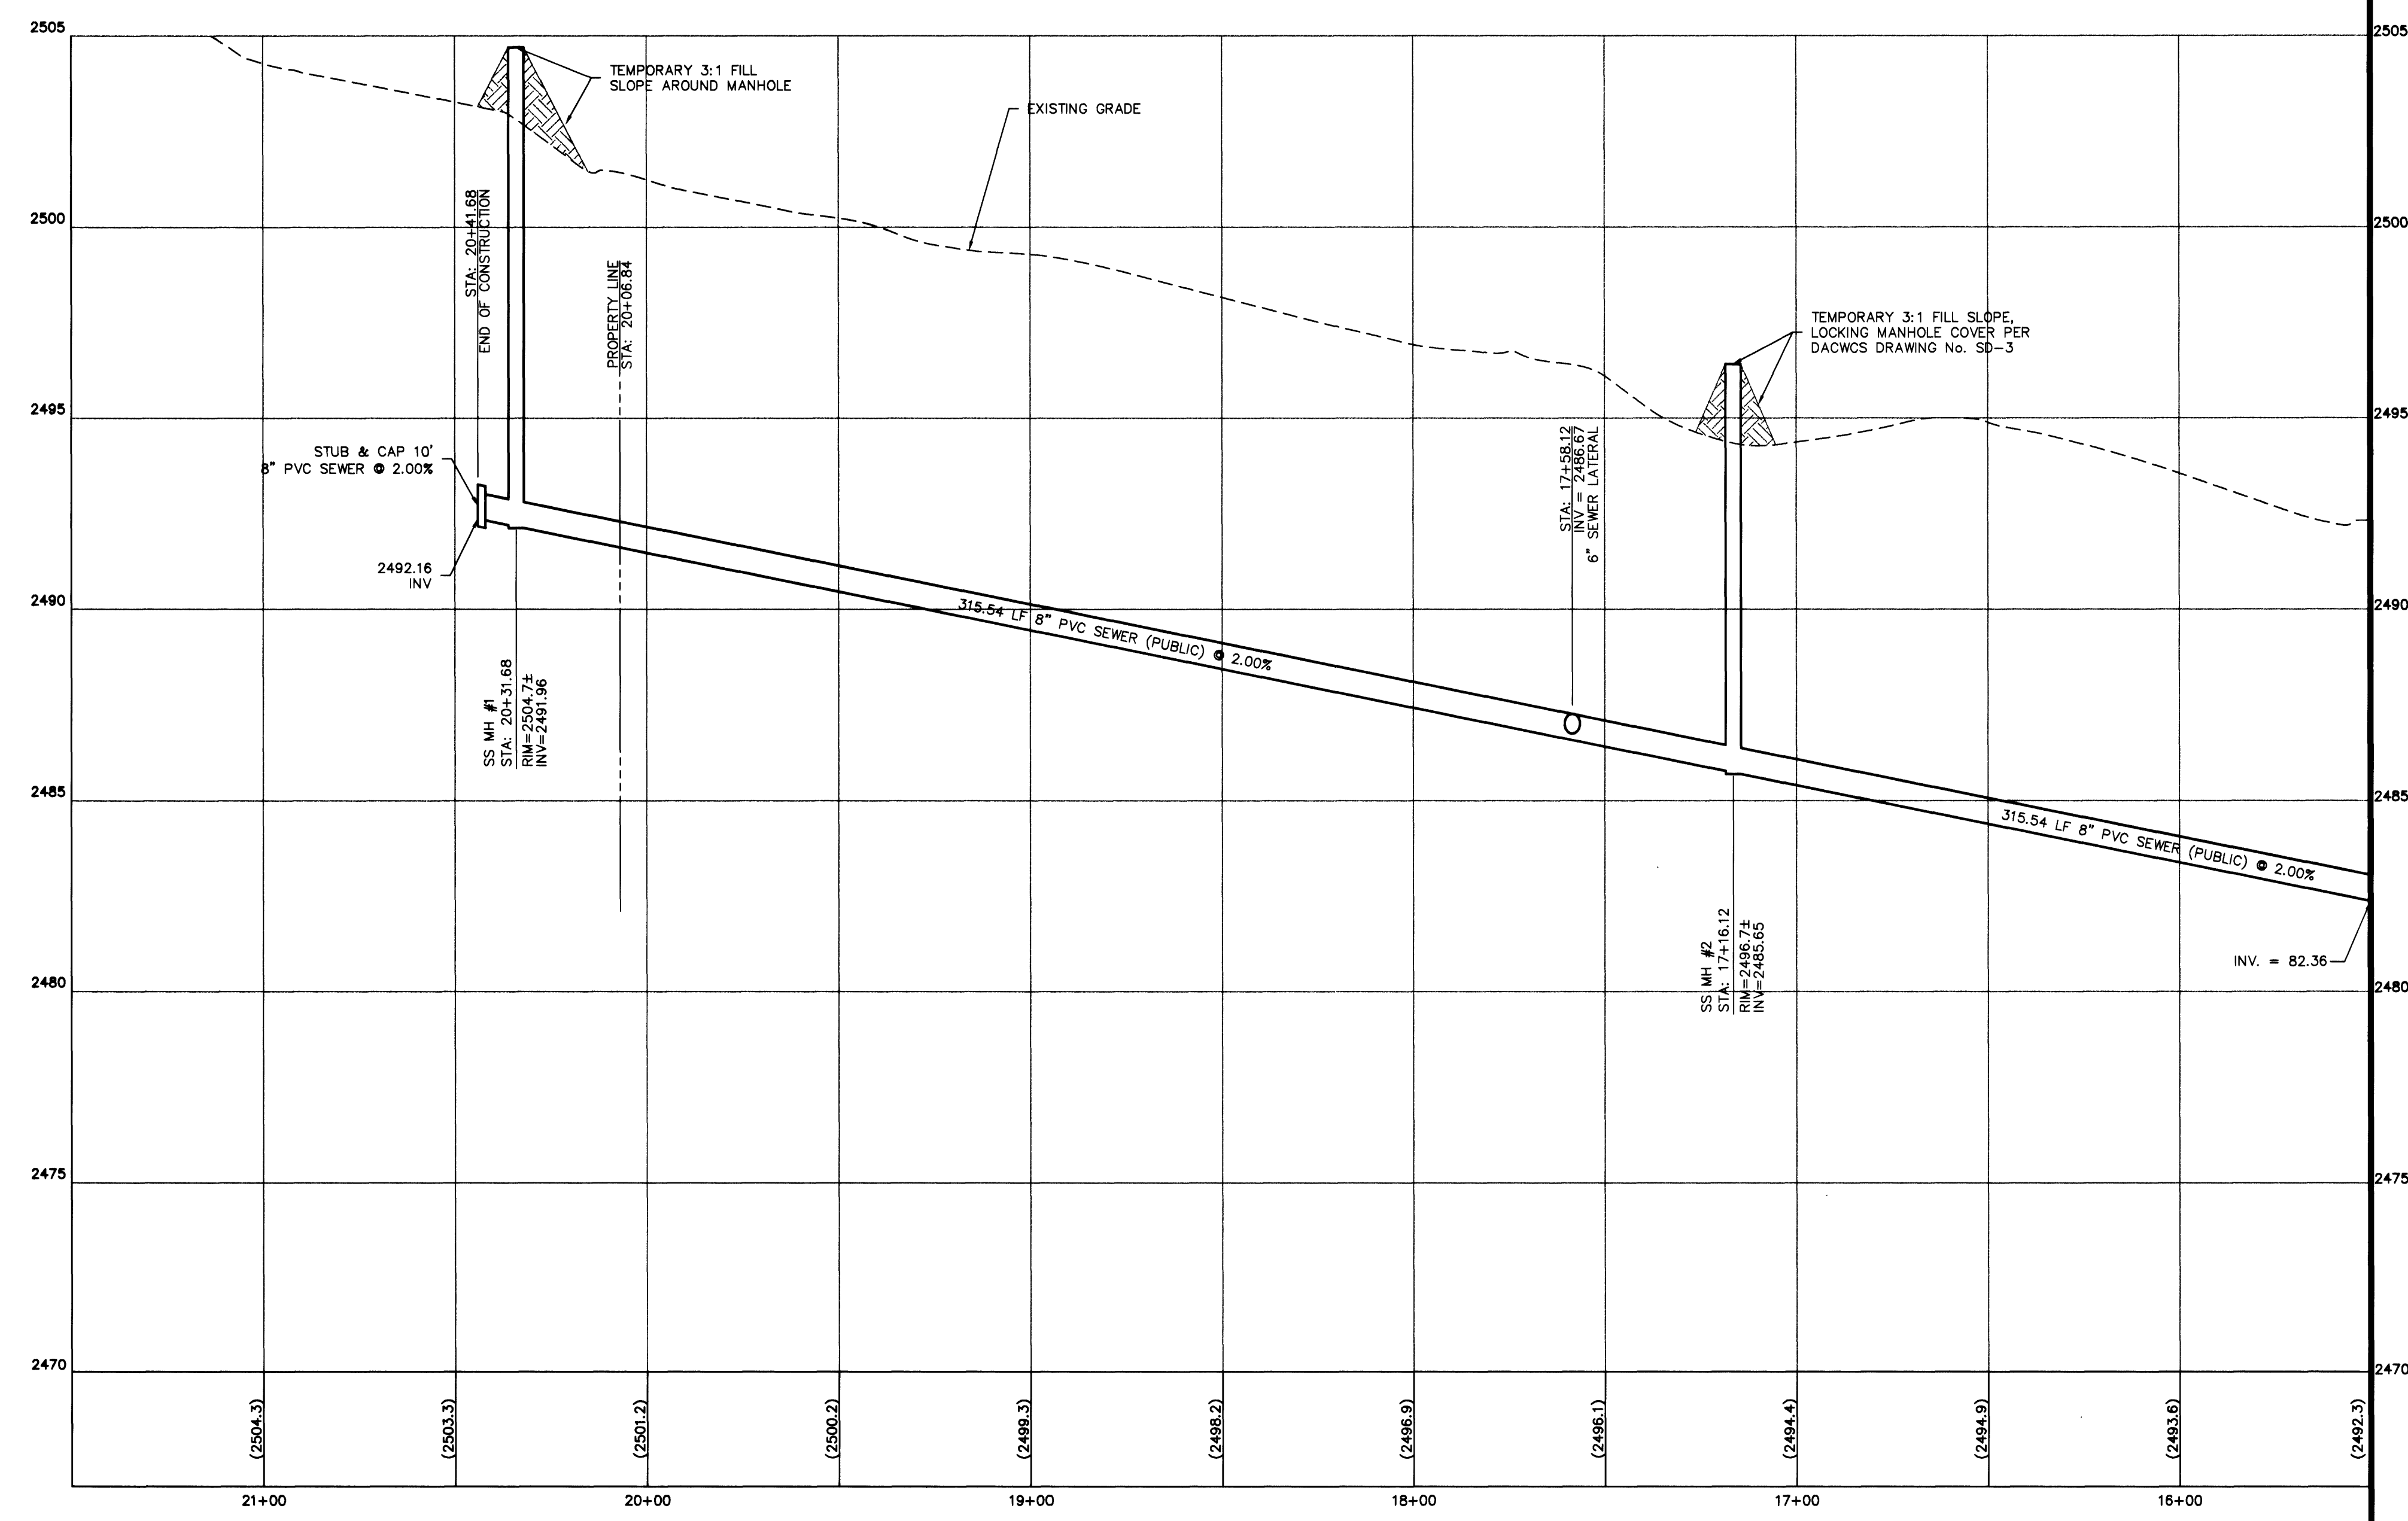
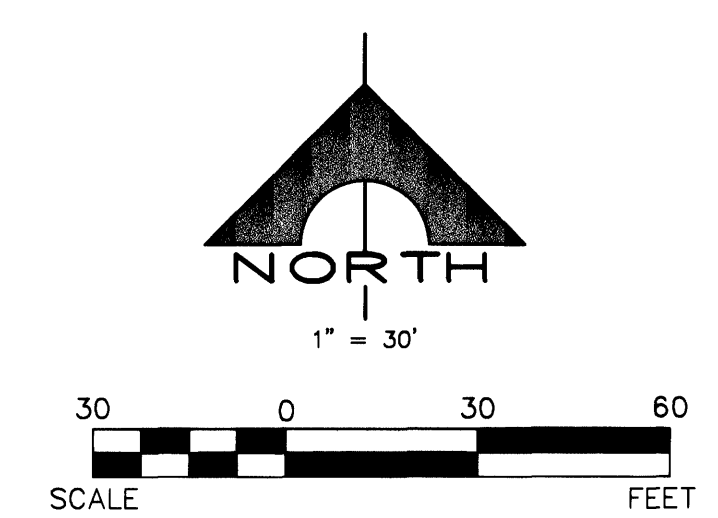


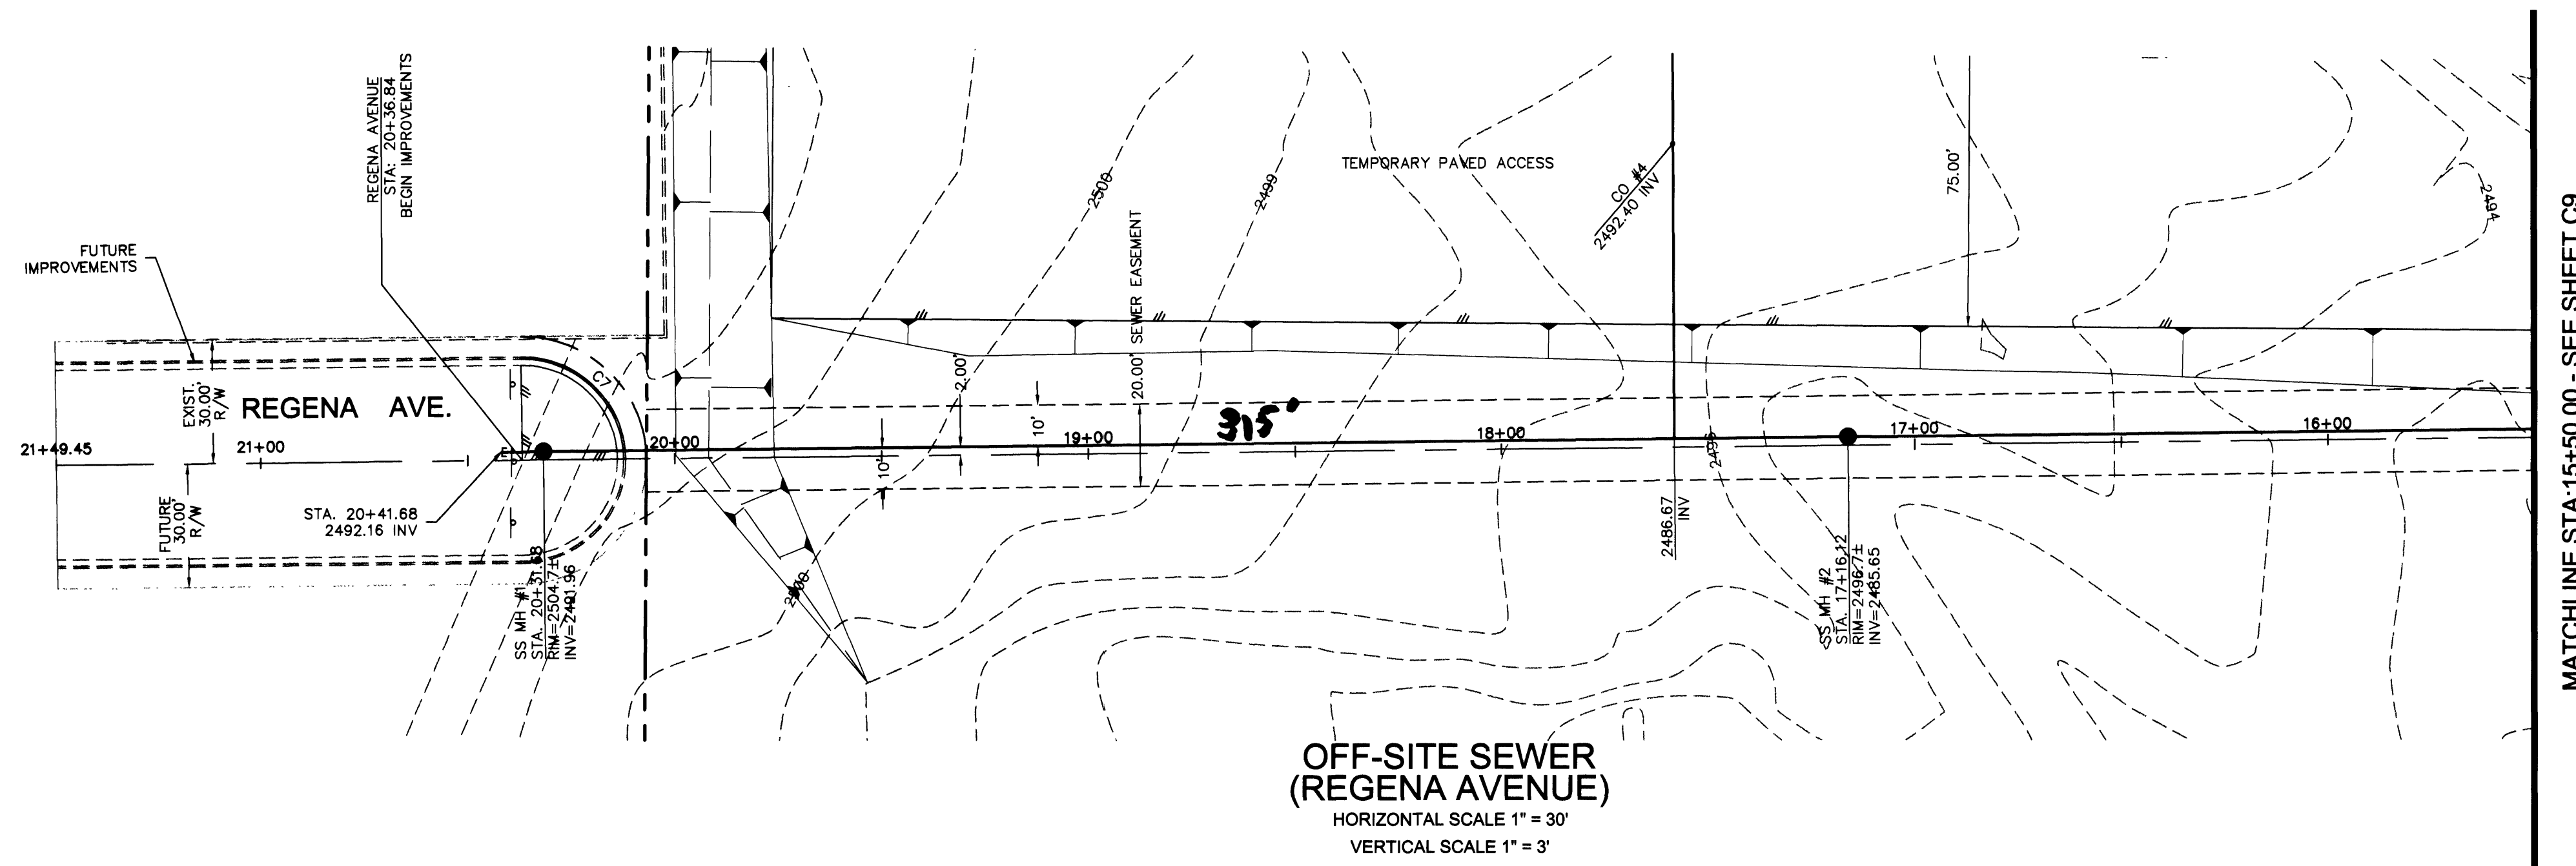

NOTE:
OWNER RESPONSIBLE TO PROVIDE SURVEY MONUMENTATION AS SHOWN AND TO REPLACE ALL SURVEY MONUMENTATION DAMAGED, DISTURBED, DESTROYED OR OBSOBEURED DURING CONSTRUCTION.

BASIS OF BEARING
N 89°30'25" E
BEING THE NORTH LINE OF SECTION 29,
T. 19 S., R. 60 E., M.D.M., AS SHOWN ON
RECORD OF SURVEY MAP FILE 89, PAGE 3.

BENCHMARK
CGVC 1C9029E4
RIVET AND SQUARE ALUMINUM PLATE IN A CONCRETE
MONUMENT, 30 FEET NORTH AND 50 FEET WEST OF
DURANGO DRIVE AND TROPICAL PARKWAY
753.221 METERS
OR 2471.19 FEET. N.A.V.D. 88

DISCLAIMER NOTE
UTILITY LOCATIONS SHOWN HEREON ARE
APPROXIMATE ONLY. IT SHALL BE THE
CONTRACTOR'S RESPONSIBILITY TO
DETERMINE THE EXACT HORIZONTAL AND
VERTICAL LOCATION OF ALL EXISTING
UNDERGROUND AND OVERHEAD UTILITIES
PRIOR TO COMMENCING CONSTRUCTION.
NO REPRESENTATION IS MADE THAT ALL
EXISTING UTILITIES ARE SHOWN HEREON.
THE ENGINEER ASSUMES NO
RESPONSIBILITY FOR UTILITIES NOT
SHOWN OR UTILITIES NOT SHOWN IN
THEIR PROPER LOCATION.
DESIGN CHANGES REQUIRED
FOR FINAL CONSTRUCTION SHALL
BE APPROVED BY ENGINEER IN
WRITING PRIOR TO CONSTRUCTION.



 TETRA Southwest 309 W. Lake Mead Dr. • Henderson, Nevada 89015 Phone: (702) 567-1820 • Fax: (702) 567-1821		SCALE (H) 1" = 30' SCALE (V) 1" = 3' DESIGN BY J.H.B. DRAWN BY J.A.S.	REV. # BY DATE DESCRIPTION APPROVAL
JIM MARSH AUTO DEALERSHIP SANITARY SEWER (REGENA AVENUE) STA: 15+50.00 - 21+50.00 PLAN & PROFILE		PROFESSIONAL ENGINEER STATE OF NEVADA RODNEY M. MILLS CIVIL No. 14149 ENGINEER'S SEAL	
SHEET C10 10 OF 19 SHEETS JOB# 99031 167-V3292			