AVOID CUTTING UNDERGROUND UTILITY LINES, IT'S COSTLY!

CALL BEFORE YOU DIG

1-800-227-2600

UNDERGROUND SERVICE ALERT (USA)

AVOID OVERHEAD POWERLINE CONTACT

CALL BEFORE YOU OVERHEAD

1-702-593-6111

NEVADA POWER ENVIRONMENT AND SAFETY SERVICES DEPARTMENT

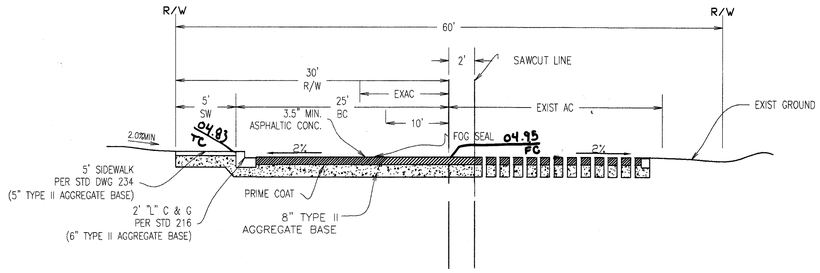

EUGENE AVENUE
PER STD. DWG. 205
0+52.54 TO 2+13.17
(PUBLIC)

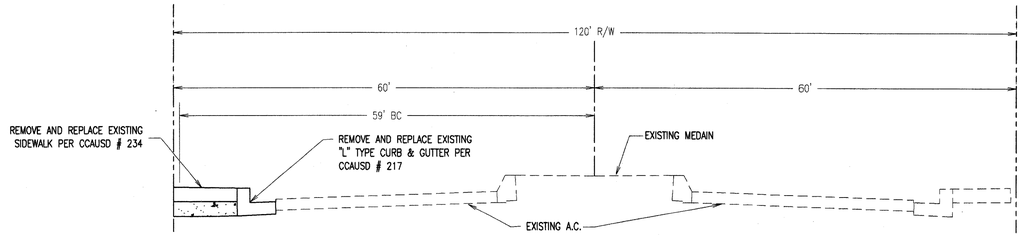

DECATUR BLVD

BASIS OF BEARING
SOUTH 01°10'48" WEST
BEING THE CENTERLINE OF DECATUR BLVD AS SHOWN ON MAP RECORDED IN BOOK 6 OF PLATS, PAGE 11, CLARK COUNTY NEVADA RECORDS

BENCHMARK
CITY OF LAS VEGAS BENCHMARK #
19NWW6. A RIVET AND PLATE LOCATED IN THE TOP OF CURB AT THE NE CORNER OF EUGENE AND DECATUR BLVD.

ELEVATION:

671.355 METERS (NAVD 88)
2202.61 FEET (NAVD 88)

PROFESSIONAL ENGINEER STATE OF NEVADA
JAMES P. LOPEZ
Exp 12/31/05
CIVIL
No. 14935
2/17/04

JPL ENGINEERING INC.
8620 SOUTH EASTERN AVE. SUITE 8
LAS VEGAS, NV 89123
Phone (702) 898-6269 • Fax (702) 896-0647

REV.	DATE	DESCRIPTION	DATE	APPROVAL

KAMRAN RETAIL

TYPICAL SECTIONS

05 FEB 04

12/31/05

2/17/04

JOB # J03011

SHEET NO.:

S2

8 OF 10 SHEETS

CLV DWG # 107V3968

66292