


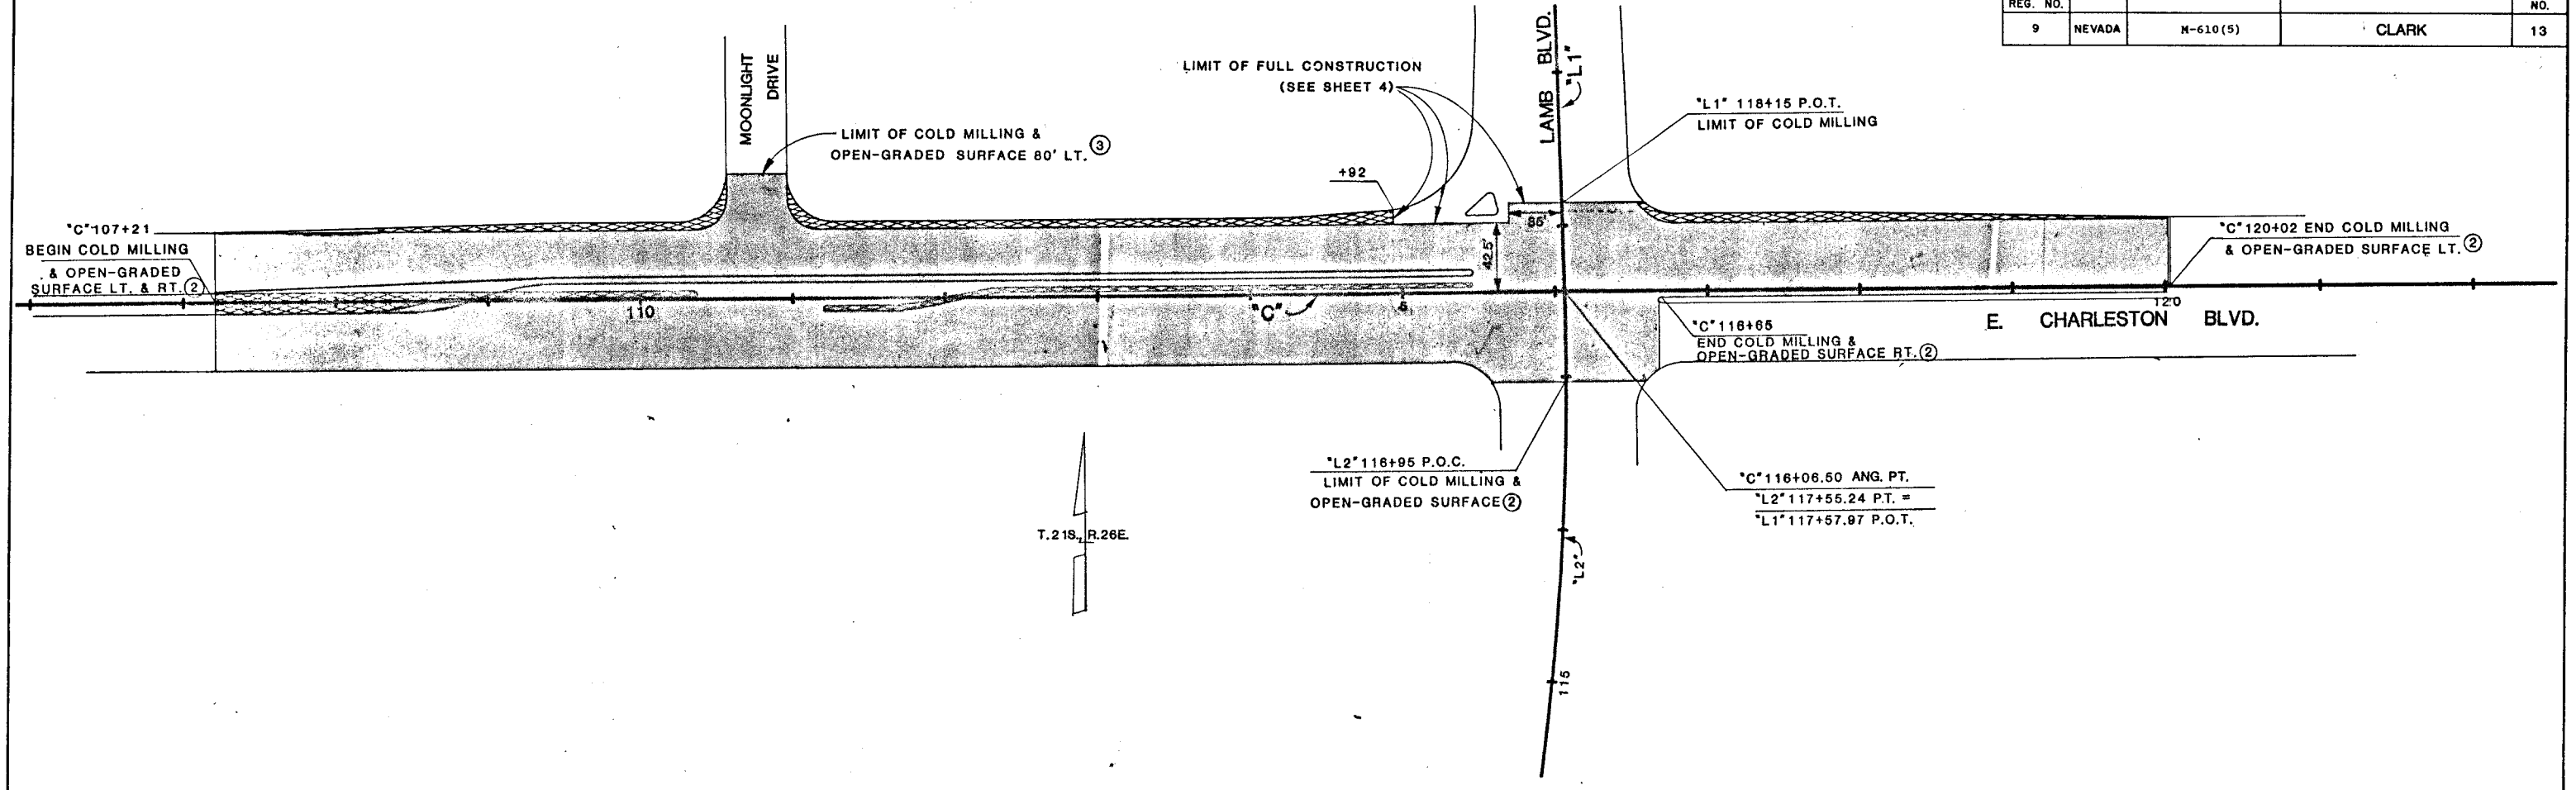

FED. RD. REG. NO.	STATE	PROJECT NO.	COUNTY	SHEET NO.
9	NEVADA	M-610(5)	CLARK	13



LEGEND


-  LIMITS OF PLANTMIX PATCH ④
  -  LIMITS OF 1" DEPTH COLD MILLING
- Deleted by C.O #16*

GENERAL NOTES:

- ① FOR SECTION OF IMPROVEMENT, SEE SHEETS 2 AND 2A
- ② FINISHED GRADE OF PLANTMIX BITUMINOUS OPEN-GRADED SURFACE TO MATCH EXISTING SURFACE.
- ③ FINISHED GRADE OF PLANTMIX BITUMINOUS SURFACE TO MATCH EXISTING SURFACE.
- ④ PLANTMIX PATCH IS INCLUDED IN PAY ITEM "PLANTMIXING MISCELLANEOUS AREAS."

66923

107V3989

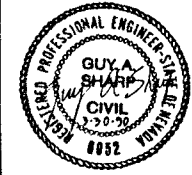	STATE OF NEVADA DEPARTMENT OF TRANSPORTATION
	<b>LIMITS OF COLD MILLING</b> <b>E. CHARLESTON BLVD.</b>
JOB NO. 990-02-2 DESIGNED G.S. DRAWN C.H.W. CHECKED <i>[Signature]</i> DATE 3-30-90	