


FED. RD. REG. NO.	STATE	PROJECT NO.	COUNTY	SHEET NO.
9	NEVADA	M-610(5)	CLARK	T-10

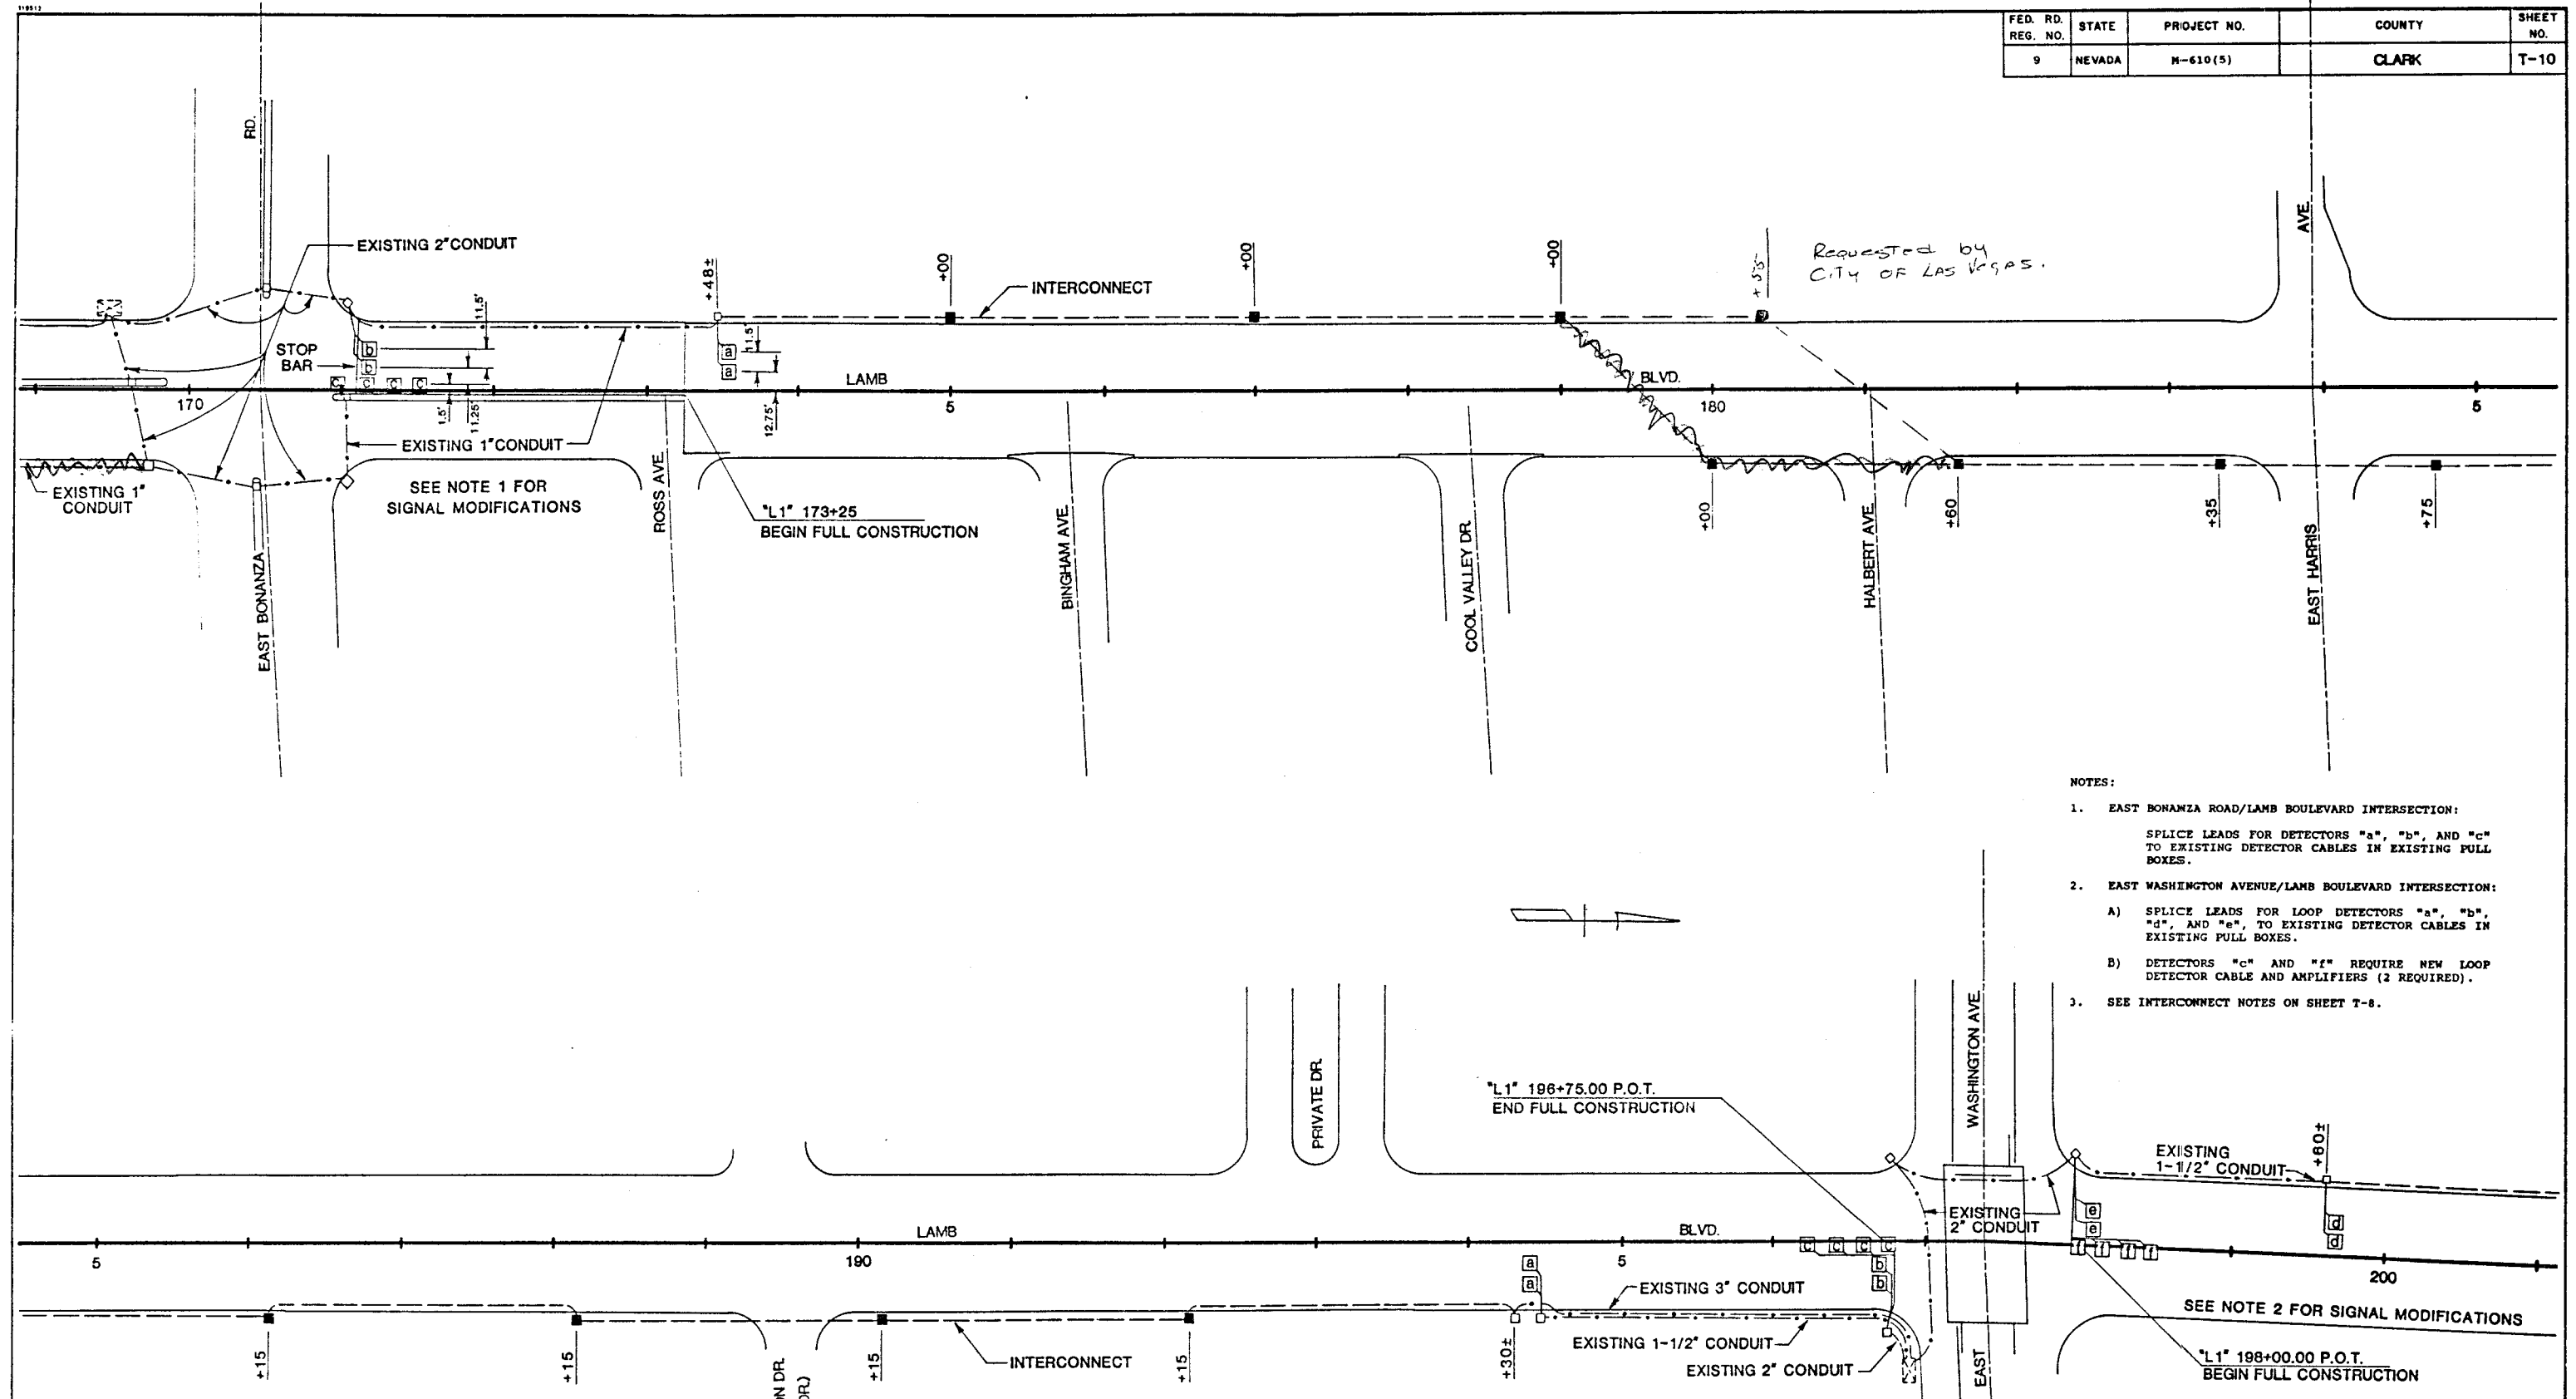

- NOTES:
- EAST BONANZA ROAD/LAMB BOULEVARD INTERSECTION:
SPlice LEADS FOR DETECTORS "a", "b", AND "c" TO EXISTING DETECTOR CABLES IN EXISTING PULL BOXES.
 - EAST WASHINGTON AVENUE/LAMB BOULEVARD INTERSECTION:
A) SPlice LEADS FOR LOOP DETECTORS "a", "b", "d", AND "e", TO EXISTING DETECTOR CABLES IN EXISTING PULL BOXES.
B) DETECTORS "c" AND "f" REQUIRE NEW LOOP DETECTOR CABLE AND AMPLIFIERS (2 REQUIRED).
 - SEE INTERCONNECT NOTES ON SHEET T-8.

66979

	RENO, SPARKS, NEVADA LAS VEGAS, NEVADA PHOENIX, ARIZONA	STATE OF NEVADA DEPARTMENT OF TRANSPORTATION SIGNAL INTERCONNECT CABLE - SIGNAL MODIFICATION 107V3989 LAMB BOULEVARD
	JOB NO. 990-02-2 DESIGNED F.G.A. II DRAWN C.H.W. CHECKED M.E. DATE 3-30-90	