



FED. RD. REG. NO.	STATE	PROJECT NO.	COUNTY	SHEET NO.
9	NEVADA	M-610(5)	CLARK	T-9

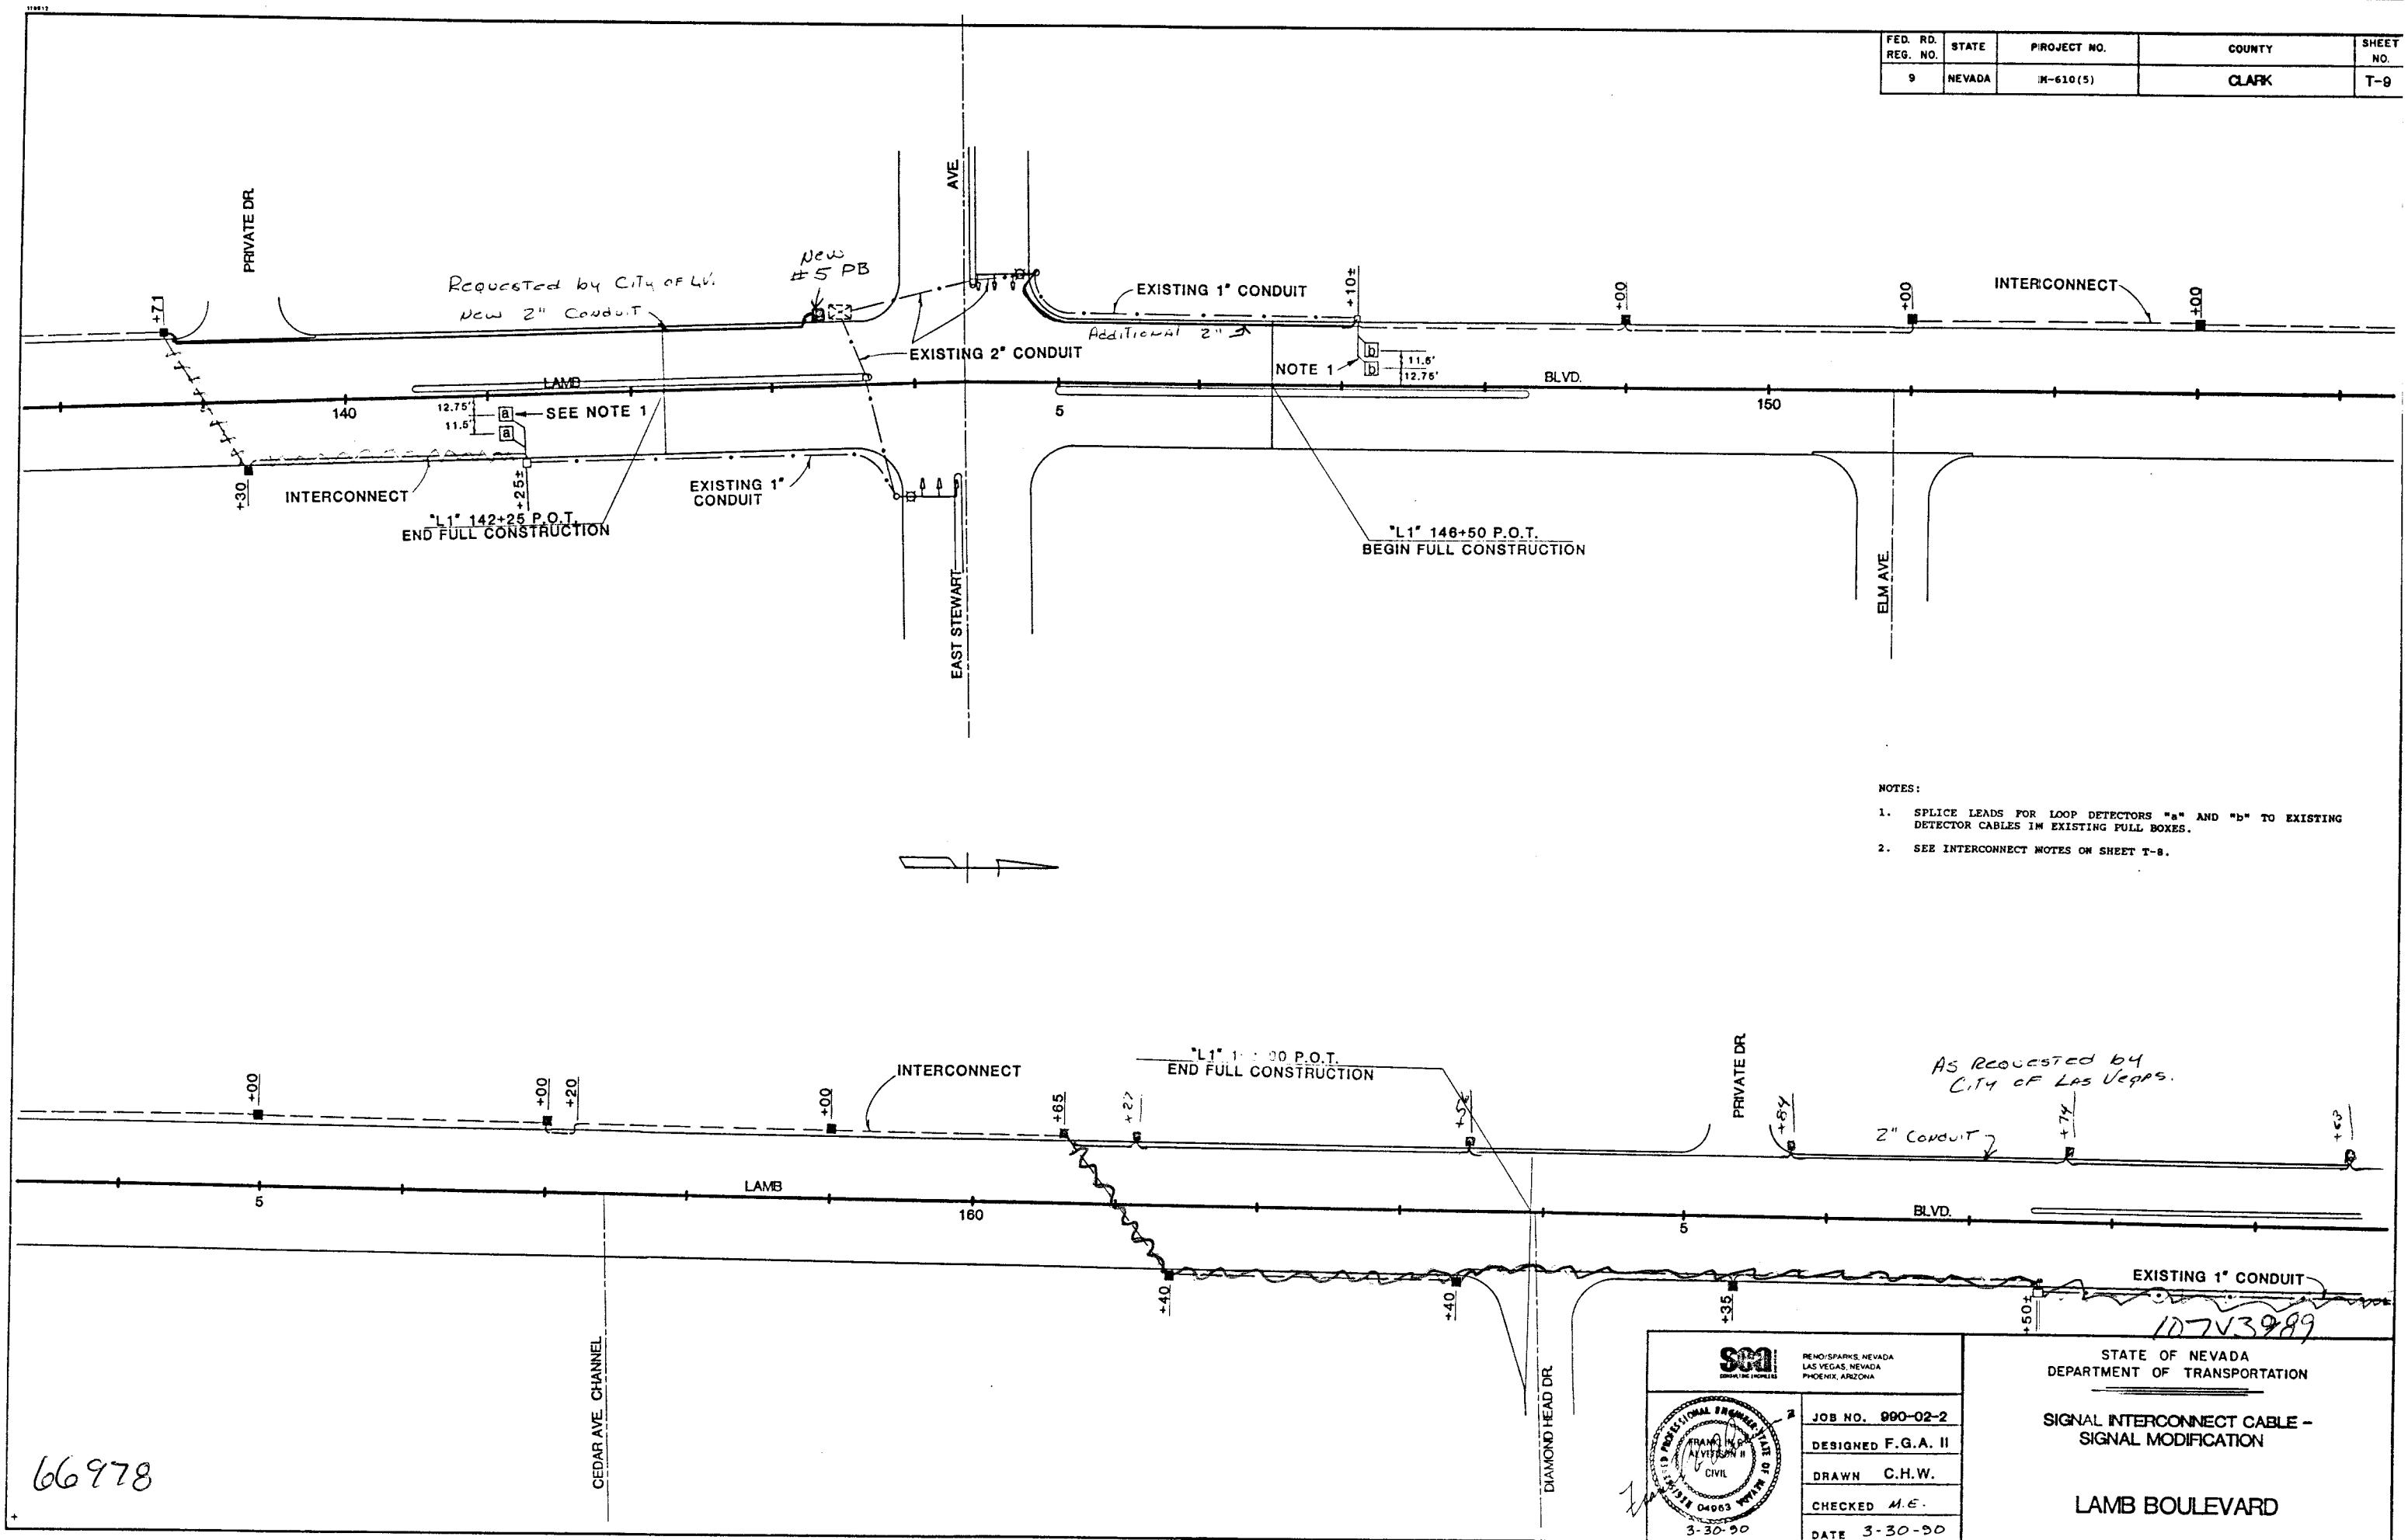

- NOTES:
1. SPLICE LEADS FOR LOOP DETECTORS "a" AND "b" TO EXISTING DETECTOR CABLES IN EXISTING FULL BOXES.
 2. SEE INTERCONNECT NOTES ON SHEET T-8.

66978

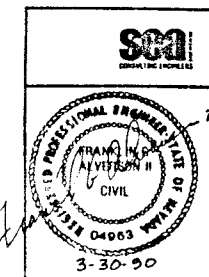

RENO/SPIRKE, NEVADA
LAS VEGAS, NEVADA
PHOENIX, ARIZONA

JOB NO. 990-02-2
DESIGNED F.G.A. II
DRAWN C.H.W.
CHECKED M.E.
DATE 3-30-90

107V3989

STATE OF NEVADA
DEPARTMENT OF TRANSPORTATION

SIGNAL INTERCONNECT CABLE -
SIGNAL MODIFICATION

LAMB BOULEVARD