



SECTION
SPECIAL DROP INLET

*L1" 129+16 LT.

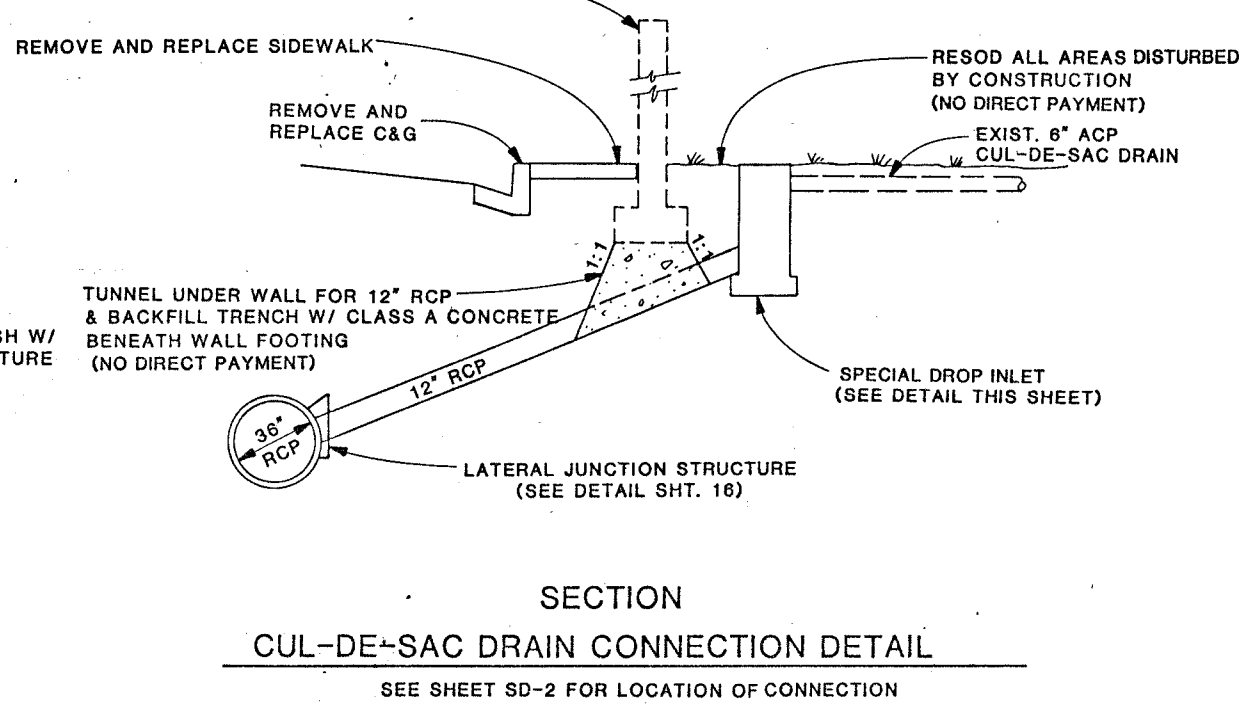


SECTION
CUL-DE-SAC DRAIN CONNECTION DETAIL

SEE SHEET SD-2 FOR LOCATION OF CONNECTION

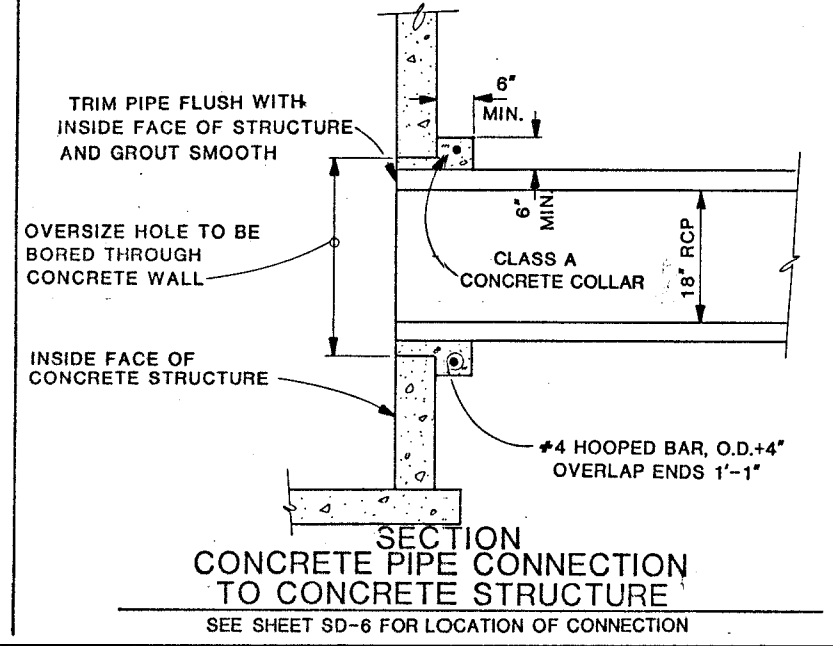

SECTION
CONCRETE PIPE CONNECTION TO CONCRETE STRUCTURE


SEE SHEET SD-6 FOR LOCATION OF CONNECTION

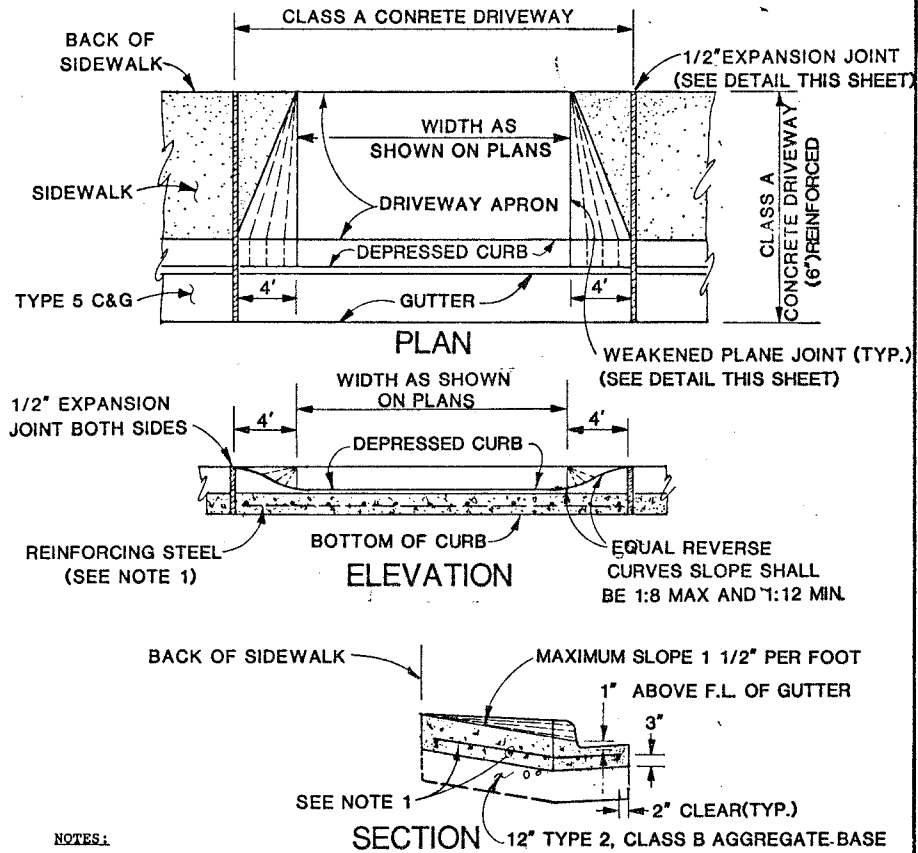

SECTION 12\"/>

- NOTES:
- NO. 4 BARS AT 16" OC BOTH WAYS EXTENDING INTO GUTTER NO. 4 BARS SHALL BE PLACED 3" ABOVE BOTTOM OF CONCRETE SUPPORTED BY NONFERROUS CHAIRS APPROVED BY THE DEPARTMENT.
 - WHEN CONSTRUCTING DRIVEWAY WHERE CURB AND GUTTER EXISTS, COMPLETELY REMOVE INTERFERING PORTIONS OF EXISTING CURB AND GUTTER. DRIVEWAY SHALL BE MONOLITHIC TO A.C. LINE.
 - CONCRETE SHALL BE CLASS A.
 - REINFORCING STEEL IS INCLUDED IN THE BID ITEM "CLASS A CONCRETE DRIVEWAY (6") REINFORCED".
 - WEAKENED PLANE JOINTS SHALL BE EQUALLY SPACED AT 15' MAX. INTERVALS, SEE DWG. NO. 234.


66931 COMMERCIAL DRIVEWAY

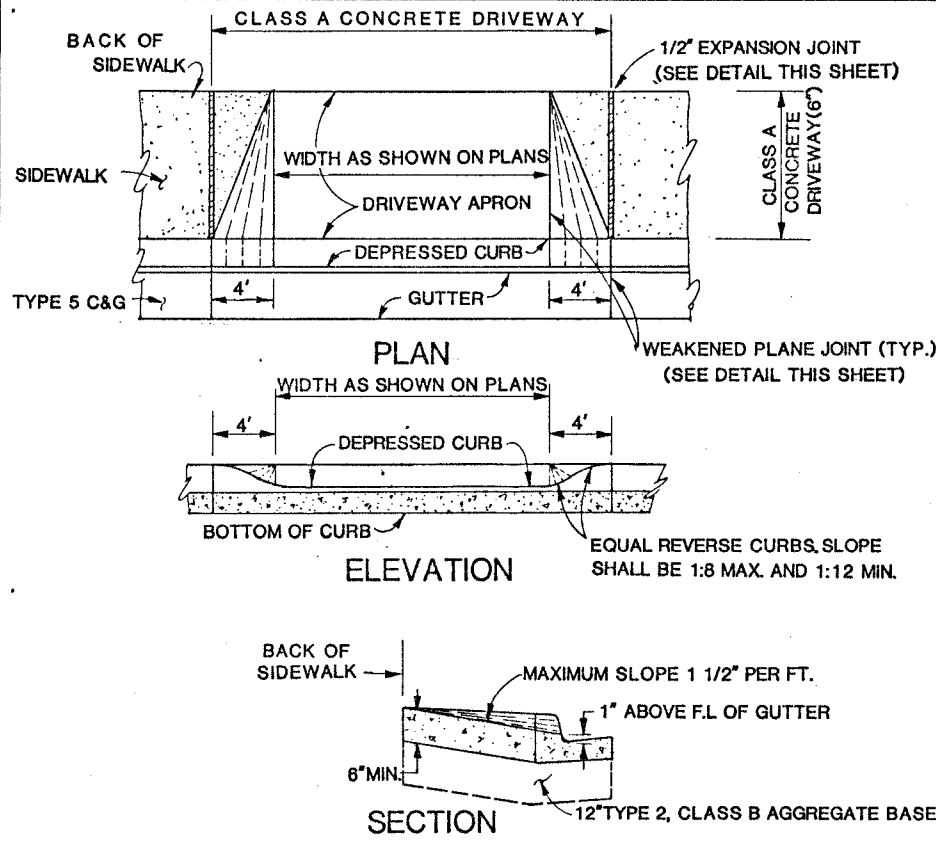

SECTION 12\"/>


- NOTES:
- WHEN CONSTRUCTING DRIVEWAY WHERE CURB AND GUTTER EXISTS, COMPLETELY REMOVE INTERFERING PORTIONS OF EXISTING CURB AND GUTTER. DRIVEWAY MAY BE MONOLITHIC TO A.C. LINE.
 - CONCRETE SHALL BE CLASS A.
 - WEAKENED PLANE JOINTS SHALL BE UNIFORMLY PLACED BETWEEN 5' AND 7' INTERVALS.

RESIDENTIAL DRIVEWAY

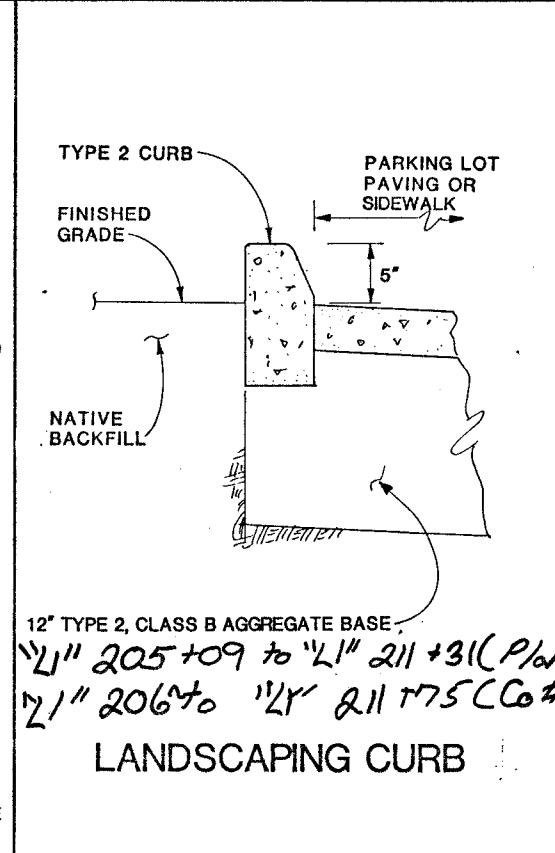

12" TYPE 2, CLASS B AGGREGATE BASE

LANDSCAPING CURB

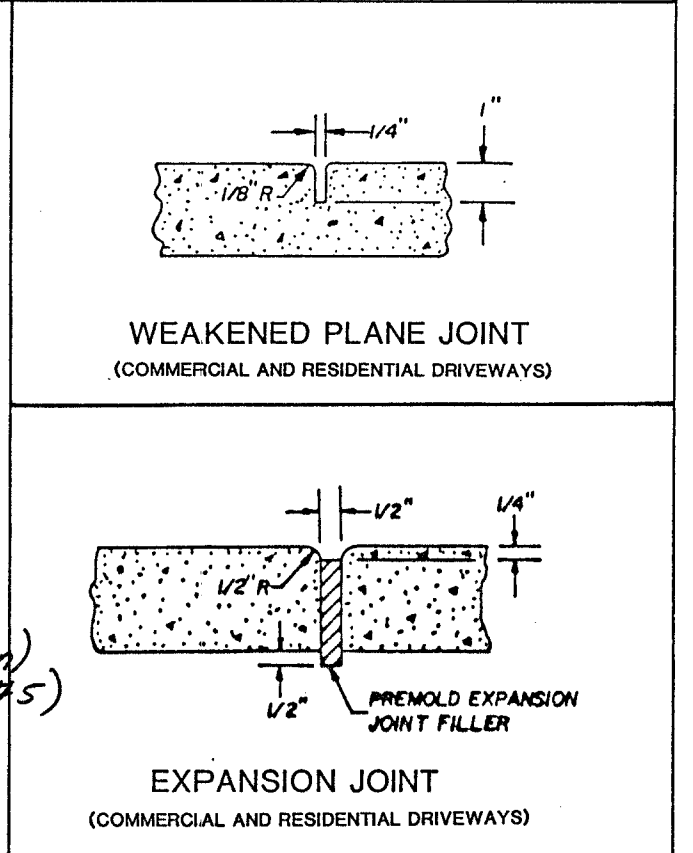

WEAKENED PLANE JOINT
(COMMERCIAL AND RESIDENTIAL DRIVEWAYS)

EXPANSION JOINT
(COMMERCIAL AND RESIDENTIAL DRIVEWAYS)

REN0 SPARKS, NEVADA
 LAS VEGAS, NEVADA
 PHOENIX, ARIZONA

DESIGNED G.S.
 DRAWN J.H.
 CHECKED J.K.
 DATE 3-30-90

STATE OF NEVADA
 DEPARTMENT OF TRANSPORTATION

SPECIAL DETAILS
 107V3989