

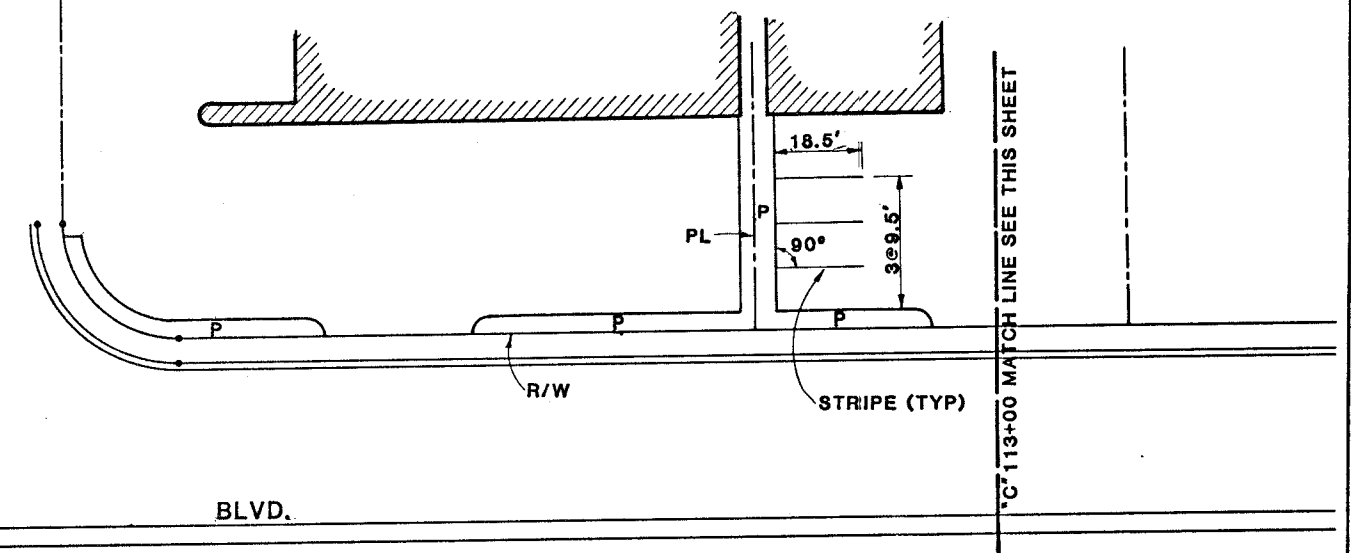


FED. RD. REG. NO.	STATE	PROJECT NO.	COUNTY	SHEET NO.
9	NEVADA	M-610(5)	CLARK	ST-6

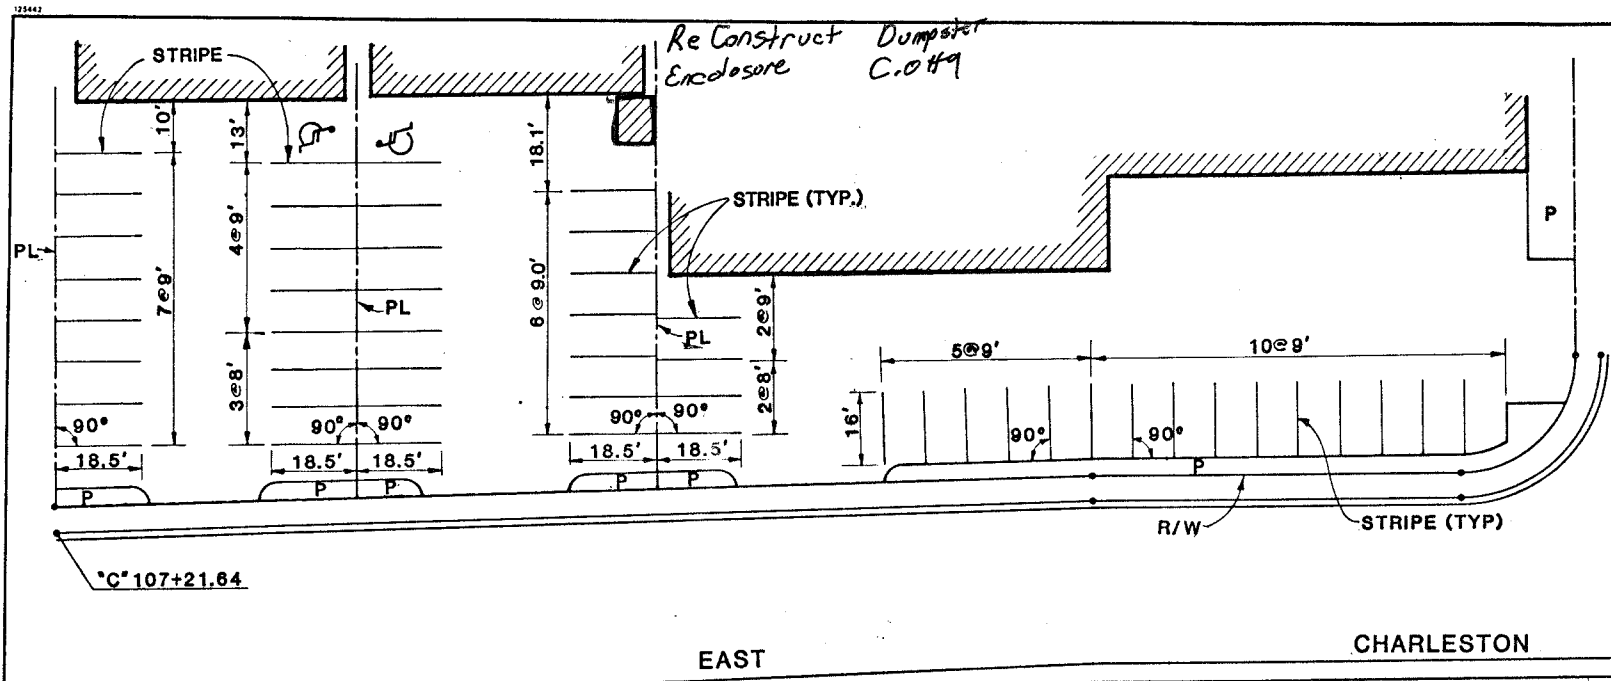


- GENERAL NOTES:
1. ALL STRIPING SHALL BE SOLID WHITE, PAINT.
 2. EXISTING STRIPING SHALL BE REMOVED WHERE NEW STRIPING DOES NOT OVERLAP EXISTING STRIPING.
 3. FOR STREET AND OFFSITE IMPROVEMENT PLANS SEE SHEETS 4, 12, 14, 22, 23 AND 24.

LEGEND:
P PLANTER
PL PROPERTY LINE

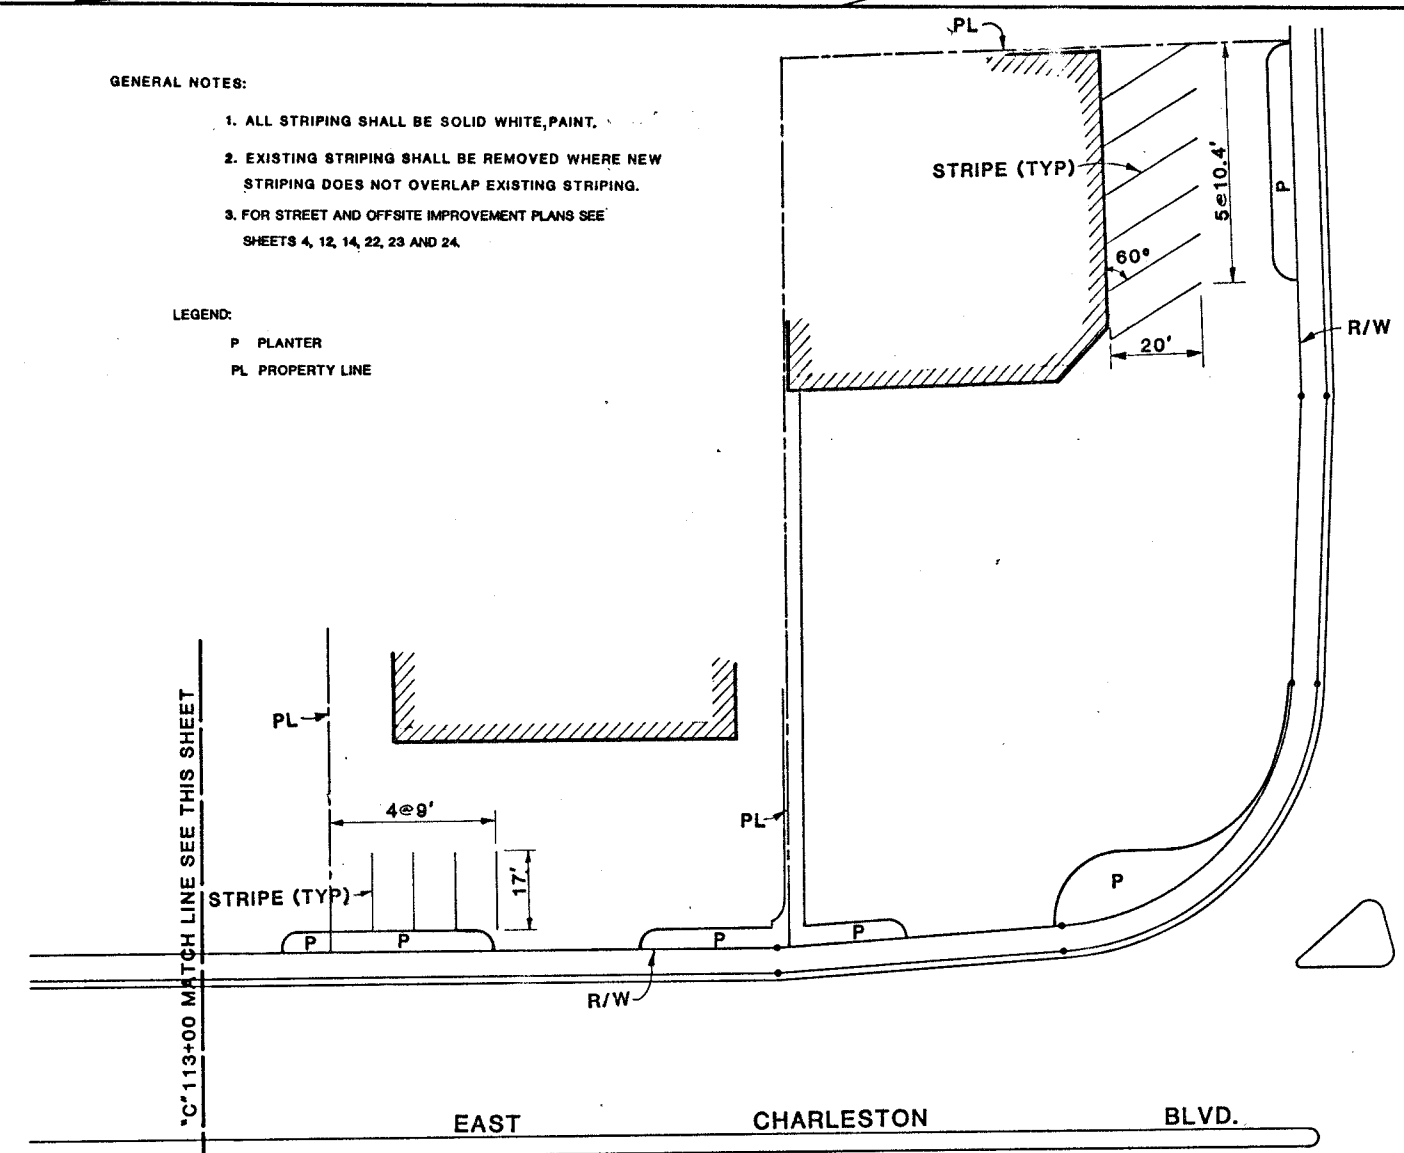

BLVD.
LAMB

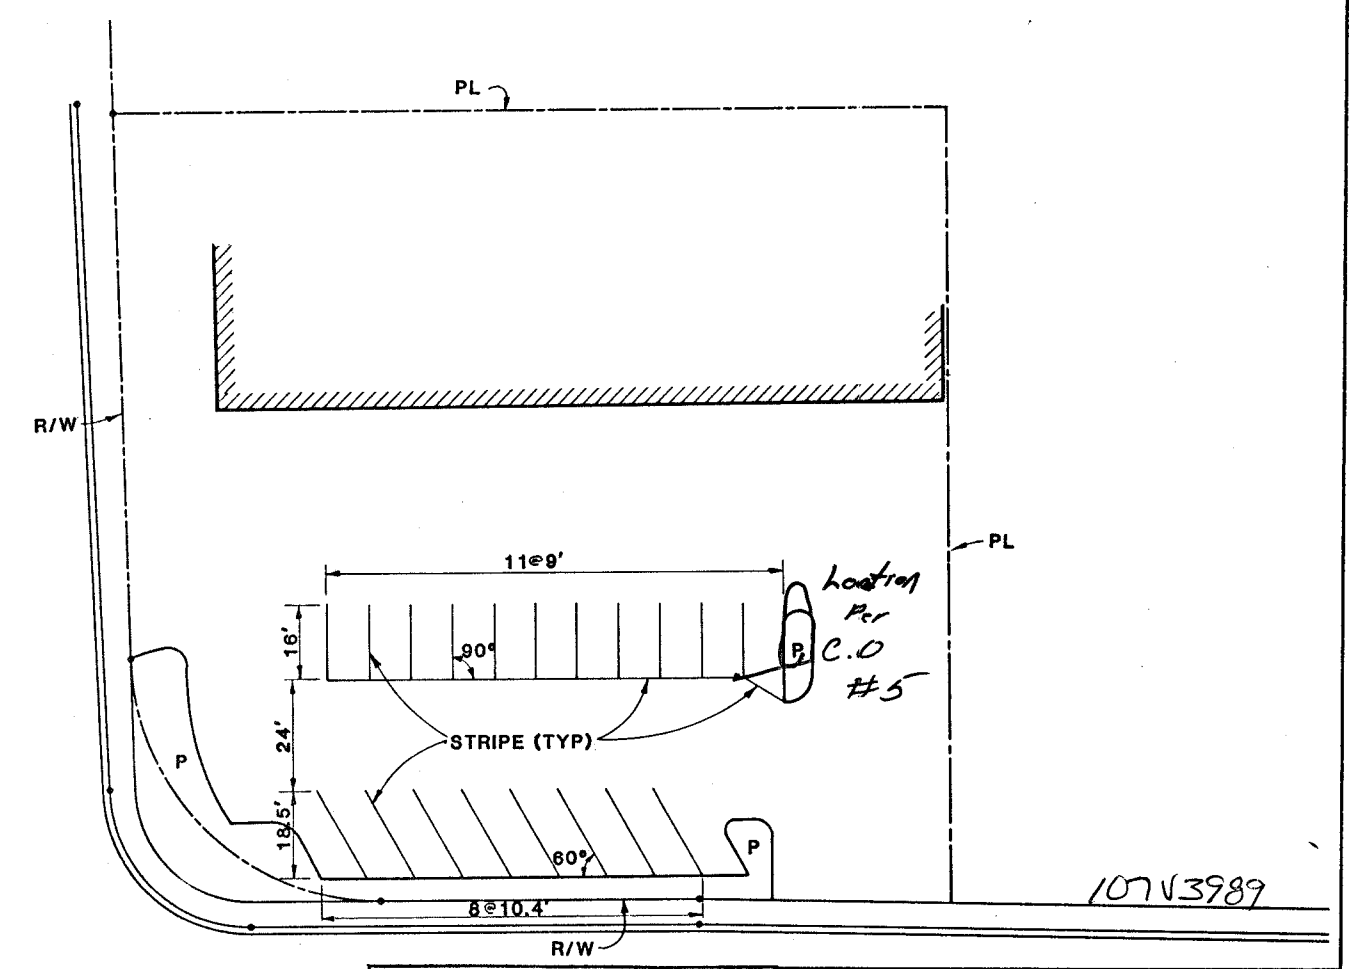

62016

REVISIONS
1. All Dimensions 8-27-90

SEA
REGISTERED PROFESSIONAL ENGINEER
FRANKLIN A. YERSON II
CIVIL
04963
3-30-90

RENO, SPARKS, NEVADA
LAS VEGAS, NEVADA
PHOENIX, ARIZONA

JOB NO. 990-02-2
DESIGNED G.S.
DRAWN C.H.W.
CHECKED J.C.B.
DATE 3-30-90

STATE OF NEVADA
DEPARTMENT OF TRANSPORTATION

OFFSITE PARKING STRIPING DETAILS