


SHEET INDEX

SHEET #	SHEET	DESCRIPTION
1	C1	COVER SHEET
2	C2	VICINITY MAP
3	C3	GENERAL NOTES & SYMBOLS
4	C4	QUANTITIES AND SCHEDULES
5	C5	MASTER UTILITY PLAN
6	HC1	HORIZONTAL CONTROL PLAN I
7	HC2	HORIZONTAL CONTROL PLAN II
8	HC3	HORIZONTAL CONTROL PLAN III
9	HC4	HORIZONTAL CONTROL PLAN IV
10	G1	GRADING PLAN I
11	G2	GRADING PLAN II
12	G3	GRADING PLAN III
13	G4	GRADING PLAN IV
14	U1	UTILITY PLAN I
15	U2	UTILITY PLAN II
16	U3	UTILITY PLAN III
17	U4	UTILITY PLAN IV
18	U5	UTILITY PLAN V
19	PP1	STREET AND UTILITY PLAN AND PROFILE - RAINBOW BLVD - STA: 9+50 TO 18+50
20	PP2	STREET AND UTILITY PLAN AND PROFILE - RAINBOW BLVD - STA: 18+50 TO 25+00
21	PP3	STREET AND UTILITY PLAN AND PROFILE - LONE MOUNTAIN ROAD
22	PP4	UTILITY PLAN AND PROFILE - NUISANCE DRAIN
23	PP5	PUBLIC SEWER PLAN AND PROFILE - STA 10+00 TO 17+00
24	PP6	PUBLIC SEWER PLAN AND PROFILE - STA 17+00 TO 24+00
24A	PP6A	PUBLIC SEWER PLAN AND PROFILE - ADDITIONAL STUB
25	PP7	PUBLIC SEWER PLAN AND PROFILE - STA 24+00 TO 31+00
26	PP8	STREET AND UTILITY PLAN AND PROFILE - RED COACH AVENUE
27	F1	FIRE PLAN
28	SL1	STREET LIGHT AND TRAFFIC PLAN I
28A	SL1A	REVISED STREET LIGHT AND TRAFFIC PLAN I
29	SL2	STREET LIGHT AND TRAFFIC PLAN II
29A	SL2A	REVISED STREET LIGHT AND TRAFFIC PLAN II
30	DT1	DETAIL SHEET
31	DT2	SECTION SHEET
32	DT3	SITE PLAN
33	DT4	FENCE PLAN
34	DT5	MAIN ENTRANCE DETAIL
35	DT6	POOL DETAIL
36	DT7	SECOND ENTRANCE DETAIL
37	DT8	HARDSCAPE DETAIL I
38	DT9	HARDSCAPE DETAIL II
39	DT10	HARDSCAPE DETAIL III
40	DT11	STANDARD DETAIL SHEET
41	DT12	PARKING PLAN

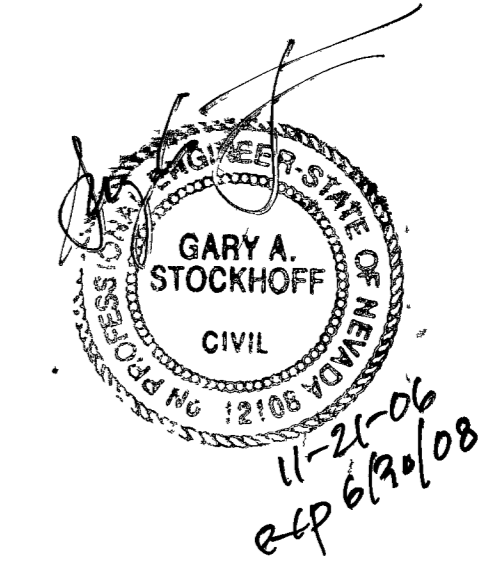

FIRE DEPARTMENT APPROVAL

APPROVED BY THE FIRE DEPARTMENT HAVING JURISDICTION IS REQUIRED PRIOR TO OBTAINING FINAL APPROVAL FROM THE LVVWD.

APPROVAL FOR CONSTRUCTION

Sen. [Signature]
LAS VEGAS VALLEY WATER DISTRICT
DATE: 11-15-05

78370 08
85135 11
86666 08 98558

<p>REVISIONS</p> <table border="1"> <tr><td>1</td><td>11-16-04</td><td>BAK</td><td>ADD SHEETS 28A & 29A</td><td>KB 11/21/06</td></tr> <tr><td>2</td><td>11-16-04</td><td>BAK</td><td>ADD SHEETS 28A & 29A</td><td>KB 11/21/06</td></tr> </table>	1	11-16-04	BAK	ADD SHEETS 28A & 29A	KB 11/21/06	2	11-16-04	BAK	ADD SHEETS 28A & 29A	KB 11/21/06	<p>LONE MOUNTAIN APARTMENTS</p>	<p>SCALE: N.T.S.</p>
1	11-16-04	BAK	ADD SHEETS 28A & 29A	KB 11/21/06								
2	11-16-04	BAK	ADD SHEETS 28A & 29A	KB 11/21/06								
<p>DRAWN BY: REH DESIGNED BY: REH CHECKED BY: P.E. PROJECT NO: 662-E189</p>	<p>SHEET: C2 2 OF 41 SHEETS DRAWING NO: 107V 4322</p>	<p>DATE: 11-15-05</p>										