


APN: 125-35-402-001
ZONED: C-2


NOTE: EXISTING CURB LINES SHOWN ALONG LONE MOUNTAIN ROAD ARE BASED ON AERIAL PHOTOGRAPHY AND ARE FOR REFERENCE PURPOSES ONLY.

NOTE: CONTRACTOR TO ADJUST SIGNAL HEAD SPACING TO LINE UP WITH NEW LANE LOCATIONS AS NEEDED AND PER CLV CONCURRENCE.

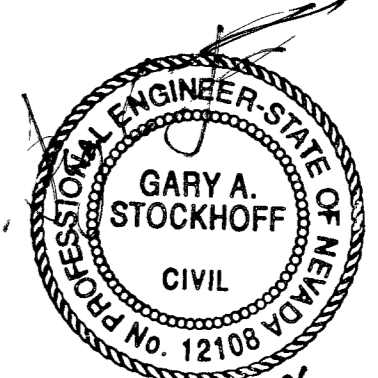

11-28-06
APP. 6/30/08
FOR DENISION ONLY

J-U-B ENGINEERS, Inc.
115 Northstar Avenue
Twin Falls, Idaho 83301
Phone: 208.733.2414
Fax: 208.733.9455
www.jub.com

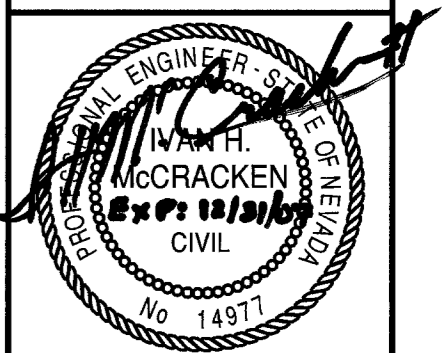

DATE: 11/06/06

NO.	DESCRIPTION	DATE
1	ADJUST ST. LOCATIONS	11/20/06

LONE MOUNTAIN APARTMENTS
OVATION DEVELOPMENT CORPORATION

REVISED STRIPING PLAN
STREET LIGHT AND TRAFFIC PLAN 1

CONSTRUCTION SET 11/06/06

FILE RLM STRIPING INTERIM
DRAWN BY IHM
DESIGN BY IHM
CHECKED BY
SCALE OF SHEET
HOR SCALE 1" = 40'
VER SCALE NONE
LAST UPDATED 11/6/2006
DATE PLOTTED 11/6/2006
SHEET
28A
OF 43

RELOT

98574

F:\PROJECTS\06-06-093\DWG\RLM-STRIPING-INTERIM.DWG