
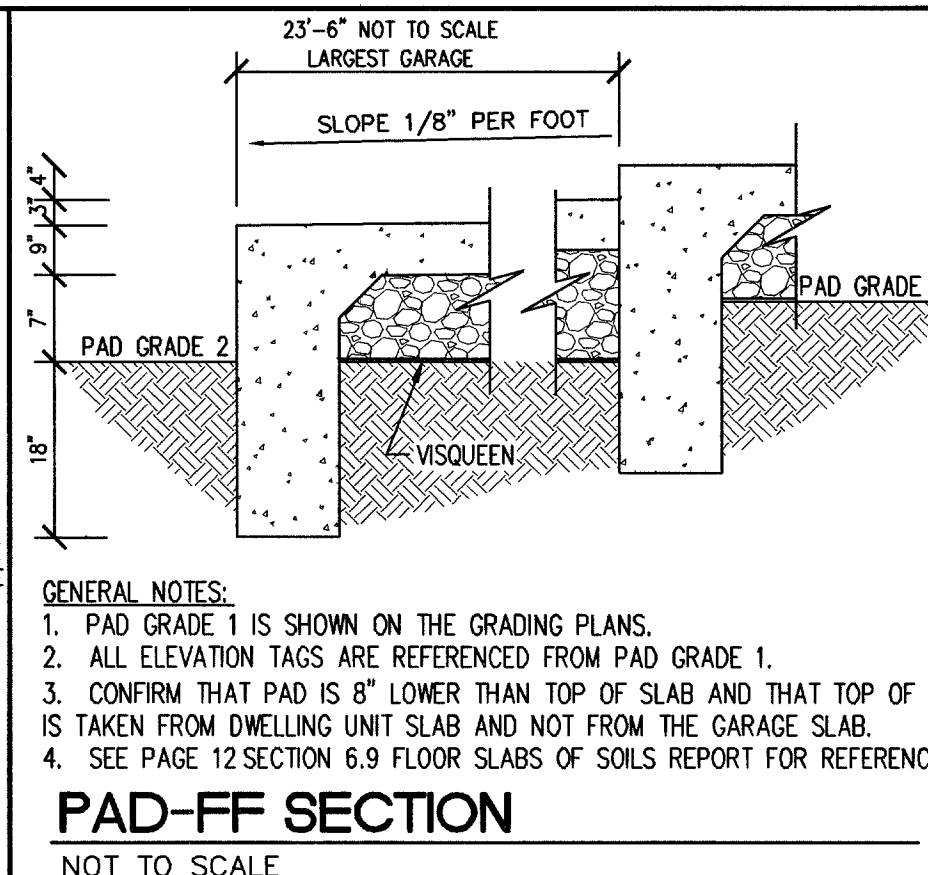
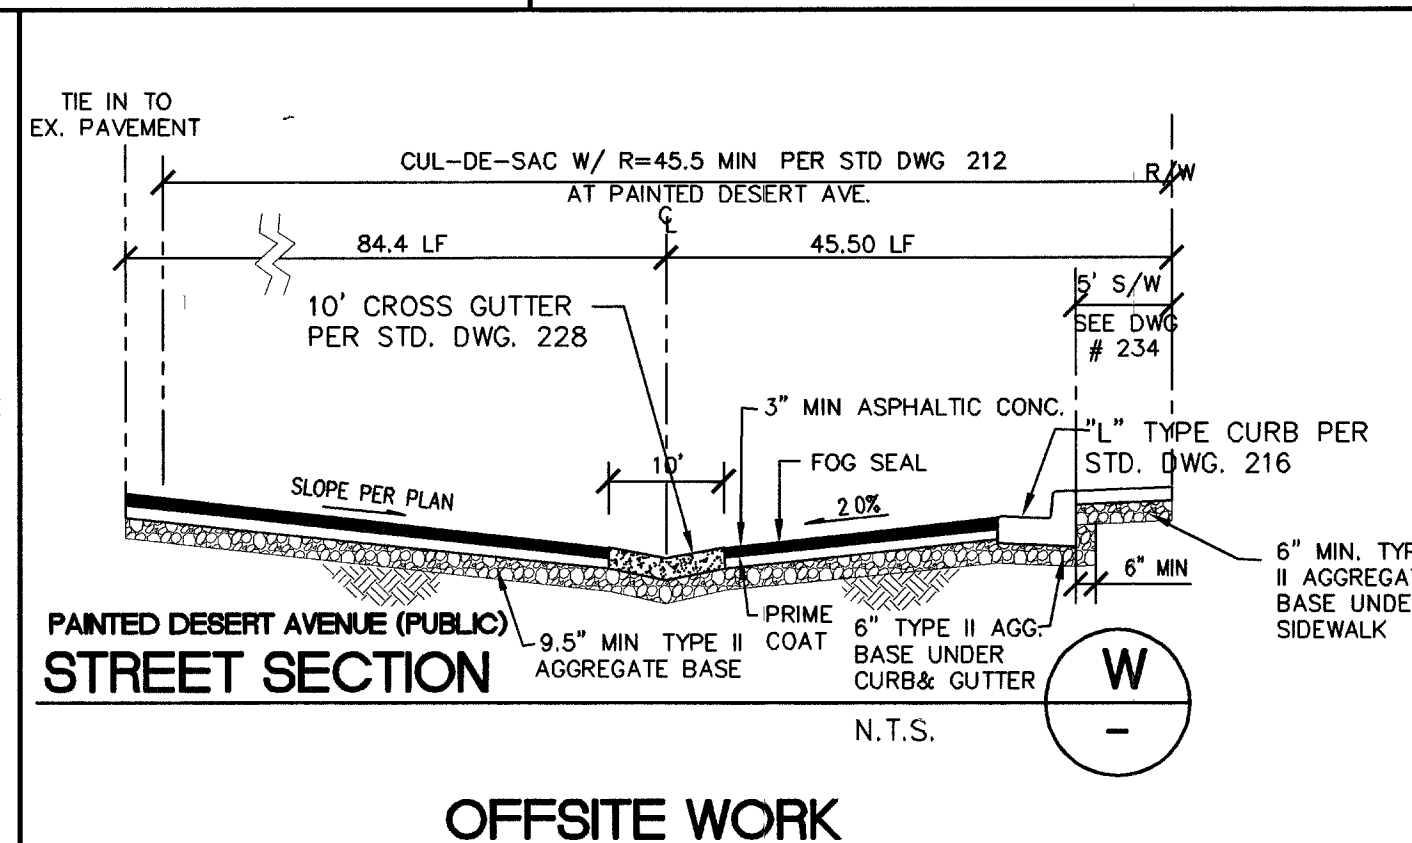
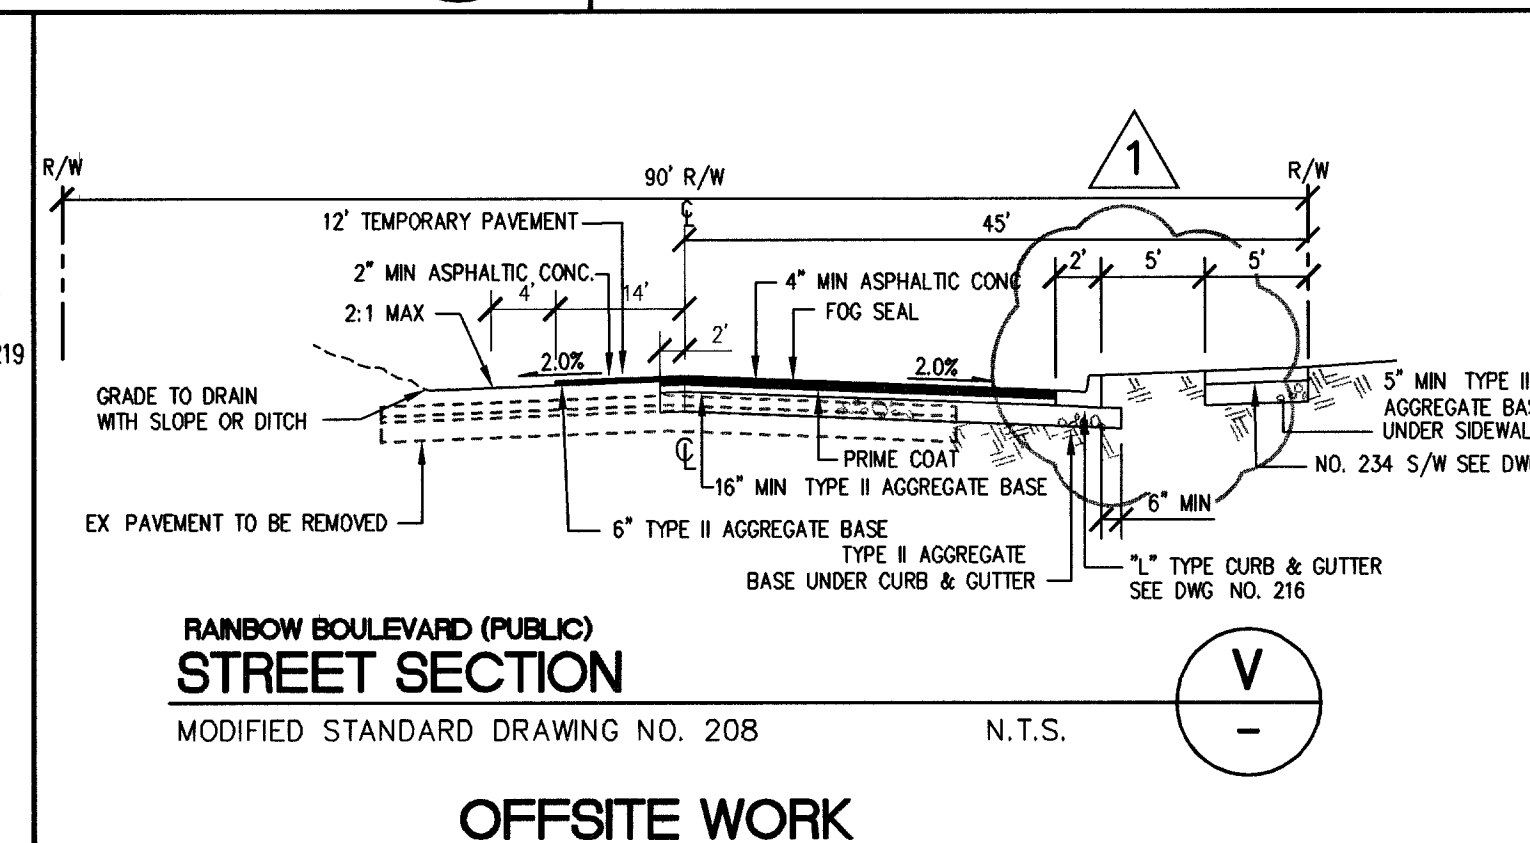
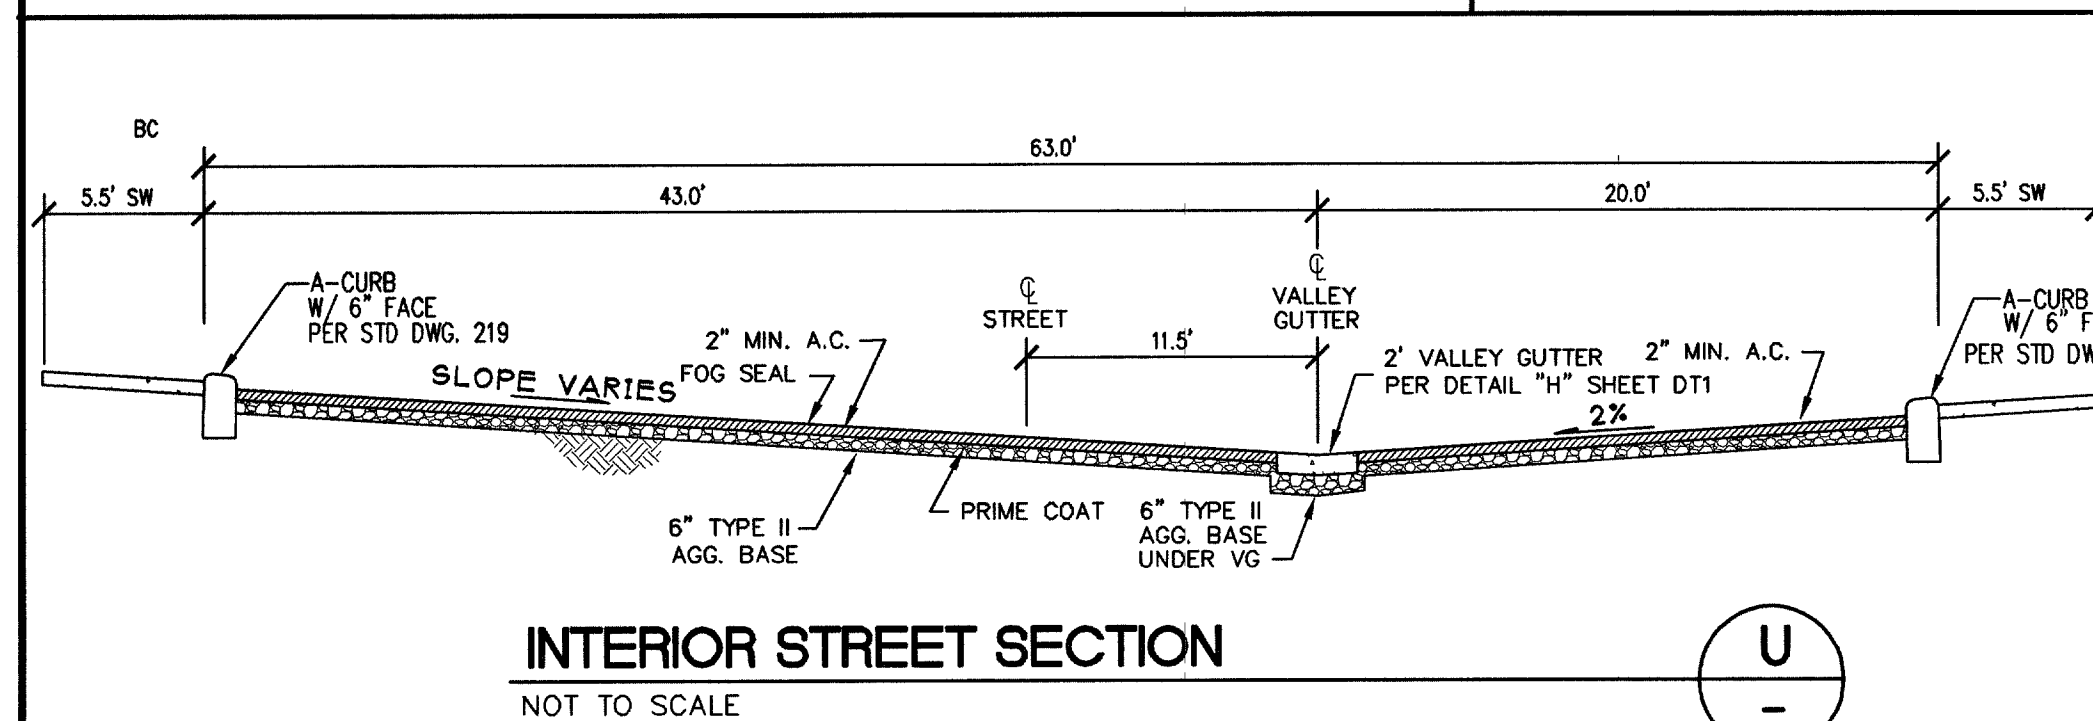
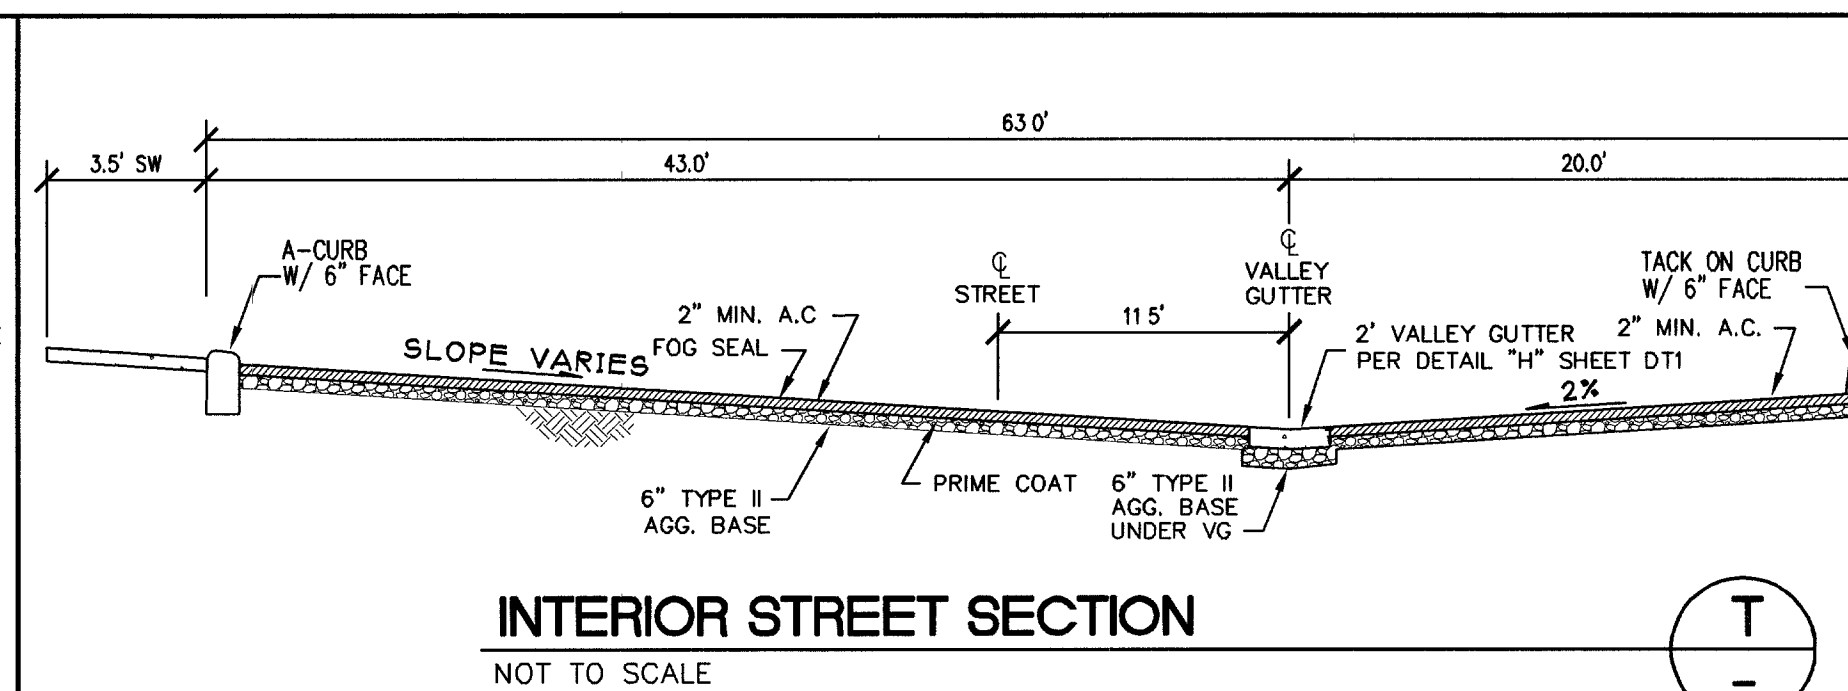
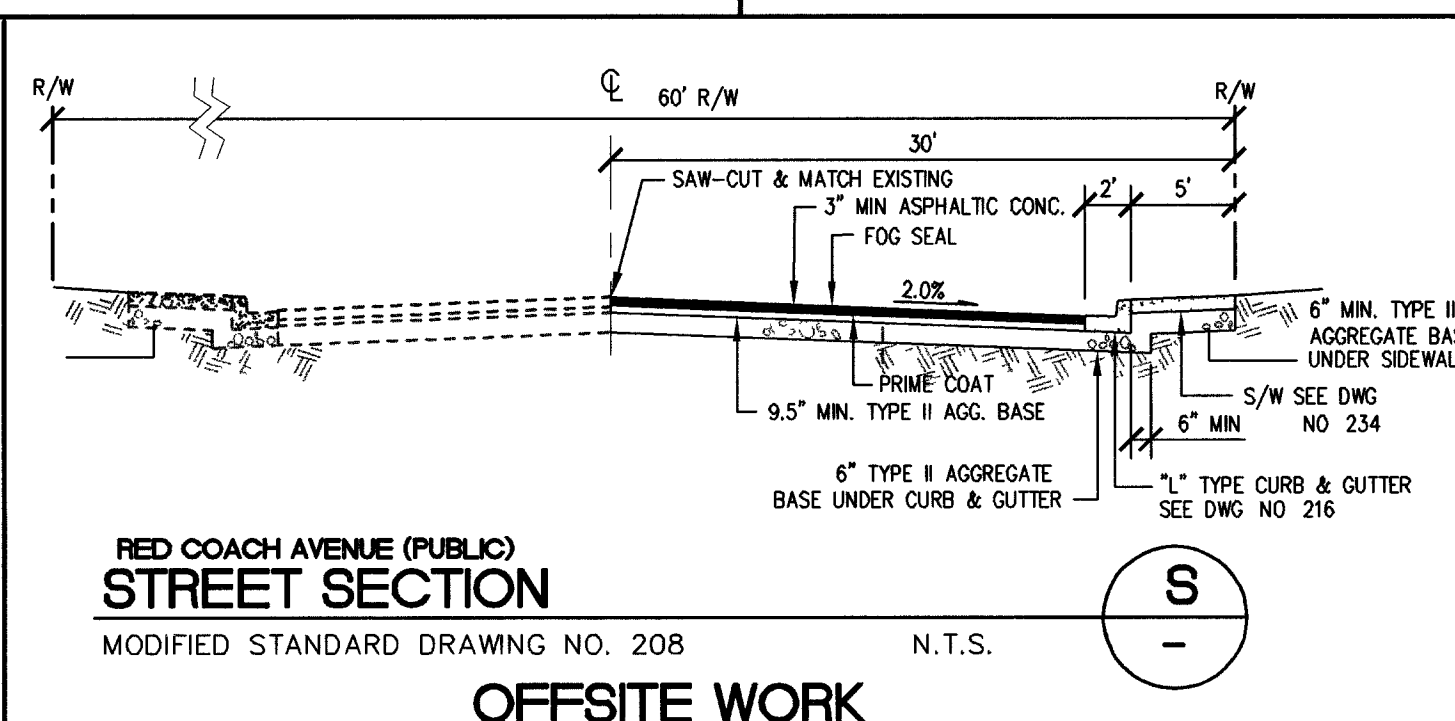
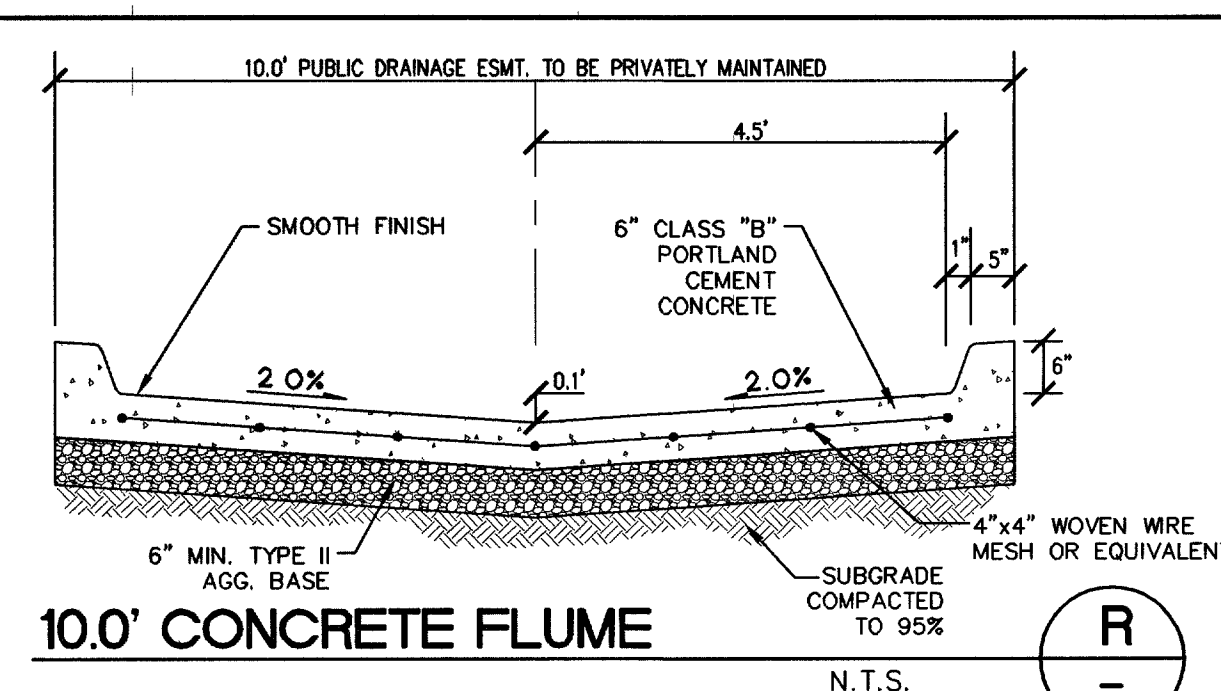
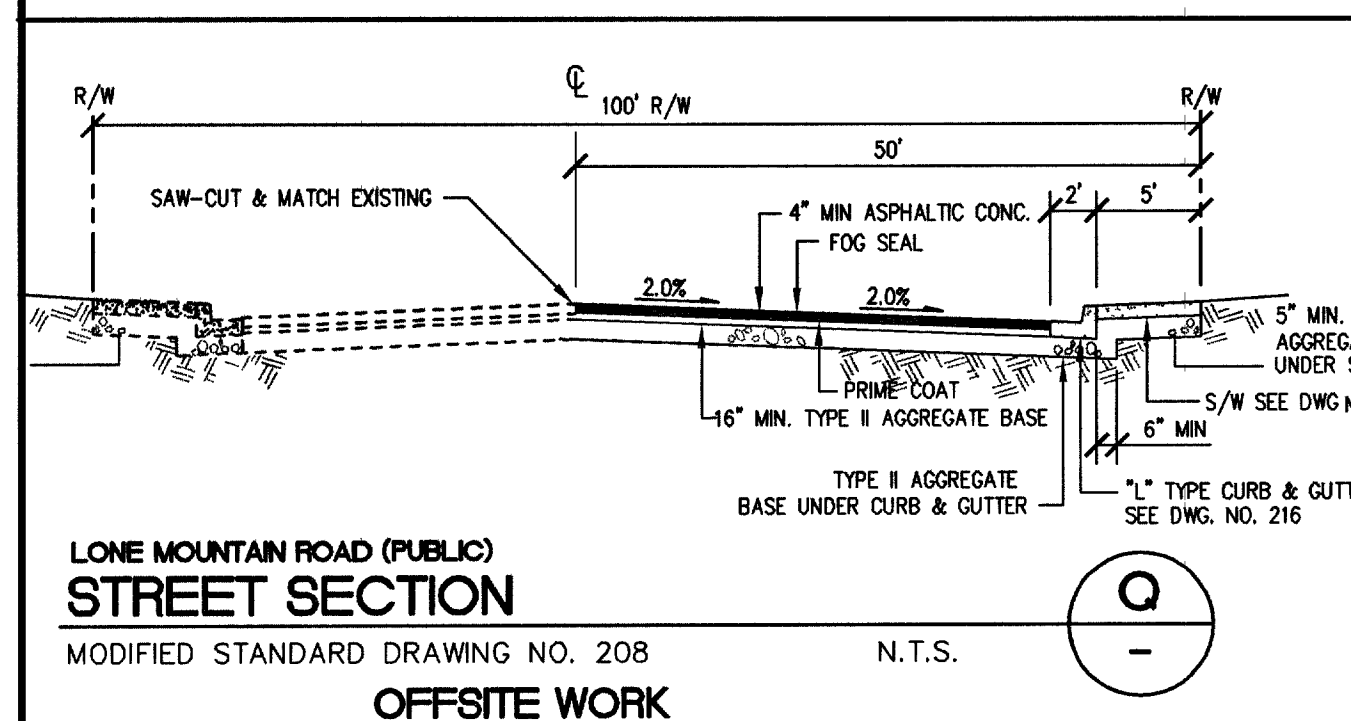
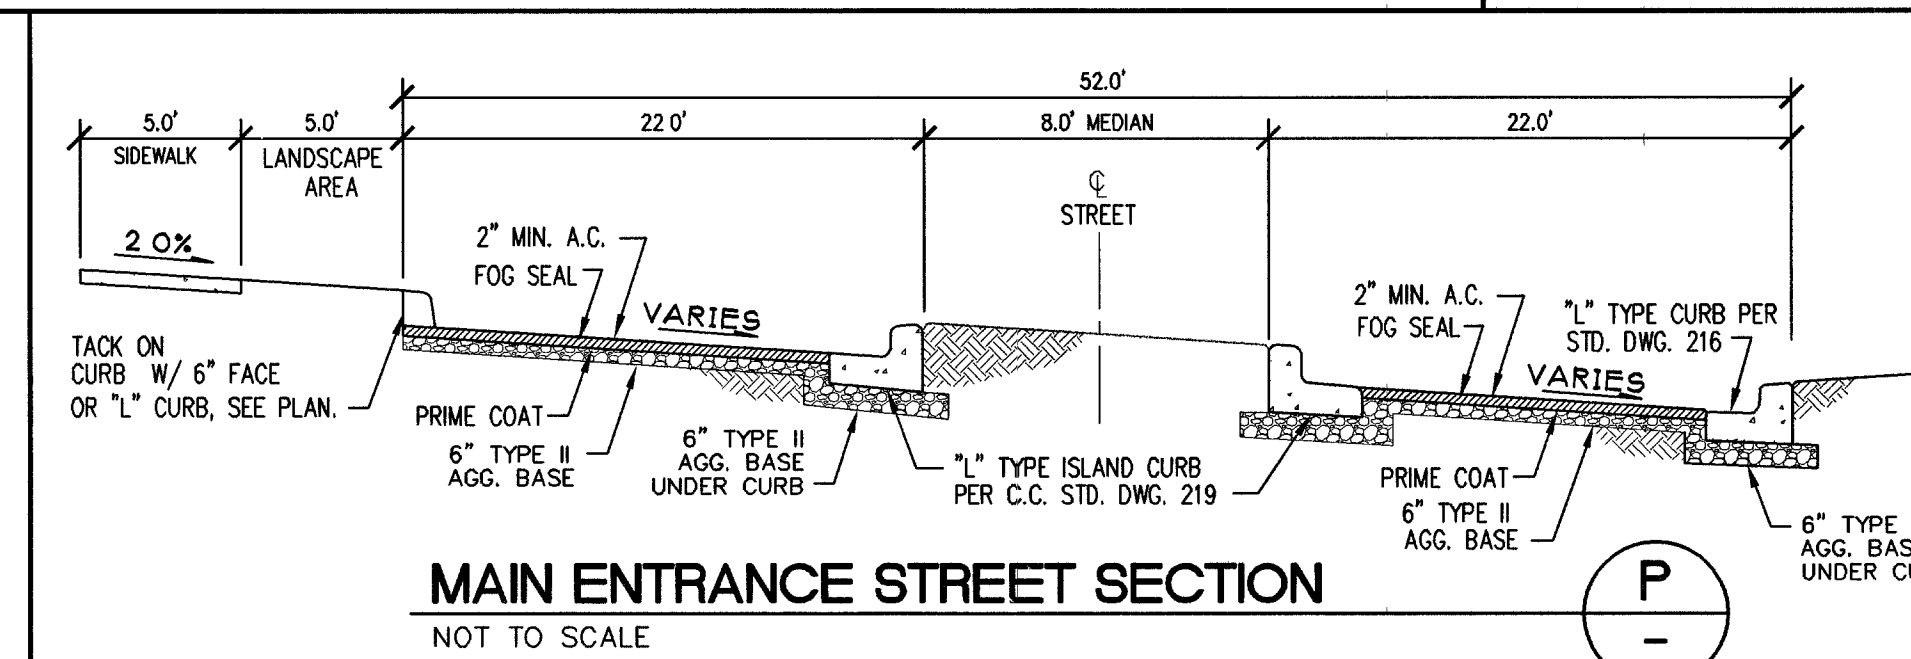
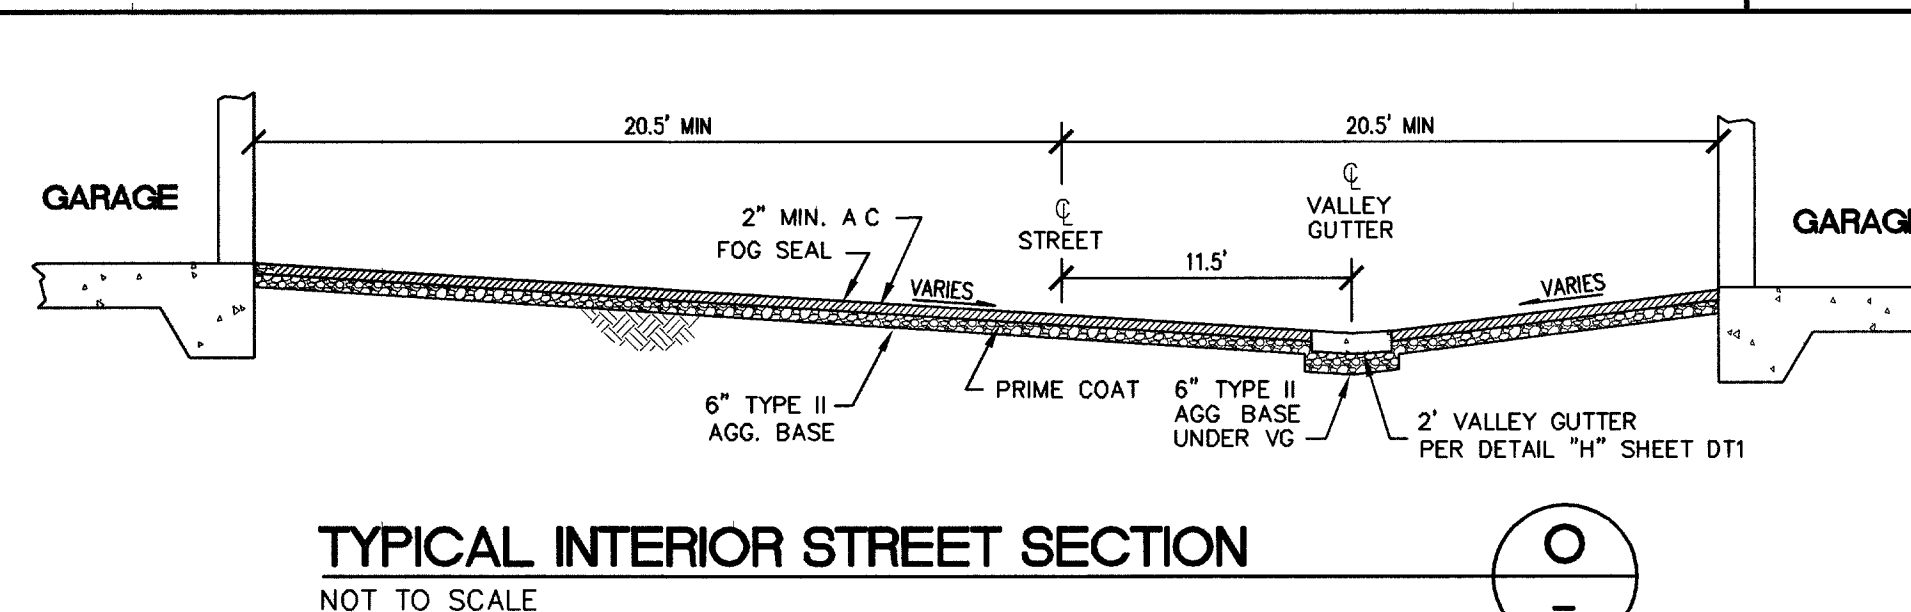
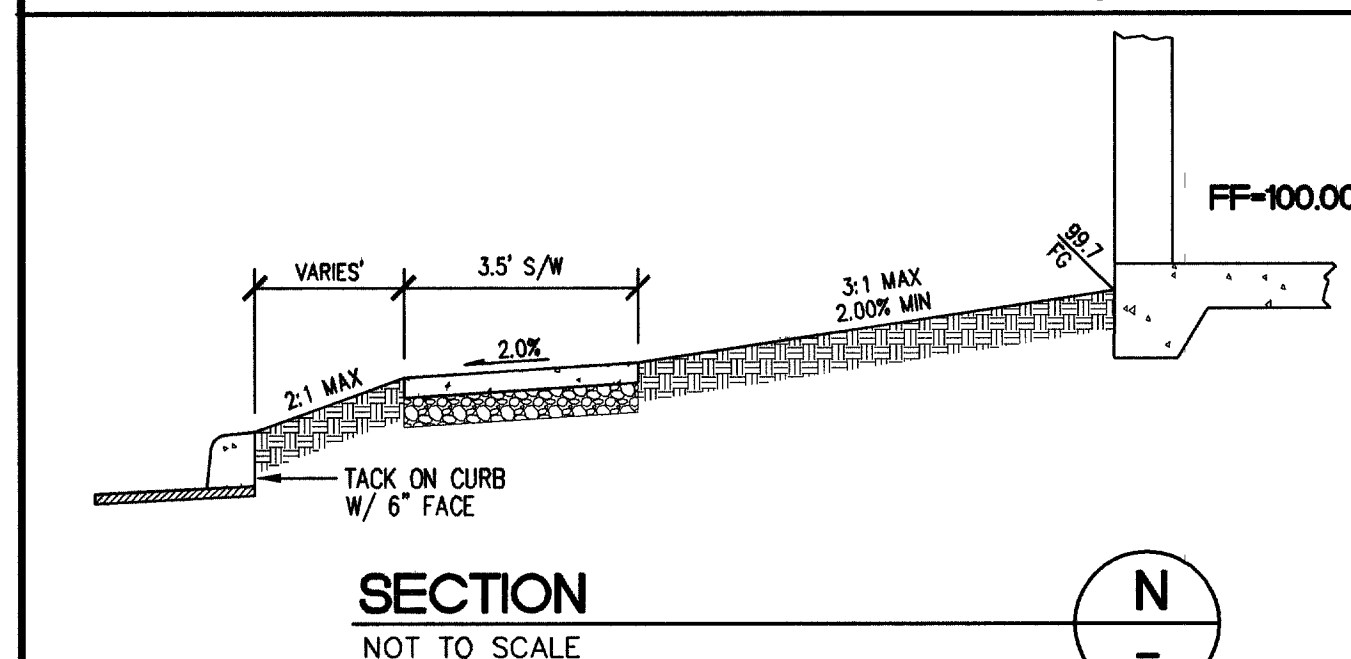
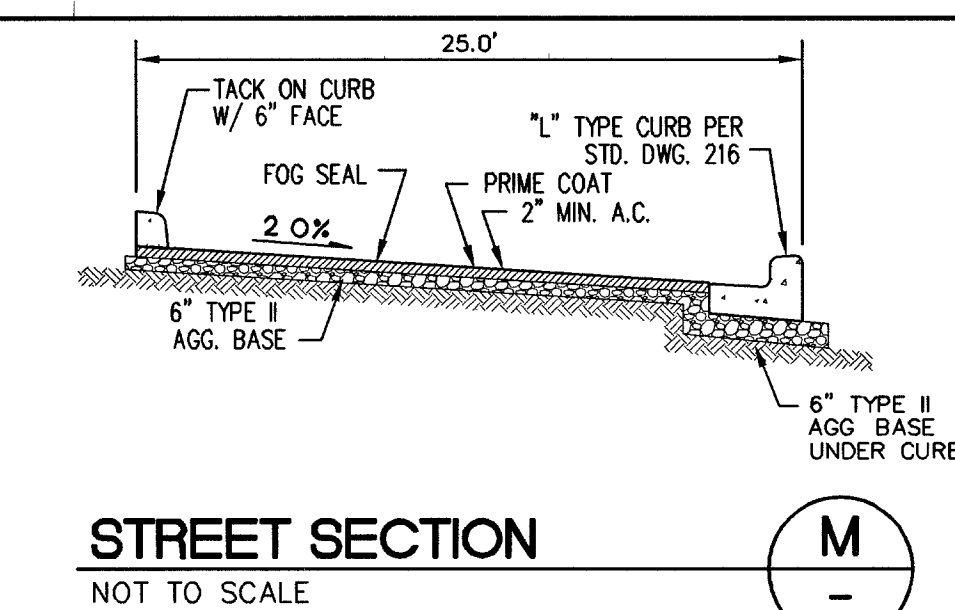
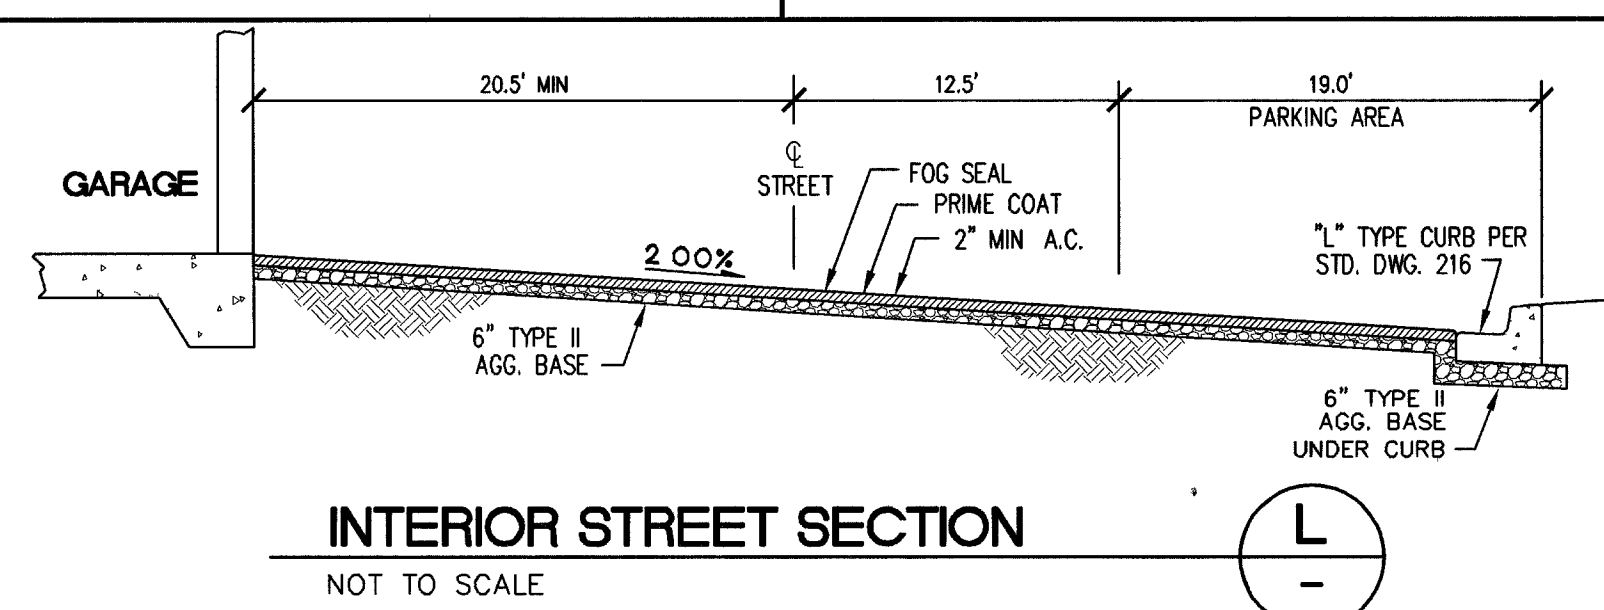
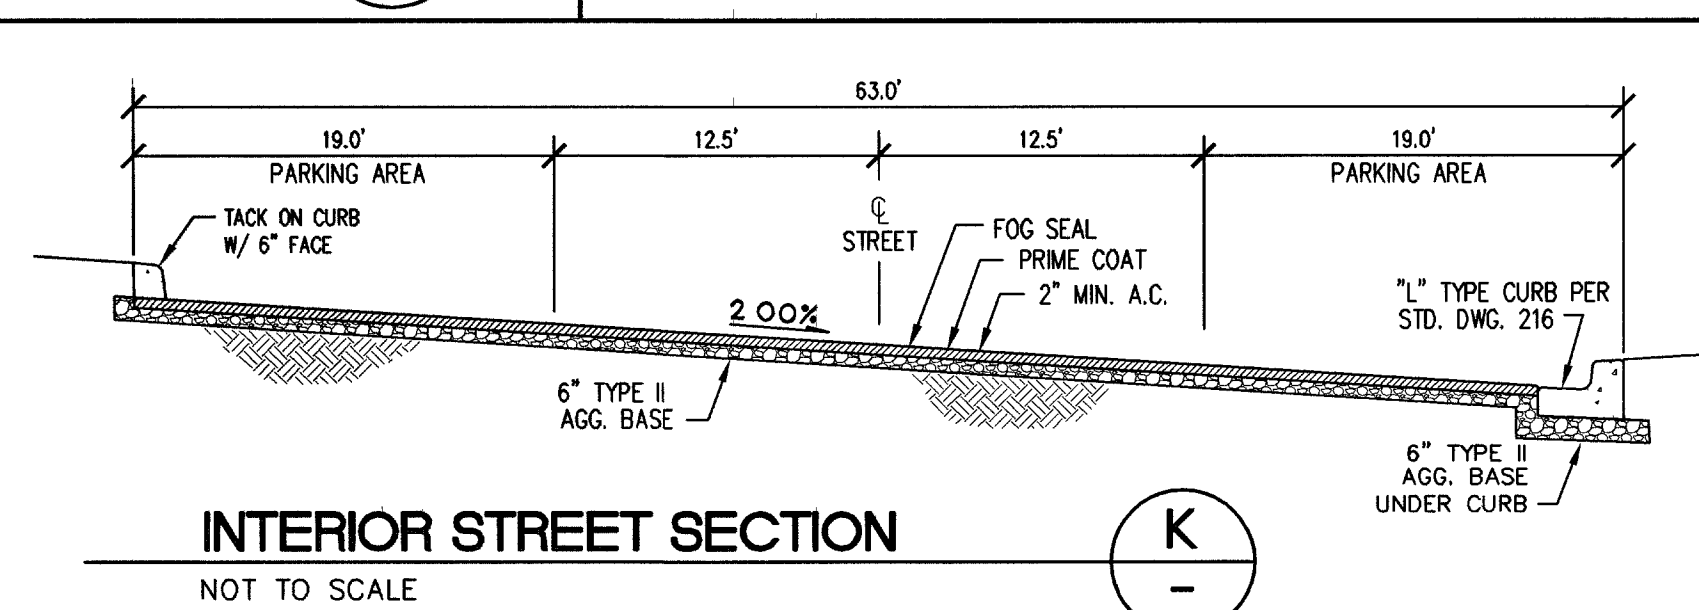
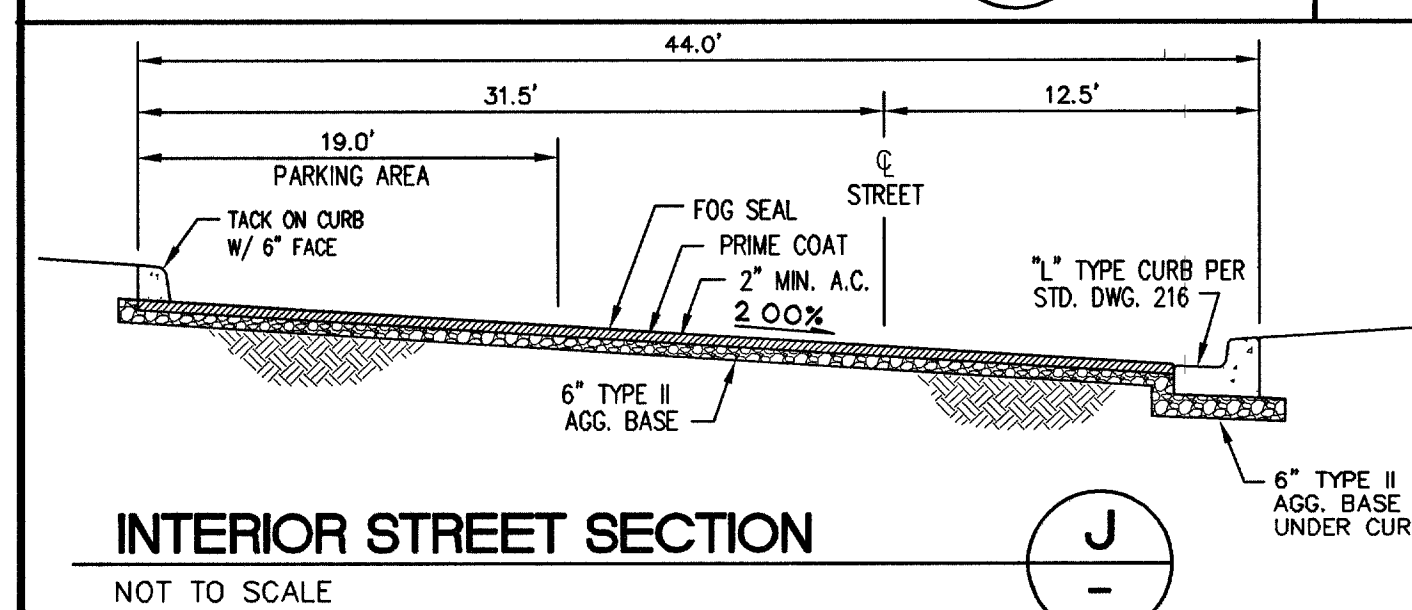
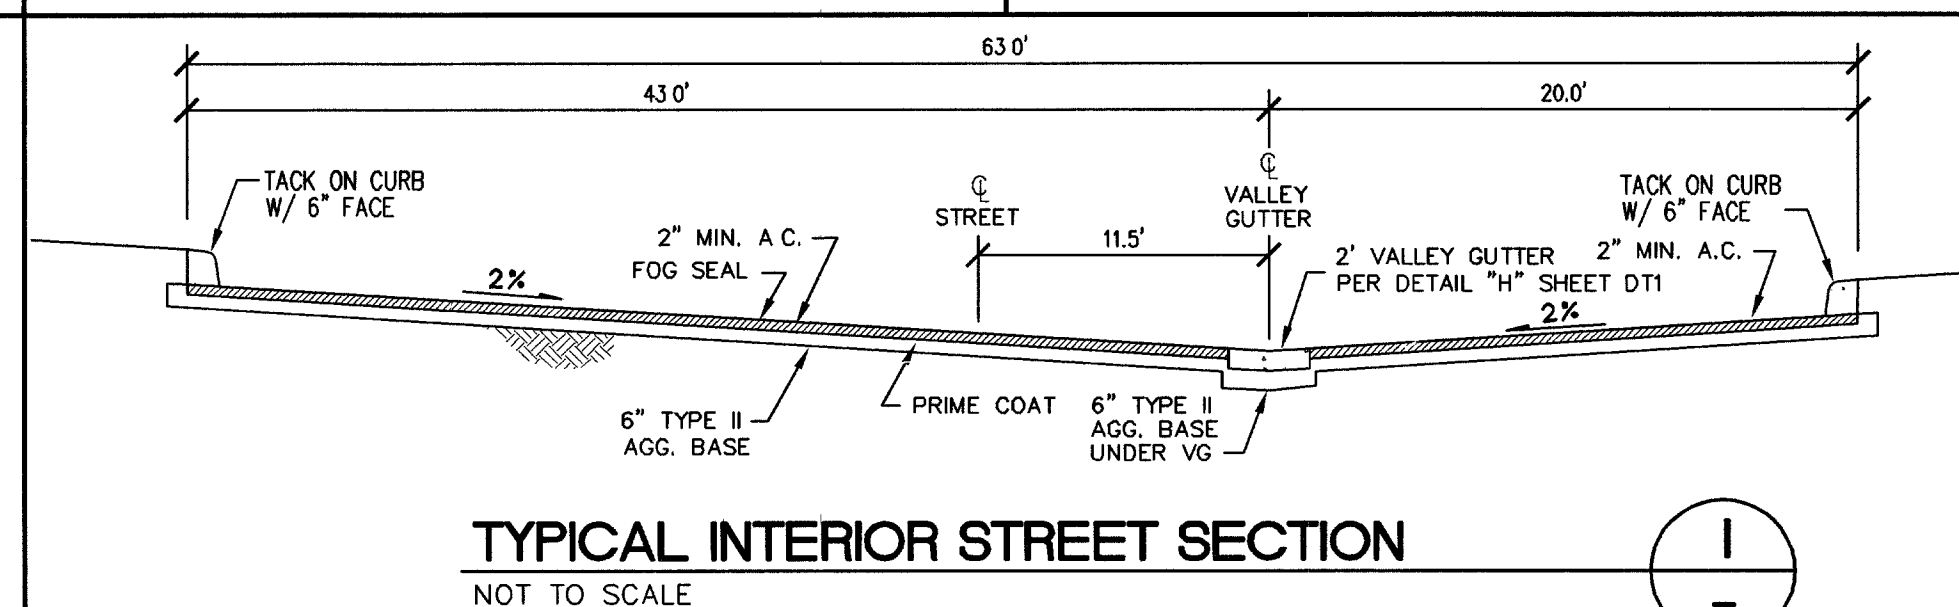
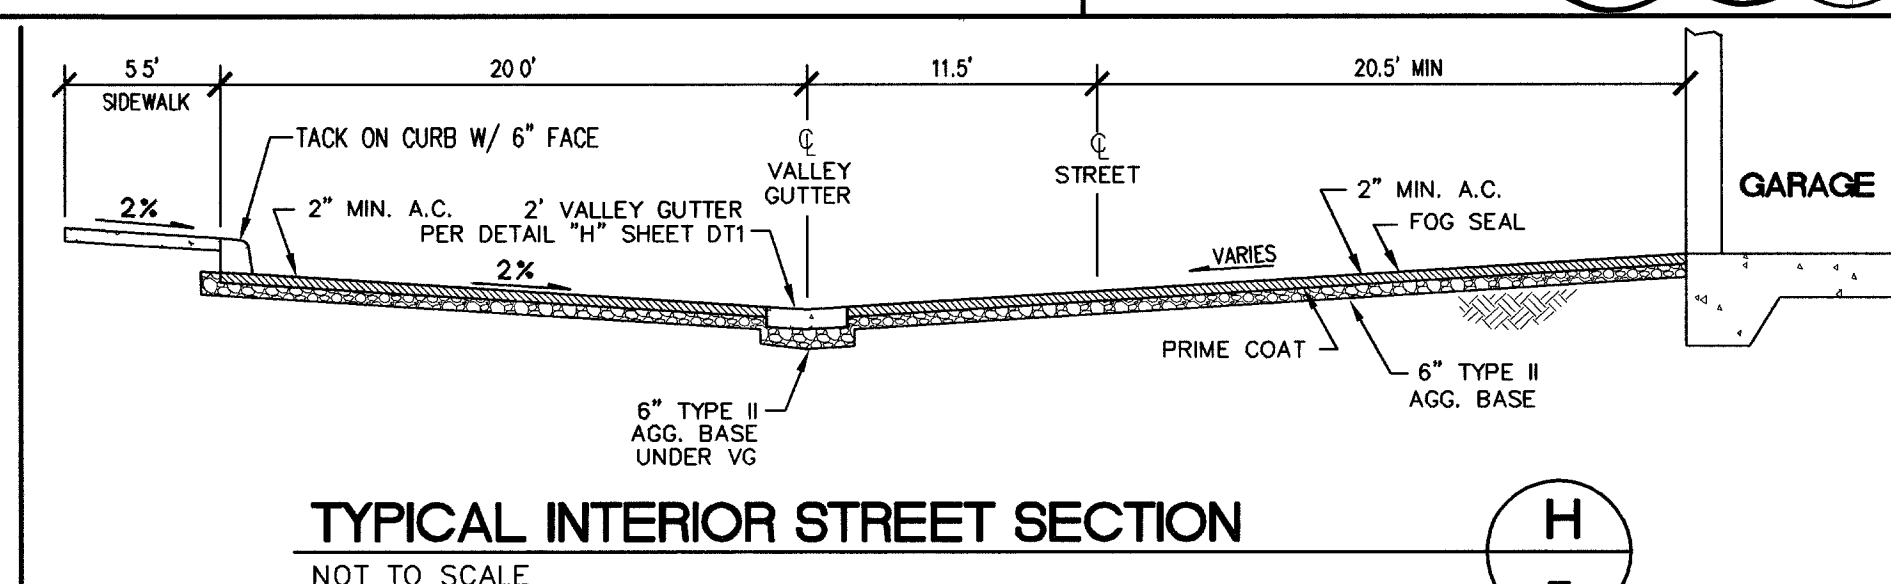
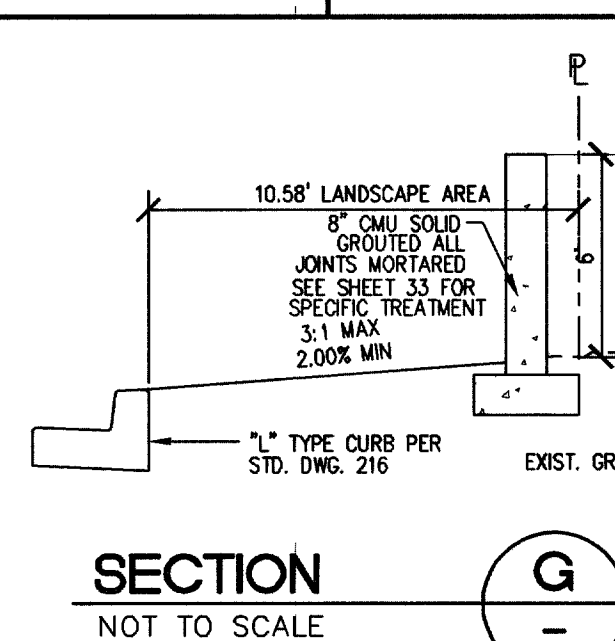
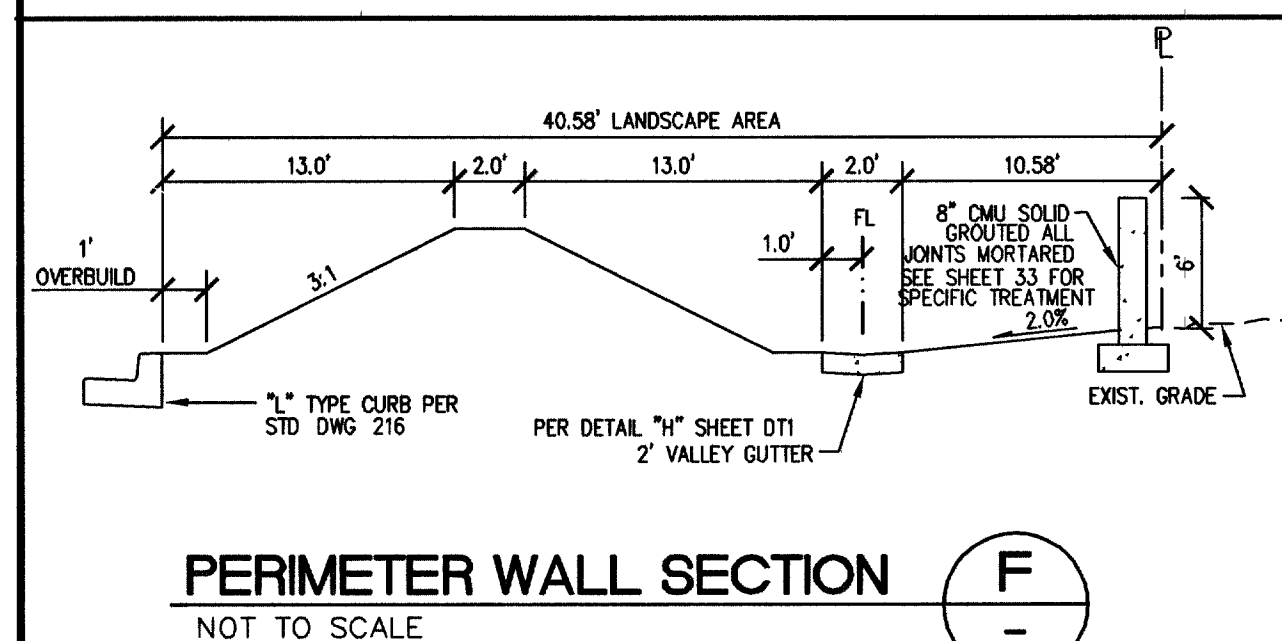
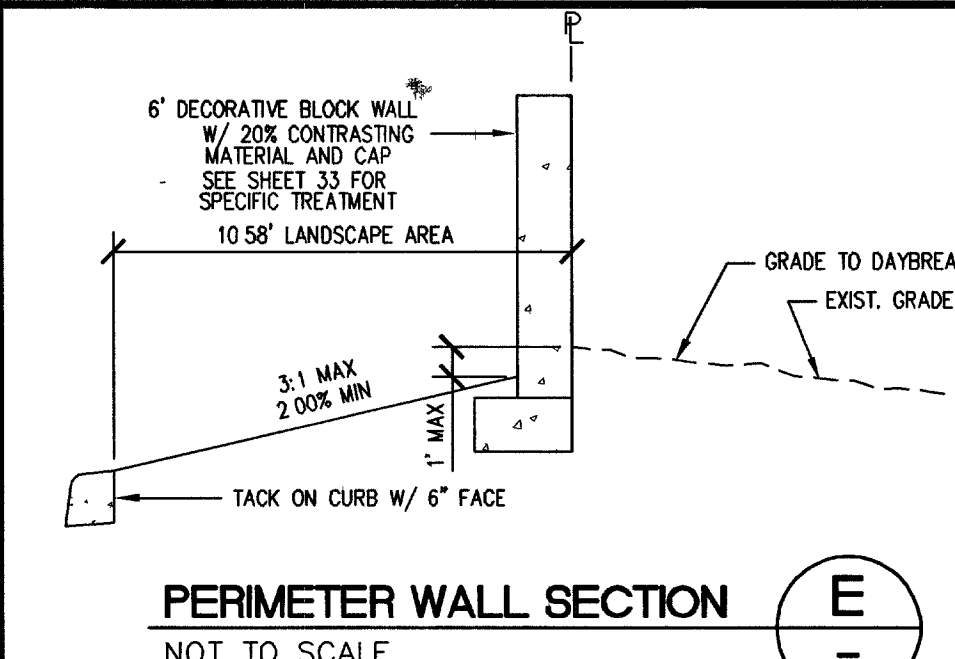
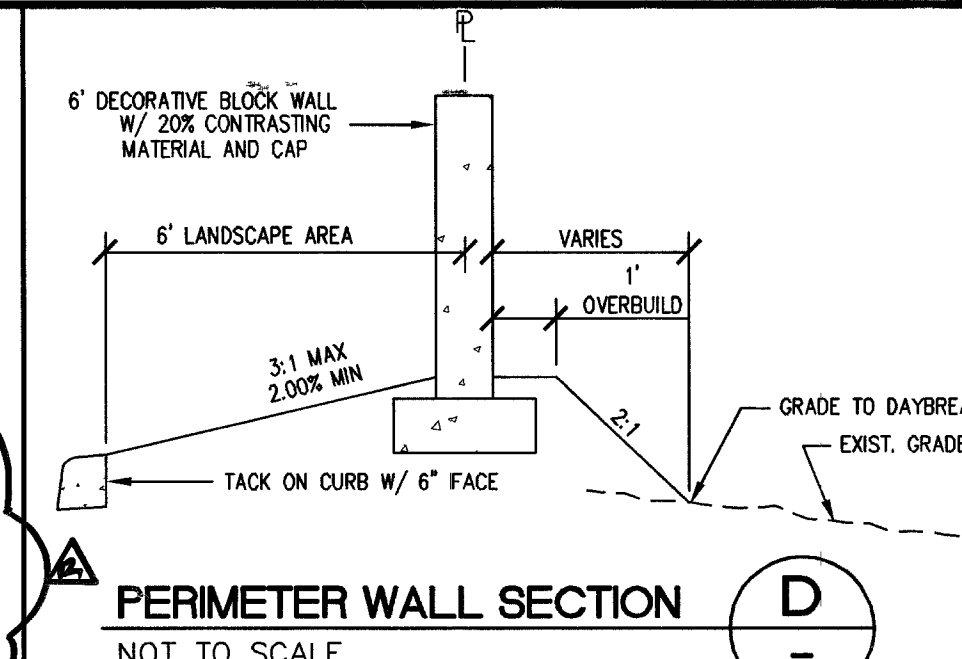
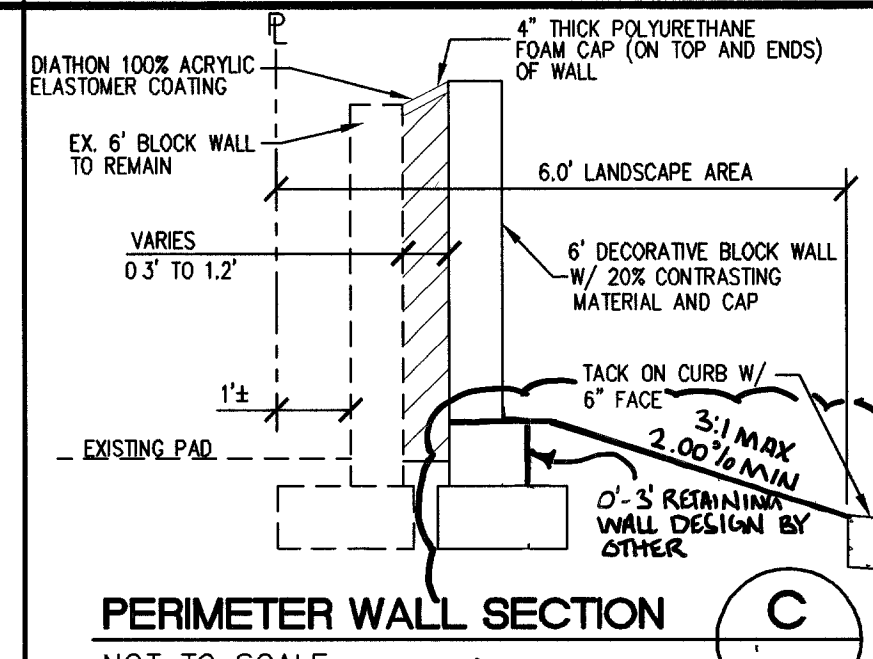
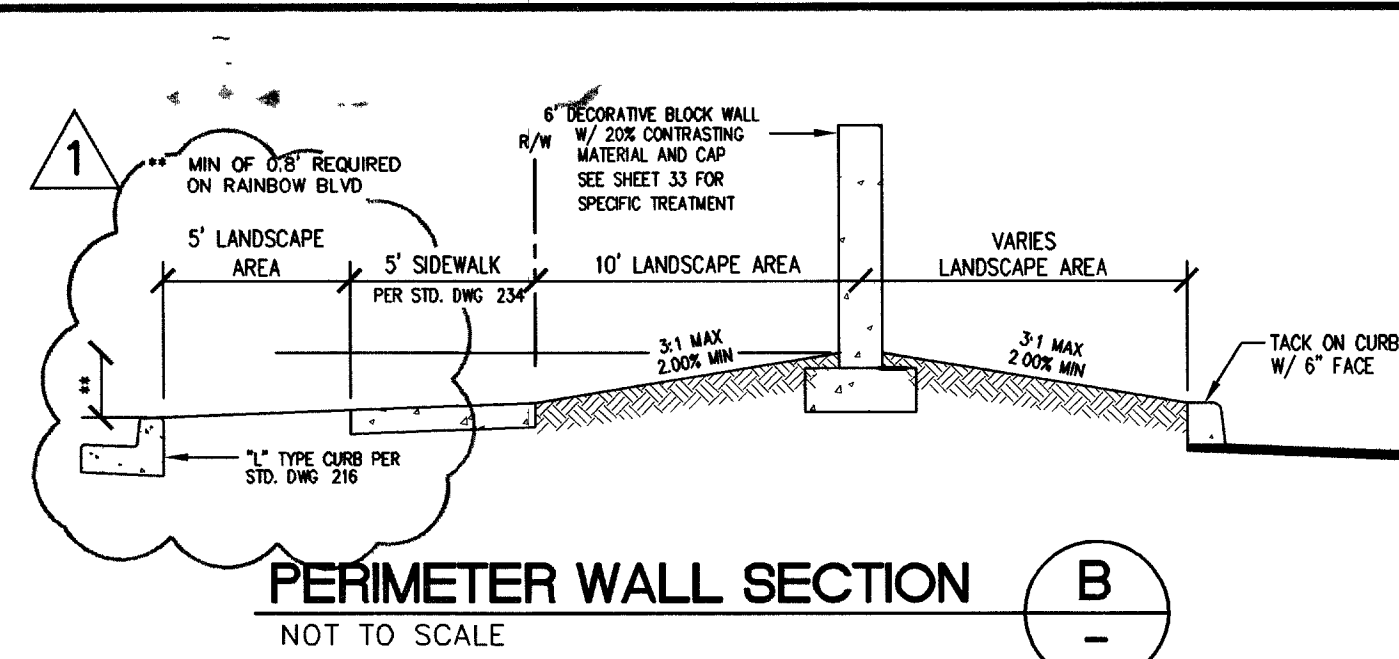


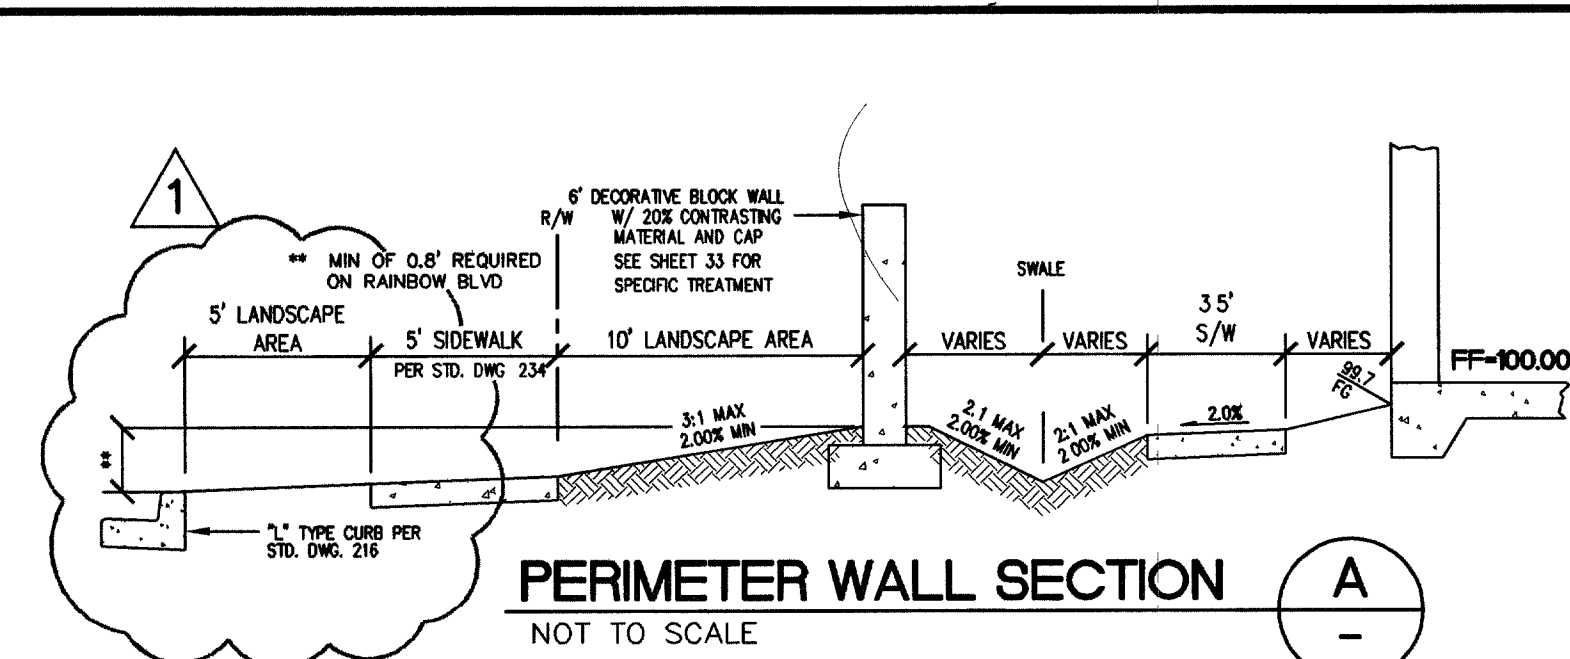

98577 100459

[illegible]

NOVATION DEVELOPMENT

1175 AMERICAN PACIFIC DRIVE, SUITE F
HENDERSON, NEVADA 89074
CONTACT: JAN GOYER (702) 990-2325

HENDERSON, NEVADA 89074
CONTACT: JAN GOYER (702) 990-2325

VPOINT
DESIGNING FOR THE FUTURE
PLANNERS • CONSULTING ENGINEERS • SURVEYORS

009 WHITNEY RANCH DRIVE • HENDERSON, NEVADA 89014 • (702) 748-6413

SECTION SHEET

ONE MOUNTAIN APARTMENTS

1

APPENDIX C

DRAWN BY:
RFH
APR/11/2004

DESIGNED BY: _____
DATE: _____
PAGE NO.: _____

REH _____ APRIL 2004 _____

CHECKED BY: _____
P II _____

PROJECT NO.	SCALE
-------------	-------

Professional Engineer Seal for Gary A. Stockhoff, State of Nevada, Civil, Exp. 06-30-08.

SHEET
DT2
31 OF 41 SHEETS
DRAWING NO
107V4322

REALOT