


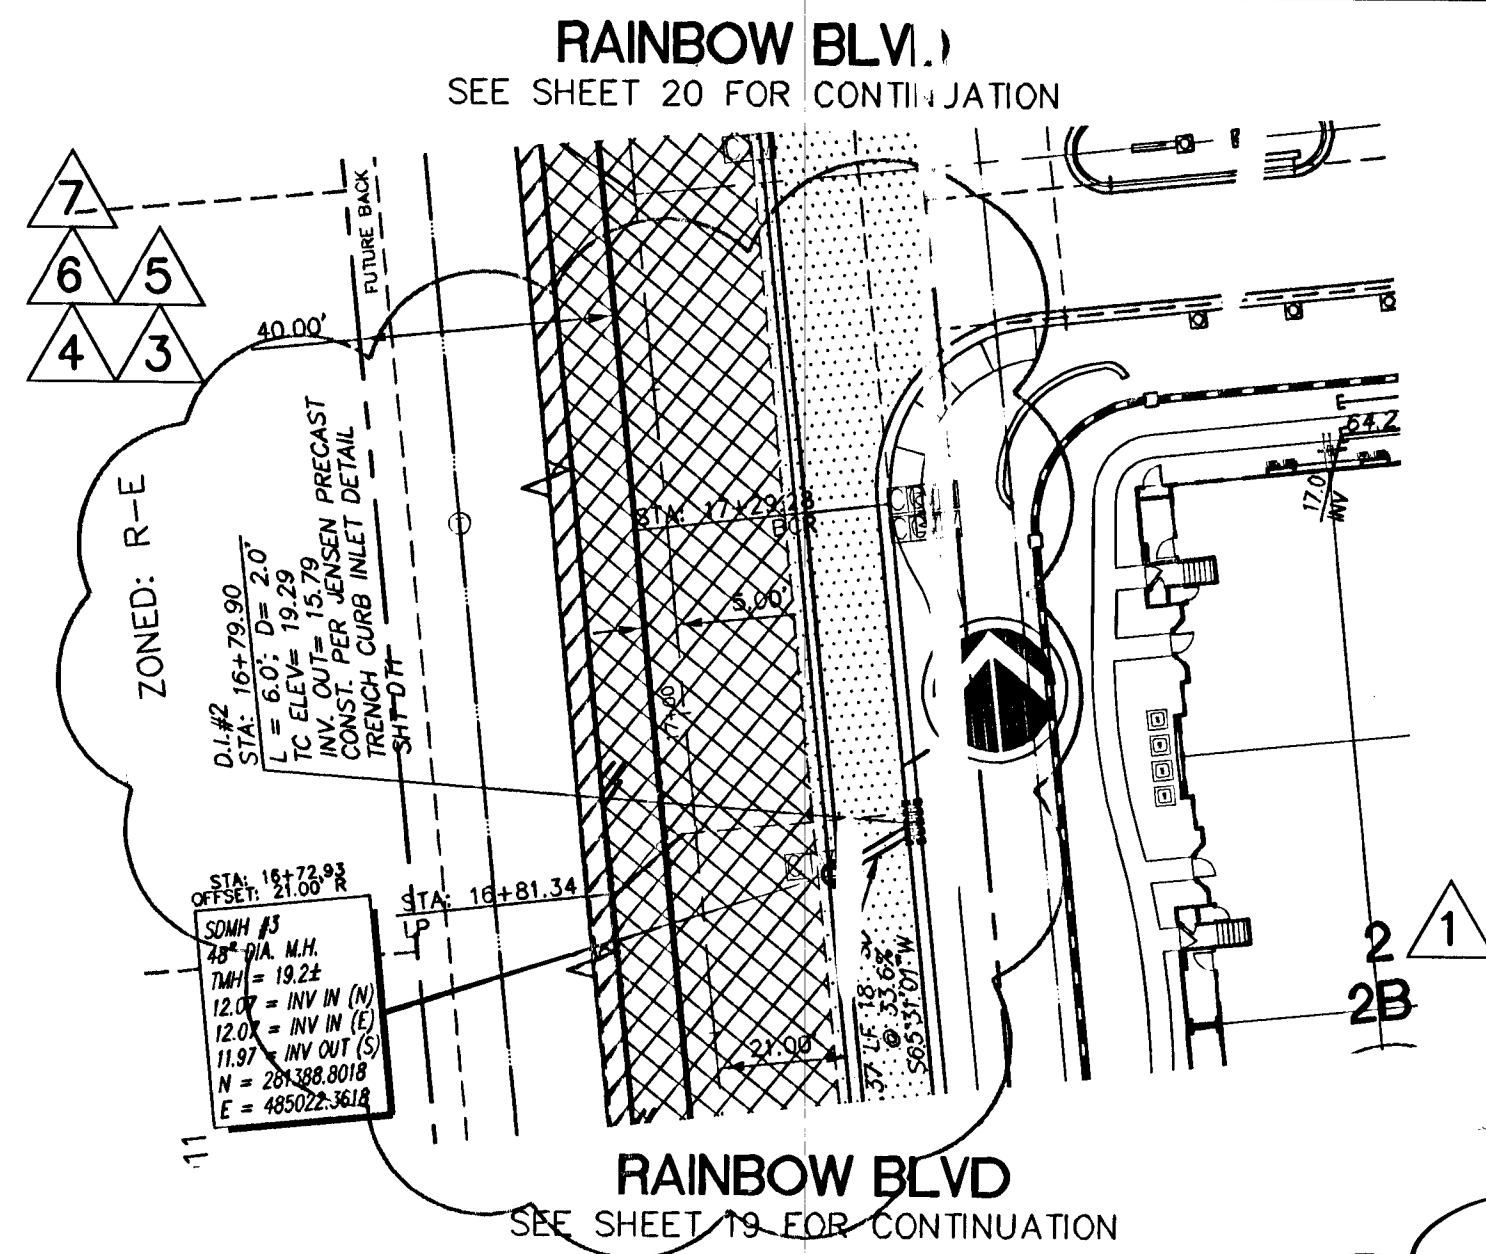
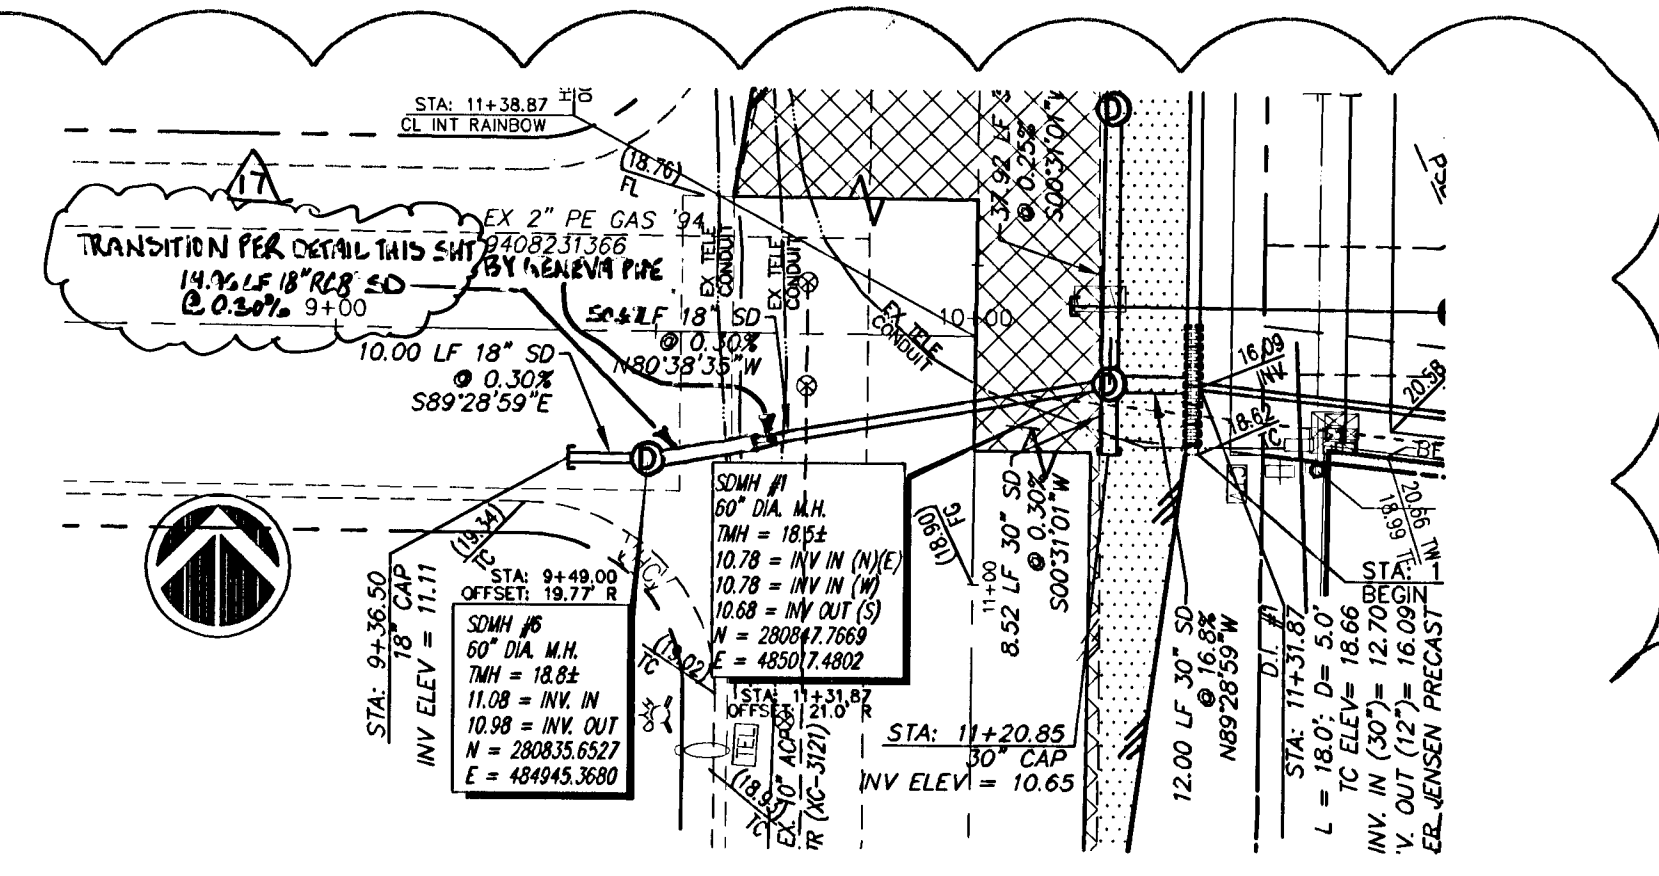
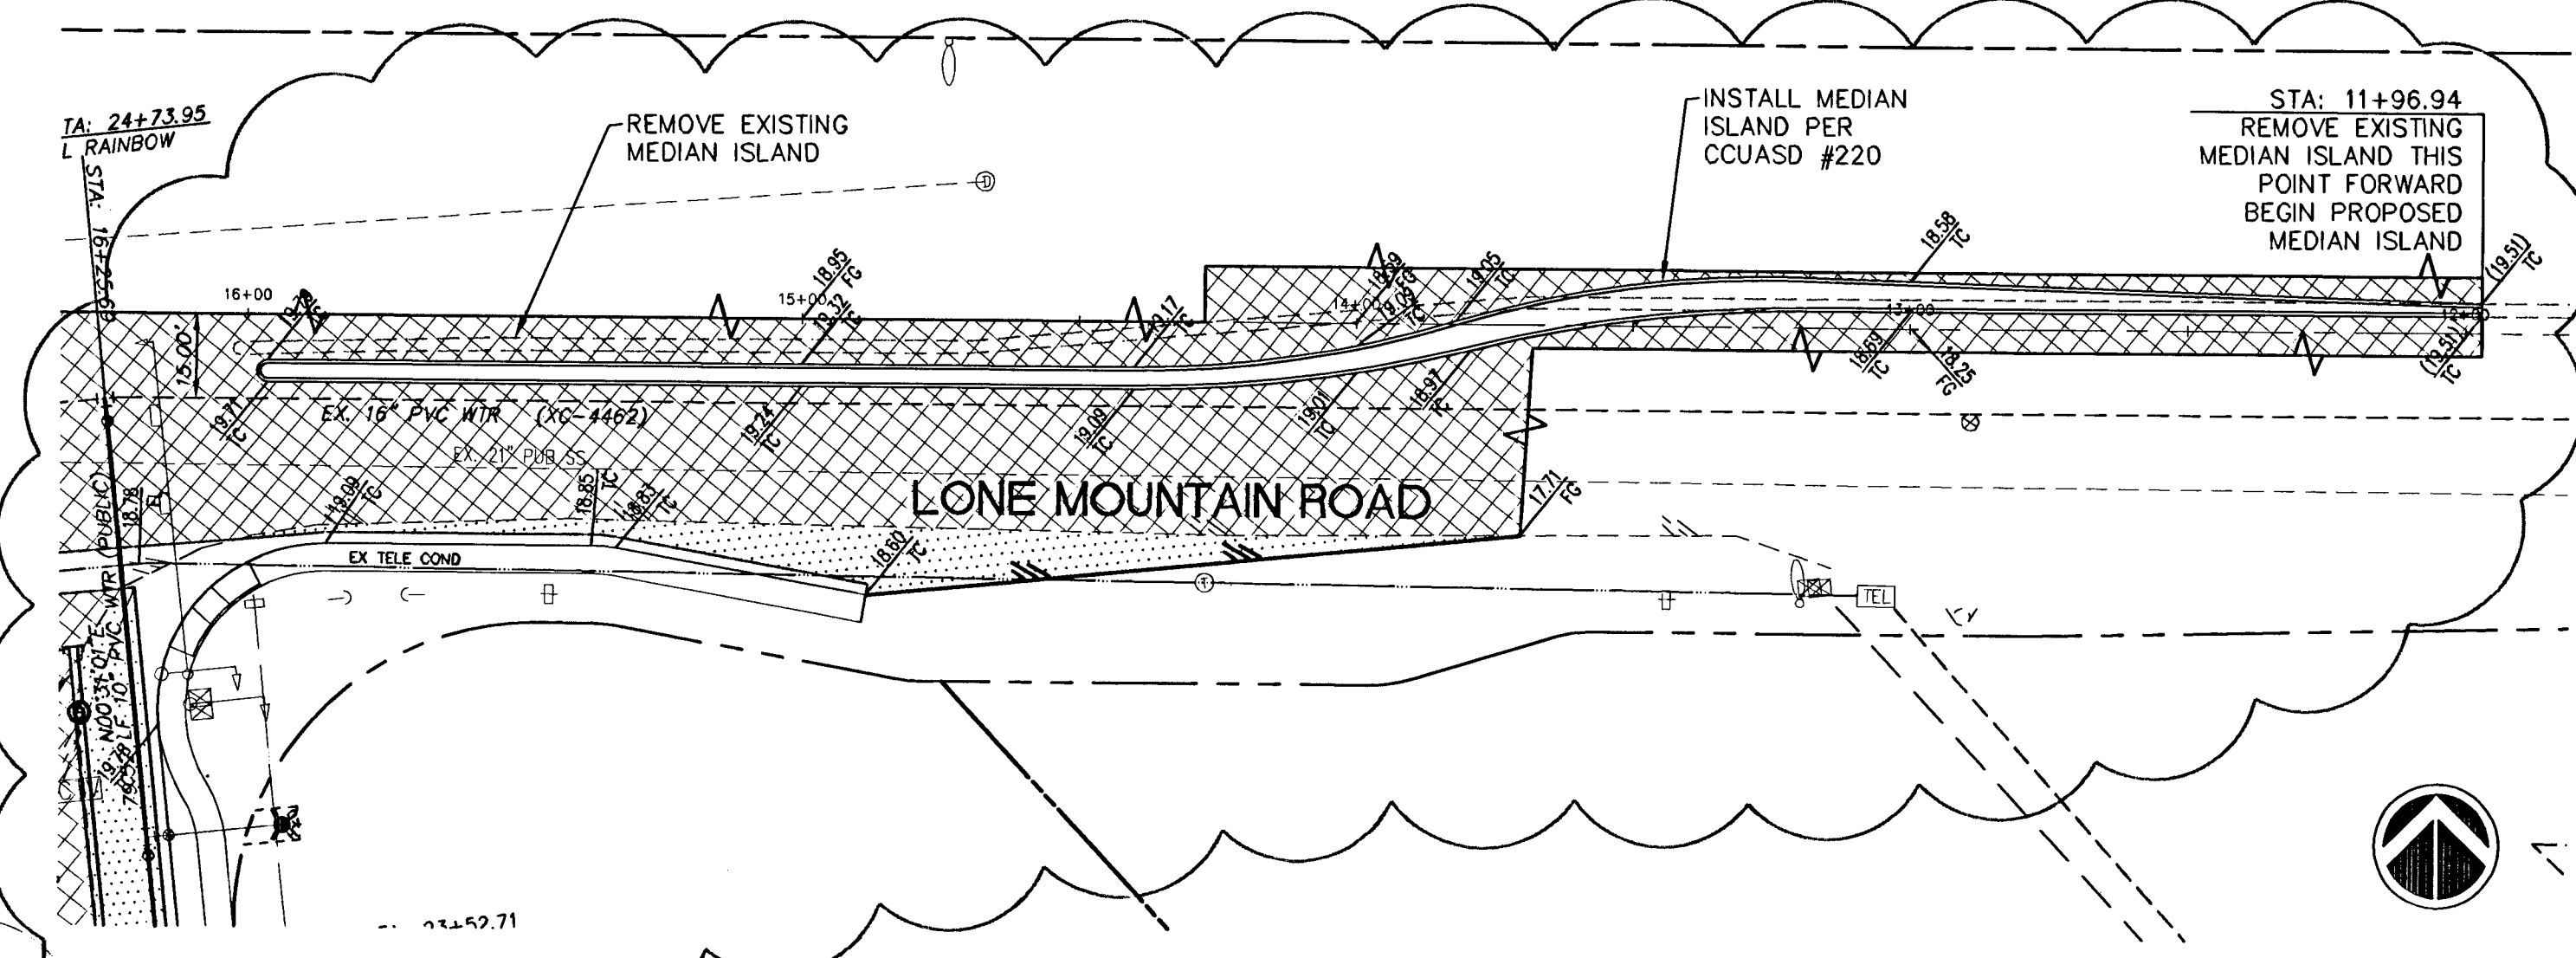


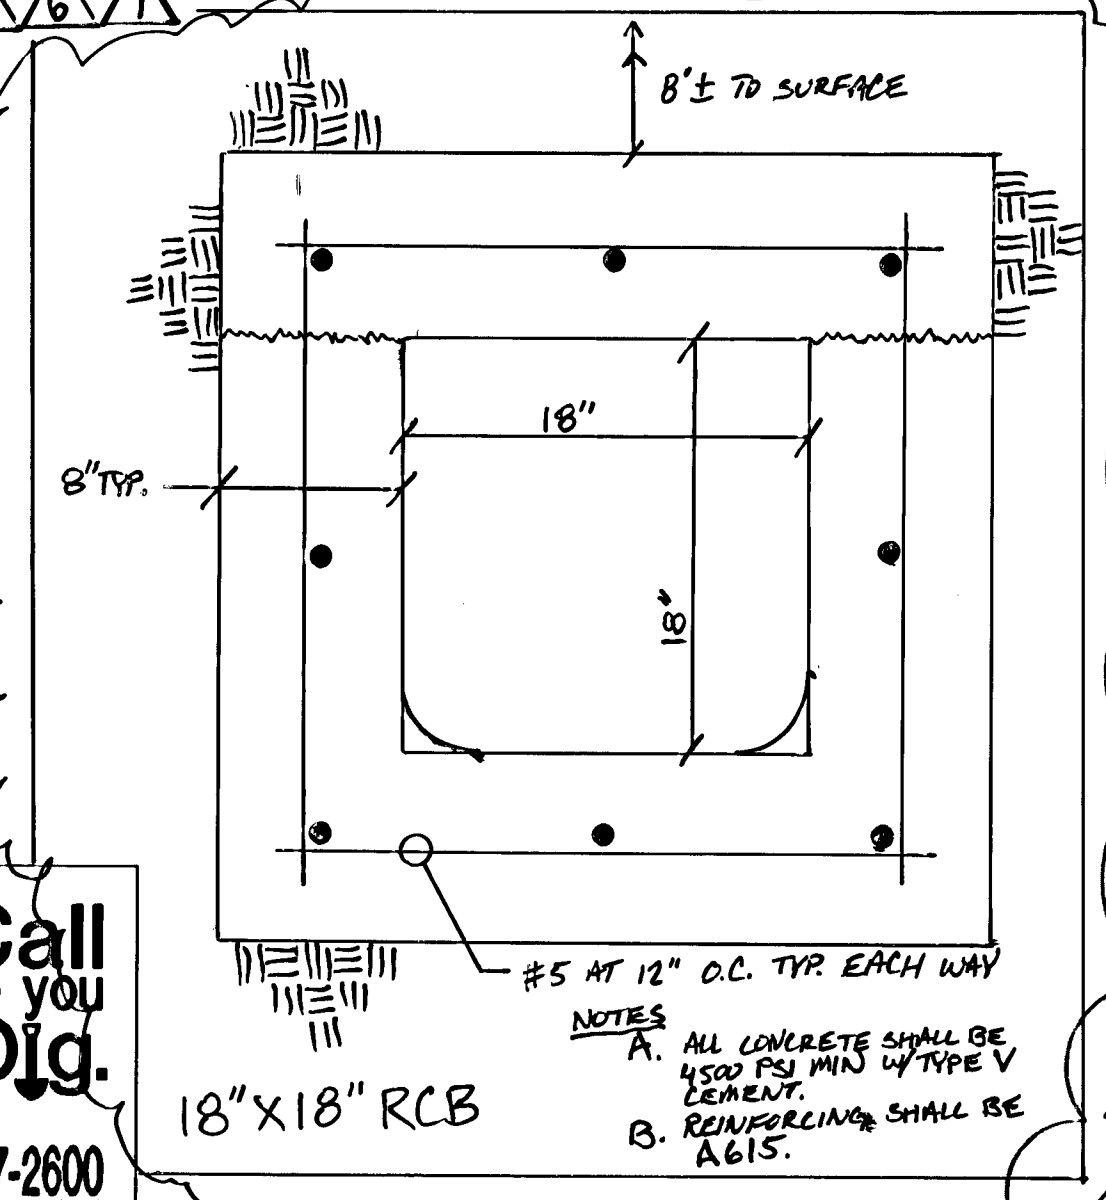

18" SD AND D.I. #2
PUBLIC STORM DRAIN

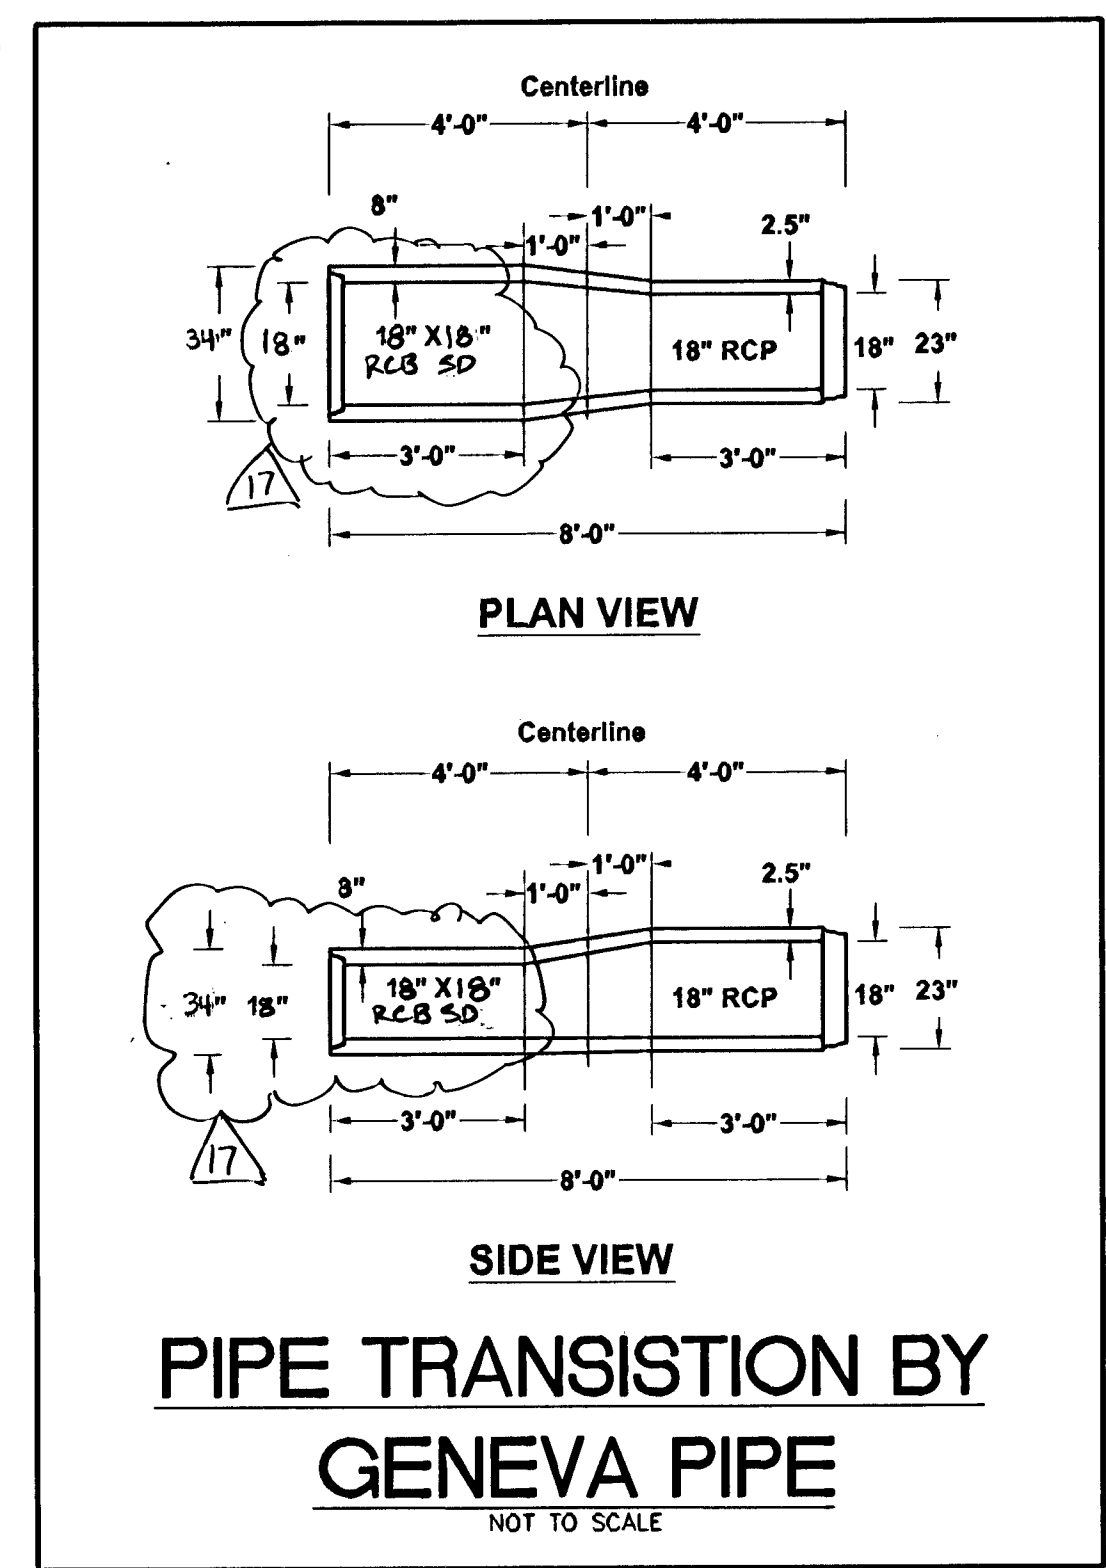

PROFILE SCALE:
HORIZONTAL: 1" = 30'
VERTICAL: 1" = 3'

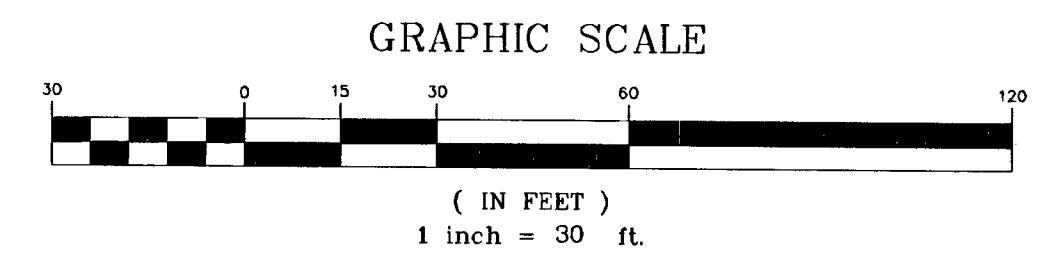


- LEGEND
- NEW AC
 - AC TO BE REMOVED AND REPLACED
 - AC TO BE REMOVED

BASIS OF BEARINGS:
THE BASIS OF BEARING FOR THIS SURVEY IS THE WESTERLY LINE OF THE NORTHWEST QUARTER (NW 1/4) OF SECTION 2, TOWNSHIP 20 SOUTH, RANGE 60 EAST, M.D.M., CITY OF LAS VEGAS, COUNTY OF CLARK, STATE OF NEVADA, WHICH BEARS NORTH 00°31'01" EAST, AS PER MAP RECORDED IN BOOK 105, PAGE 58 OF PLATS IN THE OFFICE OF THE COUNTY RECORDER OF SAID COUNTY.

BENCH MARK:
CITY OF LAS VEGAS BENCH MARK 1LV00 3NE66
CITY OF LAS VEGAS PIN AND PLATE IN THE TOP OF CURB, SOUTHWEST CORNER OF RAINBOW BOULEVARD AND RED COACH AVENUE NEAR THE PT OF RED COACH AVENUE
NAVD '88 DATUM
ELEVATION = 2319.021 U.S. SURVEY FEET
ELEVATION = 706.839 METERS

APPROVED FOR CONSTRUCTION
1ST APPROVED 11/15/05
LAS VEGAS VALLEY WATER DISTRICT

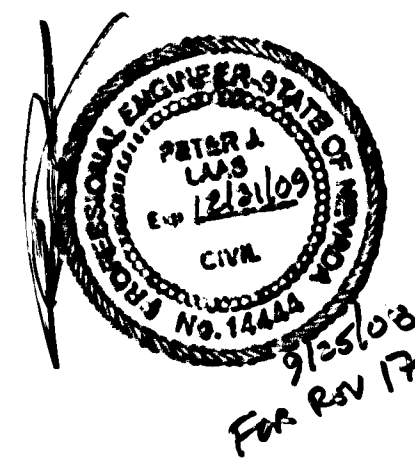

- REVISION
- | NO. | DATE | BY | DESCRIPTION |
|-----|---------|-----|---|
| 1 | 9/15/06 | JDR | CHANGE ELLIPTICAL SD TO R.C.B. AND ADD RCB DETAIL |
| 2 | 9/15/06 | JDR | ADD ELLIPTICAL SD RAINBOW AND RCB DETAIL |
| 3 | 10/9/06 | BK | MOVE BC ON RAINBOW 5' WEST, ADJUST AFFECTED IMPROVEMENTS, ADD ISLAND ON LONE MOUNTAIN - NB 11/21/06 |
| 4 | 11/4/07 | BK | ADJUST DRAIN INLETS TO ADD UTILITY CONFLICTS - NB 1/16/07 |
| 5 | 1/27/07 | BK | REMOVE PROFILE FOR SDH #6 AND #7, ADD RED COACH PROFILE |
| 6 | 1/26/05 | BK | CHANGE BULK NUMBERS - NB 1/1/05 |
| 7 | 1/12/06 | BK | MOVE FH SOUTH, MOVE FH BEHIND R.W. & ADD LVWD DETAIL |
| 8 | 1/17/06 | BK | 10' WTR PROFILE - SA/LVWD 3/1/06, NB 3/7/06 |
| 9 | 3/24/06 | BK | ADJUST SD & SD LATERALS, REMOVE SS, REMOVE WTR DP SECTION |
| 10 | 5/7/06 | BK | RAV/LVWD 5/4/06, NB 3/29/06 |
| 11 | 5/7/06 | BK | ADJUST 10' WTR TO ADD UTILITY CONFLICTS - SA/LVWD 5/4/06 |
| 12 | 5/7/06 | BK | ADJUST 10' WTR TO ADD UTILITY CONFLICTS - SA/LVWD 5/4/06 |

OFFSITE WORK

OVATION DEVELOPMENT
1175 AMERICAN PACIFIC DRIVE, SUITE F
HENDERSON, NEVADA 89074
CONTACT: JAN COYER (702) 990-2325

VPOINT
DESIGNING FOR THE FUTURE
PLANNERS • CONSULTING ENGINEERS • SURVEYORS
1009 WHITNEY RANCH DRIVE • HENDERSON, NEVADA 89014 • (702) 248-6415

STREET AND UTILITY PLAN AND PROFILE
LONE MOUNTAIN ROAD

LONE MOUNTAIN APARTMENTS

SHEET		TITLE	
DRAWN BY: REH	DESIGNED BY: REH	PROJECT NO: 662-E169	SCALE: 1" = 30' HOR.
CHECKED BY: P.J.L.	CHECKED BY: P.J.L.	DATE: 3-07-07	
APPROVED FOR CONSTRUCTION		SHEET 21 OF 41 SHEETS	
DRAWING NO: 107V4322			

CAUTION TO CONTRACTOR!
EXISTING UTILITY LOCATIONS SHOWN HEREON ARE APPROXIMATE ONLY. IT SHALL BE THE CONTRACTOR'S RESPONSIBILITY TO DETERMINE THE EXACT VERTICAL AND HORIZONTAL LOCATION OF ALL EXISTING UNDERGROUND UTILITIES PRIOR TO COMMENCING CONSTRUCTION. NO REPRESENTATION IS MADE THAT ALL EXISTING UTILITIES ARE SHOWN HEREON. THE ENGINEER ASSUMES NO RESPONSIBILITY FOR UTILITIES NOT SHOWN OR UTILITIES NOT SHOWN IN THEIR PROPER LOCATION.

1-702-593-6111
1-800-227-2600
UNDERGROUND SERVICE (USA)

Call before you Dig.
1-800-227-2600
UNDERGROUND SERVICE (USA)