
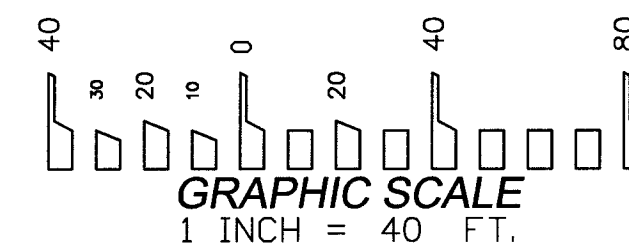


MONUMENT TIE MAP

LONE MOUNTAIN RIDGES - UNIT 8

CENTERLINE AND REFERENCE MONUMENTATION FOR LONE MOUNTAIN RIDGES - UNIT 8, RECORDED IN BOOK 119 OF PLATS, AT PAGE 31, OFFICIAL RECORDS OF CLARK COUNTY, NEVADA, LYING WITHIN THE SOUTHWEST QUARTER (SW 1/4) OF THE SOUTHEAST QUARTER (SE 1/4) OF SECTION 1, TOWNSHIP 20 SOUTH, RANGE 59 EAST, M.D.M., CITY OF LAS VEGAS, CLARK COUNTY, NEVADA.

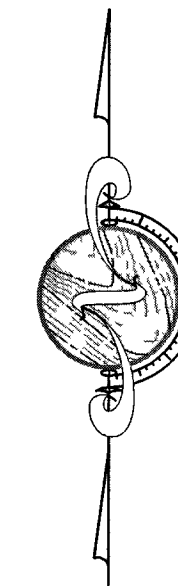


SURVEYOR'S CERTIFICATE

I, MICHAEL G. SMITH, A PROFESSIONAL LAND SURVEYOR, LICENSED IN THE STATE OF NEVADA, CERTIFY THAT:


- 1) THIS PLAT REPRESENTS THE RESULT OF A SURVEY CONDUCTED UNDER MY DIRECT SUPERVISION AT THE INSTANCE OF RICHMOND AMERICAN HOMES OF NEVADA, INC., A COLORADO CORPORATION.
- 2) THE LANDS SURVEYED LIE WITHIN THE SOUTHWEST QUARTER (SW 1/4) OF THE SOUTHEAST QUARTER (SE 1/4) OF SECTION 1, TOWNSHIP 20 SOUTH, RANGE 59 EAST, M.D.M., CITY OF LAS VEGAS, CLARK COUNTY, NEVADA AND THAT THE SURVEY WAS COMPLETED ON OCTOBER 31, 2007.
- 3) THE MONUMENTS DEPICTED ON THE PLAT ARE OF THE CHARACTER SHOWN, OCCUPY THE POSITIONS INDICATED AND ARE OF SUFFICIENT NUMBER AND DURABILITY.
- 4) THIS RECORD OF SURVEY DOES NOT CONSTITUTE A SUBDIVISION AS DEFINED BY THE NEVADA REVISED STATUTES (NRS).

MICHAEL G. SMITH, PLS
PROFESSIONAL LAND SURVEYOR
NEVADA LICENSE NO. 16201

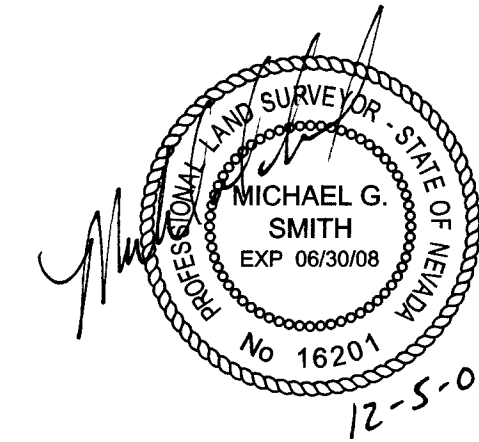

LEGEND

	SUBDIVISION BOUNDARY LINE
	STREET CENTERLINE
	SECTION LINE
	LOT LINE
	EXISTING RIGHT-OF-WAY
	SURVEY TIE LINE
	SET 5/8" REBAR WITH ALUMINUM CAP STAMPED "PLS 16201"
	SET TYPE IV REFERENCE MONUMENT IN TOP OF CURB STAMPED "PLS 16201"
	FOUND TYPE IV REFERENCE MONUMENT IN TOP OF CURB STAMPED "PLS 12469"
	LOT NUMBER

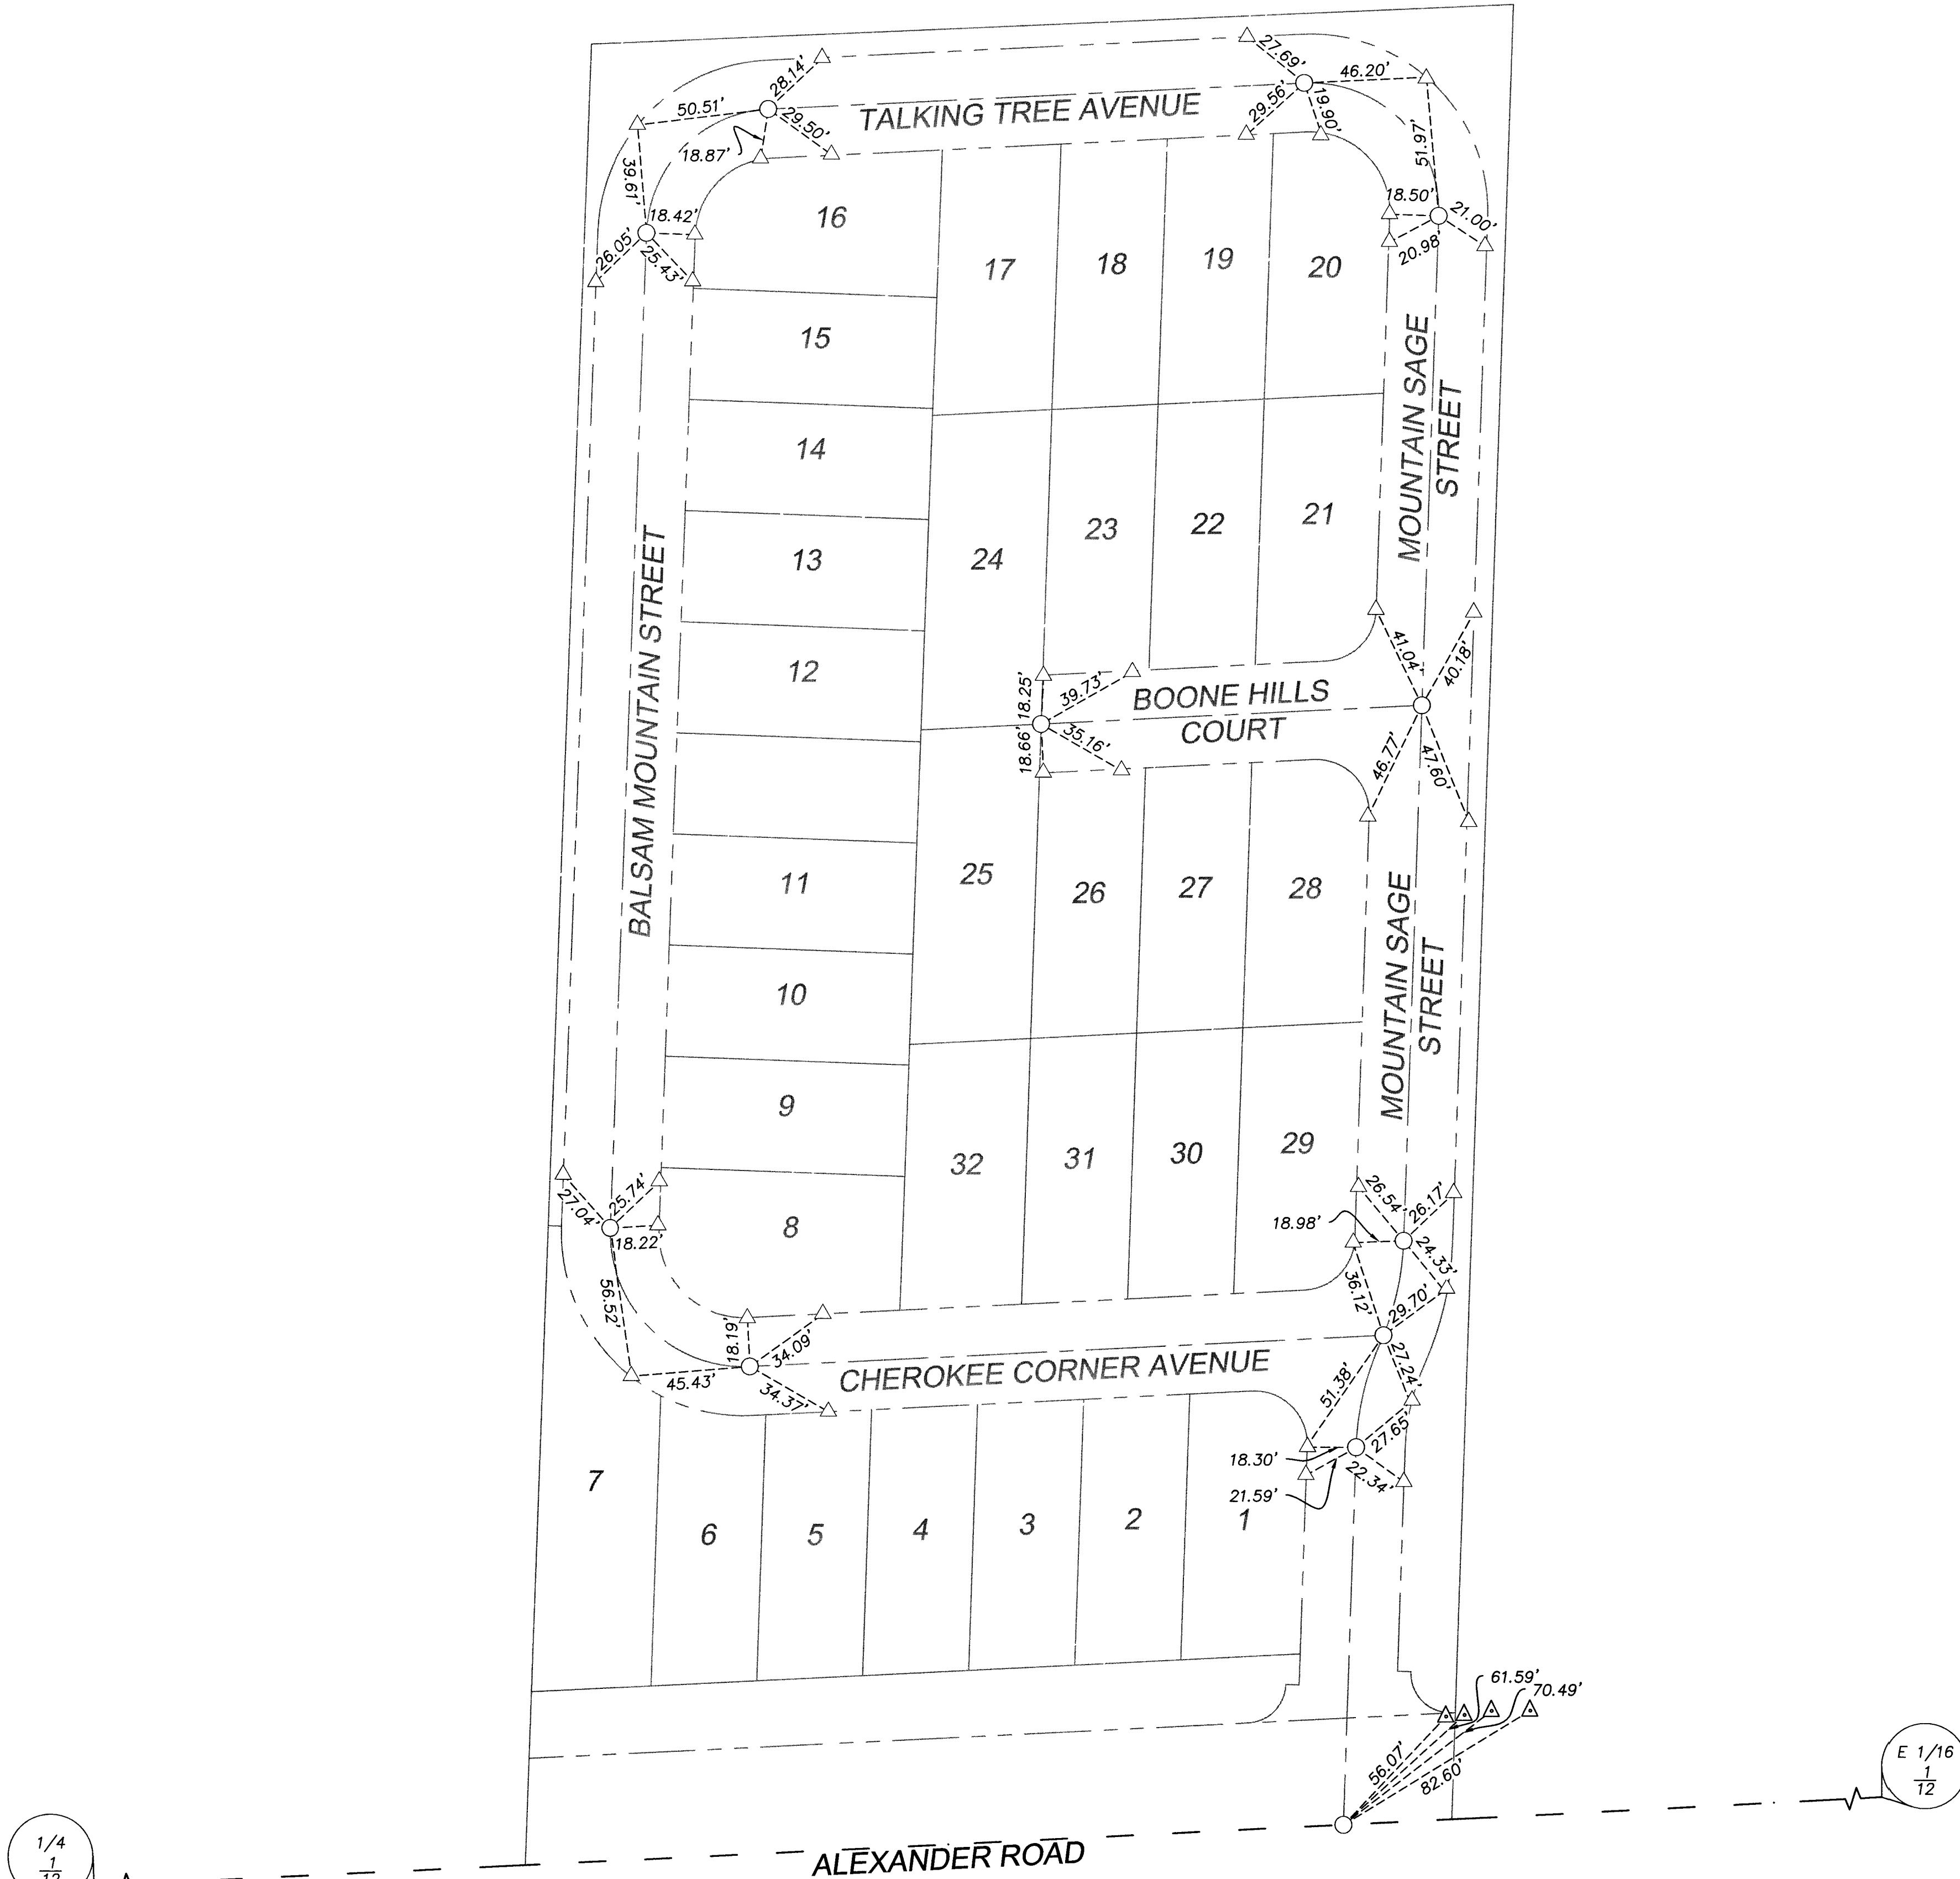

1/4
1
12

11/739

MSG Surveying 3277 E. WARM SPRINGS RD., SUITE 300 LAS VEGAS, NEVADA 89120 PHONE: (702) 932-2965 FAX: (702) 932-5599 HTTP://WWW.MSGSURVEYING.COM		Date: 27-SEPT-07
		Drawn By: D ENGELSEN
		Checked By: J SANTOS
		Job Number: 001-07-021
Sheet No. 1 OF 1		