


JONES/HORSE AT IRON MOUNTAIN RANCH

MONUMENTATION TIE MAP

(A COMMON INTEREST COMMUNITY)
BEING A SUBDIVISION OF THE NORTH HALF (N 1/2) OF THE SOUTHWEST QUARTER (SW 1/4) OF THE NORTHWEST QUARTER
(NW 1/4) OF SECTION 12, TOWNSHIP 19 SOUTH, RANGE 60 EAST, M.D.M., CITY OF LAS VEGAS, CLARK COUNTY, NEVADA.

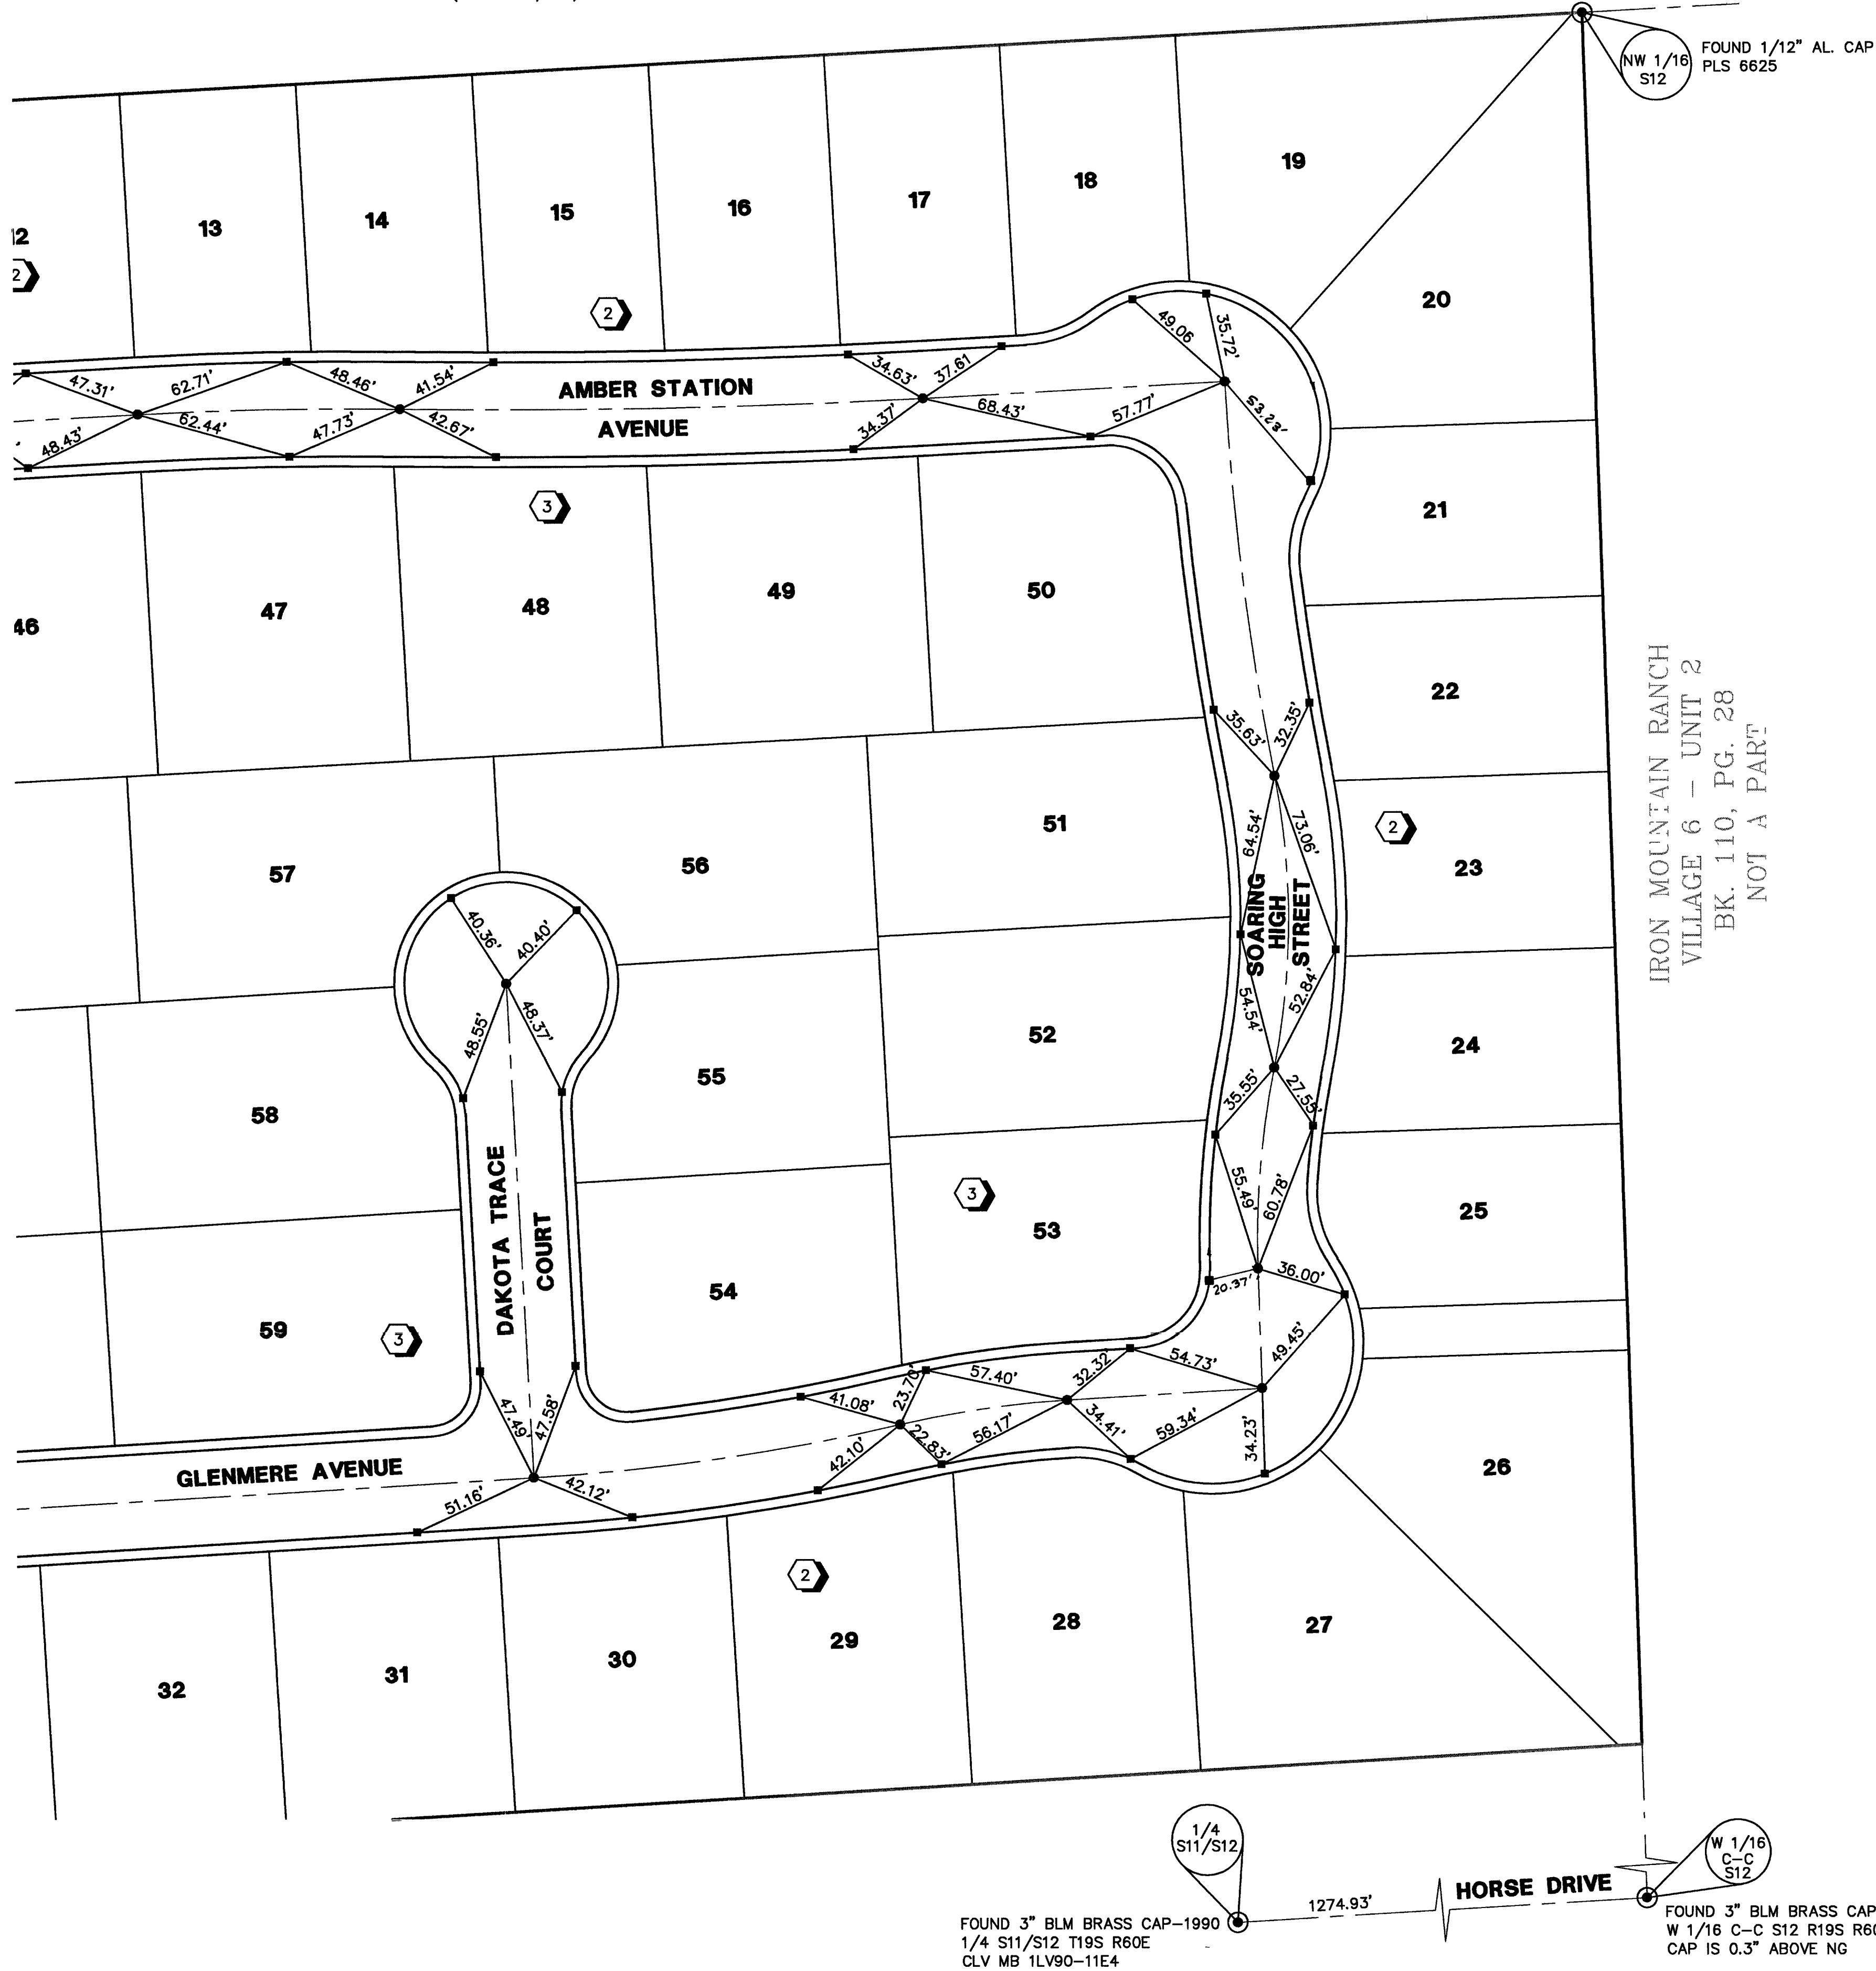

FOR CONTINUATION SEE SHEET 1 OF 2

102401

NOTES

SEE FINAL MAP FOR BEARING AND DISTANCES
(BOOK 113, PAGE 0067)

LEGEND

- 2** LOT NUMBER
 _____ LOT LINES
 _____ SUBDIVISION BOUNDARY LINE
 _____ - _____ STREET CENTERLINE
 _____ BACK OF CURB LINE
- TYPE III MONUMENT - 5/8" REBAR AND
 ALL CAP STAMPED "VTN PLB 11449" WITH REFERENCE
 MONUMENTS IN TOP OF CURB
 PER BOOK 113, PAGE 0067
- TYPE IV-A REFERENCE MONUMENTS STAMPED
 "VTN PLB 11449" IN TOP OF CURB
 PER BOOK 113, PAGE 0067
- ◎ FOUND AS DESCRIBED

PAGE 2 OF 2

1258-4771