


1/4 S 35
S 2
FOUND BRASS CAP IN
WELL MONUMENT.

S83°42'20"E
1229.25'
LONE MOUNTAIN ROAD

FOUND ALUMINUM CAP
MARKED 'ESI' FOR THE NORTHEAST
CORNER OF GOVERNMENT LOT 2
PLS # ILLEGIBLE

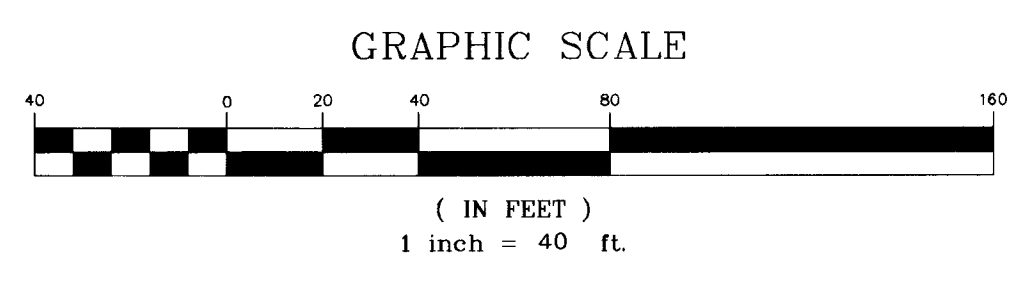

TORREY PINES DRIVE
698.88'
N00°03'35"E
673.23'

APN 138-02-501-005
SCHERADO K W JR & P A REV LIV TR
BOOK 20010904 DOC. # 01504

APN 138-02-501-006
SARDINAS UBALDO J SR & UBALDO JR
BOOK 860522 DOC. #00304

APN 138-02-501-007
GLENN DWAYNE A & DONNA L
BOOK 910711 DOC. #00073

APN 138-02-501-004
CHURCH BAPTIST MACEDONIA
BOOK 931129 DOC. #00535

APN 138-02-501-008
SANCHEZ FRED & BEATRICE
BOOK 0605 DOC. #048615

FOUND ALUMINUM CAP
ILLEGIBLE
344.16'
572.17'
228.01'
616.02'
SET NAIL PER
REFERENCES

FOUND ALUMINUM CAP
ILLEGIBLE

THISTLE LANDING
STREET

231.01'
N83°44'44"W
KRAFT AVENUE
1232.05'
51.05'
51.98'
43.19'
231.01'


EAGLE TRACE UNIT B
PLAT BOOK 67, PAGE 50
CLARK COUNTY RECORDS

34.59'
22.90'
131.11'
FOUND ALUMINUM
CAP,
ILLEGIBLE
WINDY HOLLOW
STREET


LEGEND

- FOUND MONUMENT AS INDICATED
- CENTER LINE
- RIGHT OF WAY
- ADJACENT LOT LINE
- PROPERTY LINE
- SUBDIVISION BOUNDARY LINE
- SET TYPE III ALUMINUM CAP PLS # 9108
OR AS NOTED
- CALCULATED POINT
- SET REFERENCE MONUMENT WITH TIE DISTANCE
IN BACK OF CURB.
- BLOCK NUMBER

I, MORDECHAI KLEINBERG, A LICENSED PROFESSIONAL LAND SURVEYOR
IN THE STATE OF NEVADA, DO HEREBY CERTIFY THAT THE MONUMENTS
HAVE BEEN SET AND THE TIE DISTANCES ESTABLISHED AS SHOWN HEREON.
THIS SURVEY WAS COMPLETED ON 12-19-2003.

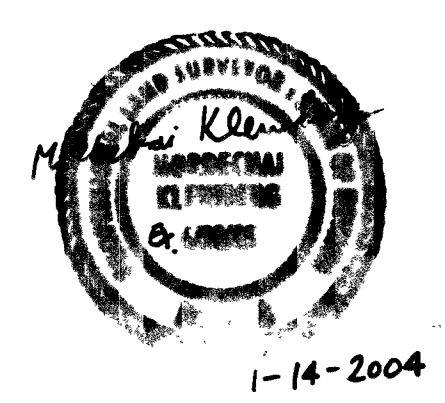

WRIGHT CIVIL ENGINEERS, INC
7425 PEAK DRIVE
LAS VEGAS, NEVADA 89128
TEL (702) 933-7000 FAX (702) 933-7001
CIVIL STRUCTURAL LAND SURVEYING

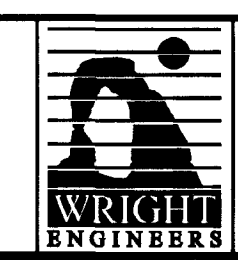

MONUMENTATION TIE MAP
FOR
KRAFT COURT 058-4772
A 10 LOT RESIDENTIAL SUBDIVISION
RECORDED IN PLAT FILE 113 PAGE 0019

63774