


LONE MOUNTAIN / CLIFF SHADOWS - UNIT 1


RECORDED IN BOOK 121, PAGE 82 OF PLATS IN THE OFFICE OF THE COUNTY RECORDER, CLARK COUNTY, NEVADA. LYING WITHIN THE NORTH HALF (N 1/2) OF NORTHWEST QUARTER (NW 1/4) OF SECTION 1, TOWNSHIP 20 SOUTH, RANGE 59 EAST, M.D.M., CITY OF LAS VEGAS, CLARK COUNTY, NEVADA

LONE MOUNTAIN ROAD
UNABLE TO SET HALF STREET WITH BARRIER RAIL ON CENTERLINE
N89°58'50"E (BASIS OF BEARINGS)

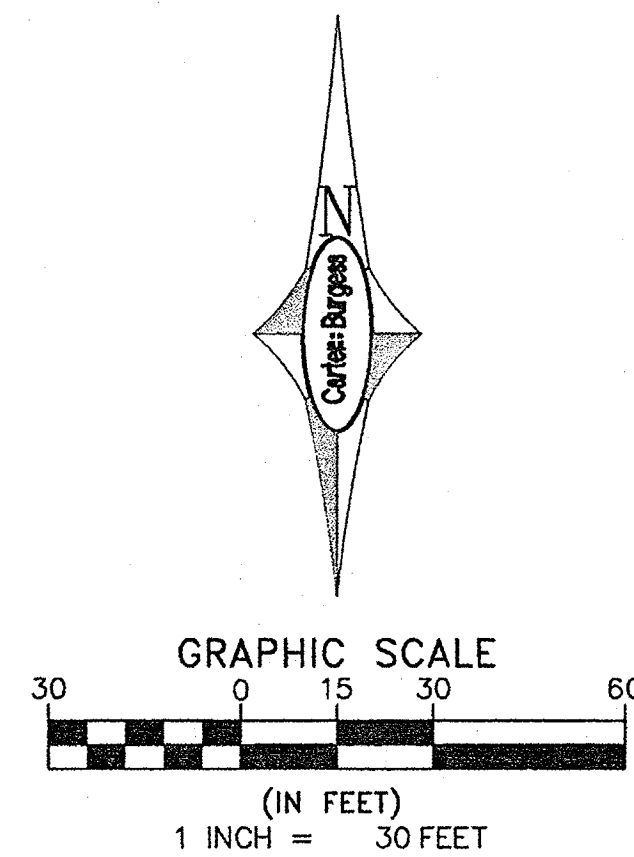

LEGEND

- SUBDIVISION BOUNDARY LINE
- RIGHT-OF-WAY LINE STREET
- CENTERLINE
- LOT LINE
- 17/CE-A LOT NUMBER/COMMON ELEMENT PER BOOK 121, PAGE 82 OF PLATS
- TYPE III MONUMENTS SET PER PER BOOK 121, PAGE 82 OF PLATS STAMPED PLS 8352 UNLESS OTHERWISE NOTED
- TYPE IV MONUMENTS SET PER BOOK 121, PAGE 82 OF PLATS STAMPED PLS 8352
- MONUMENT AS DESCRIBED

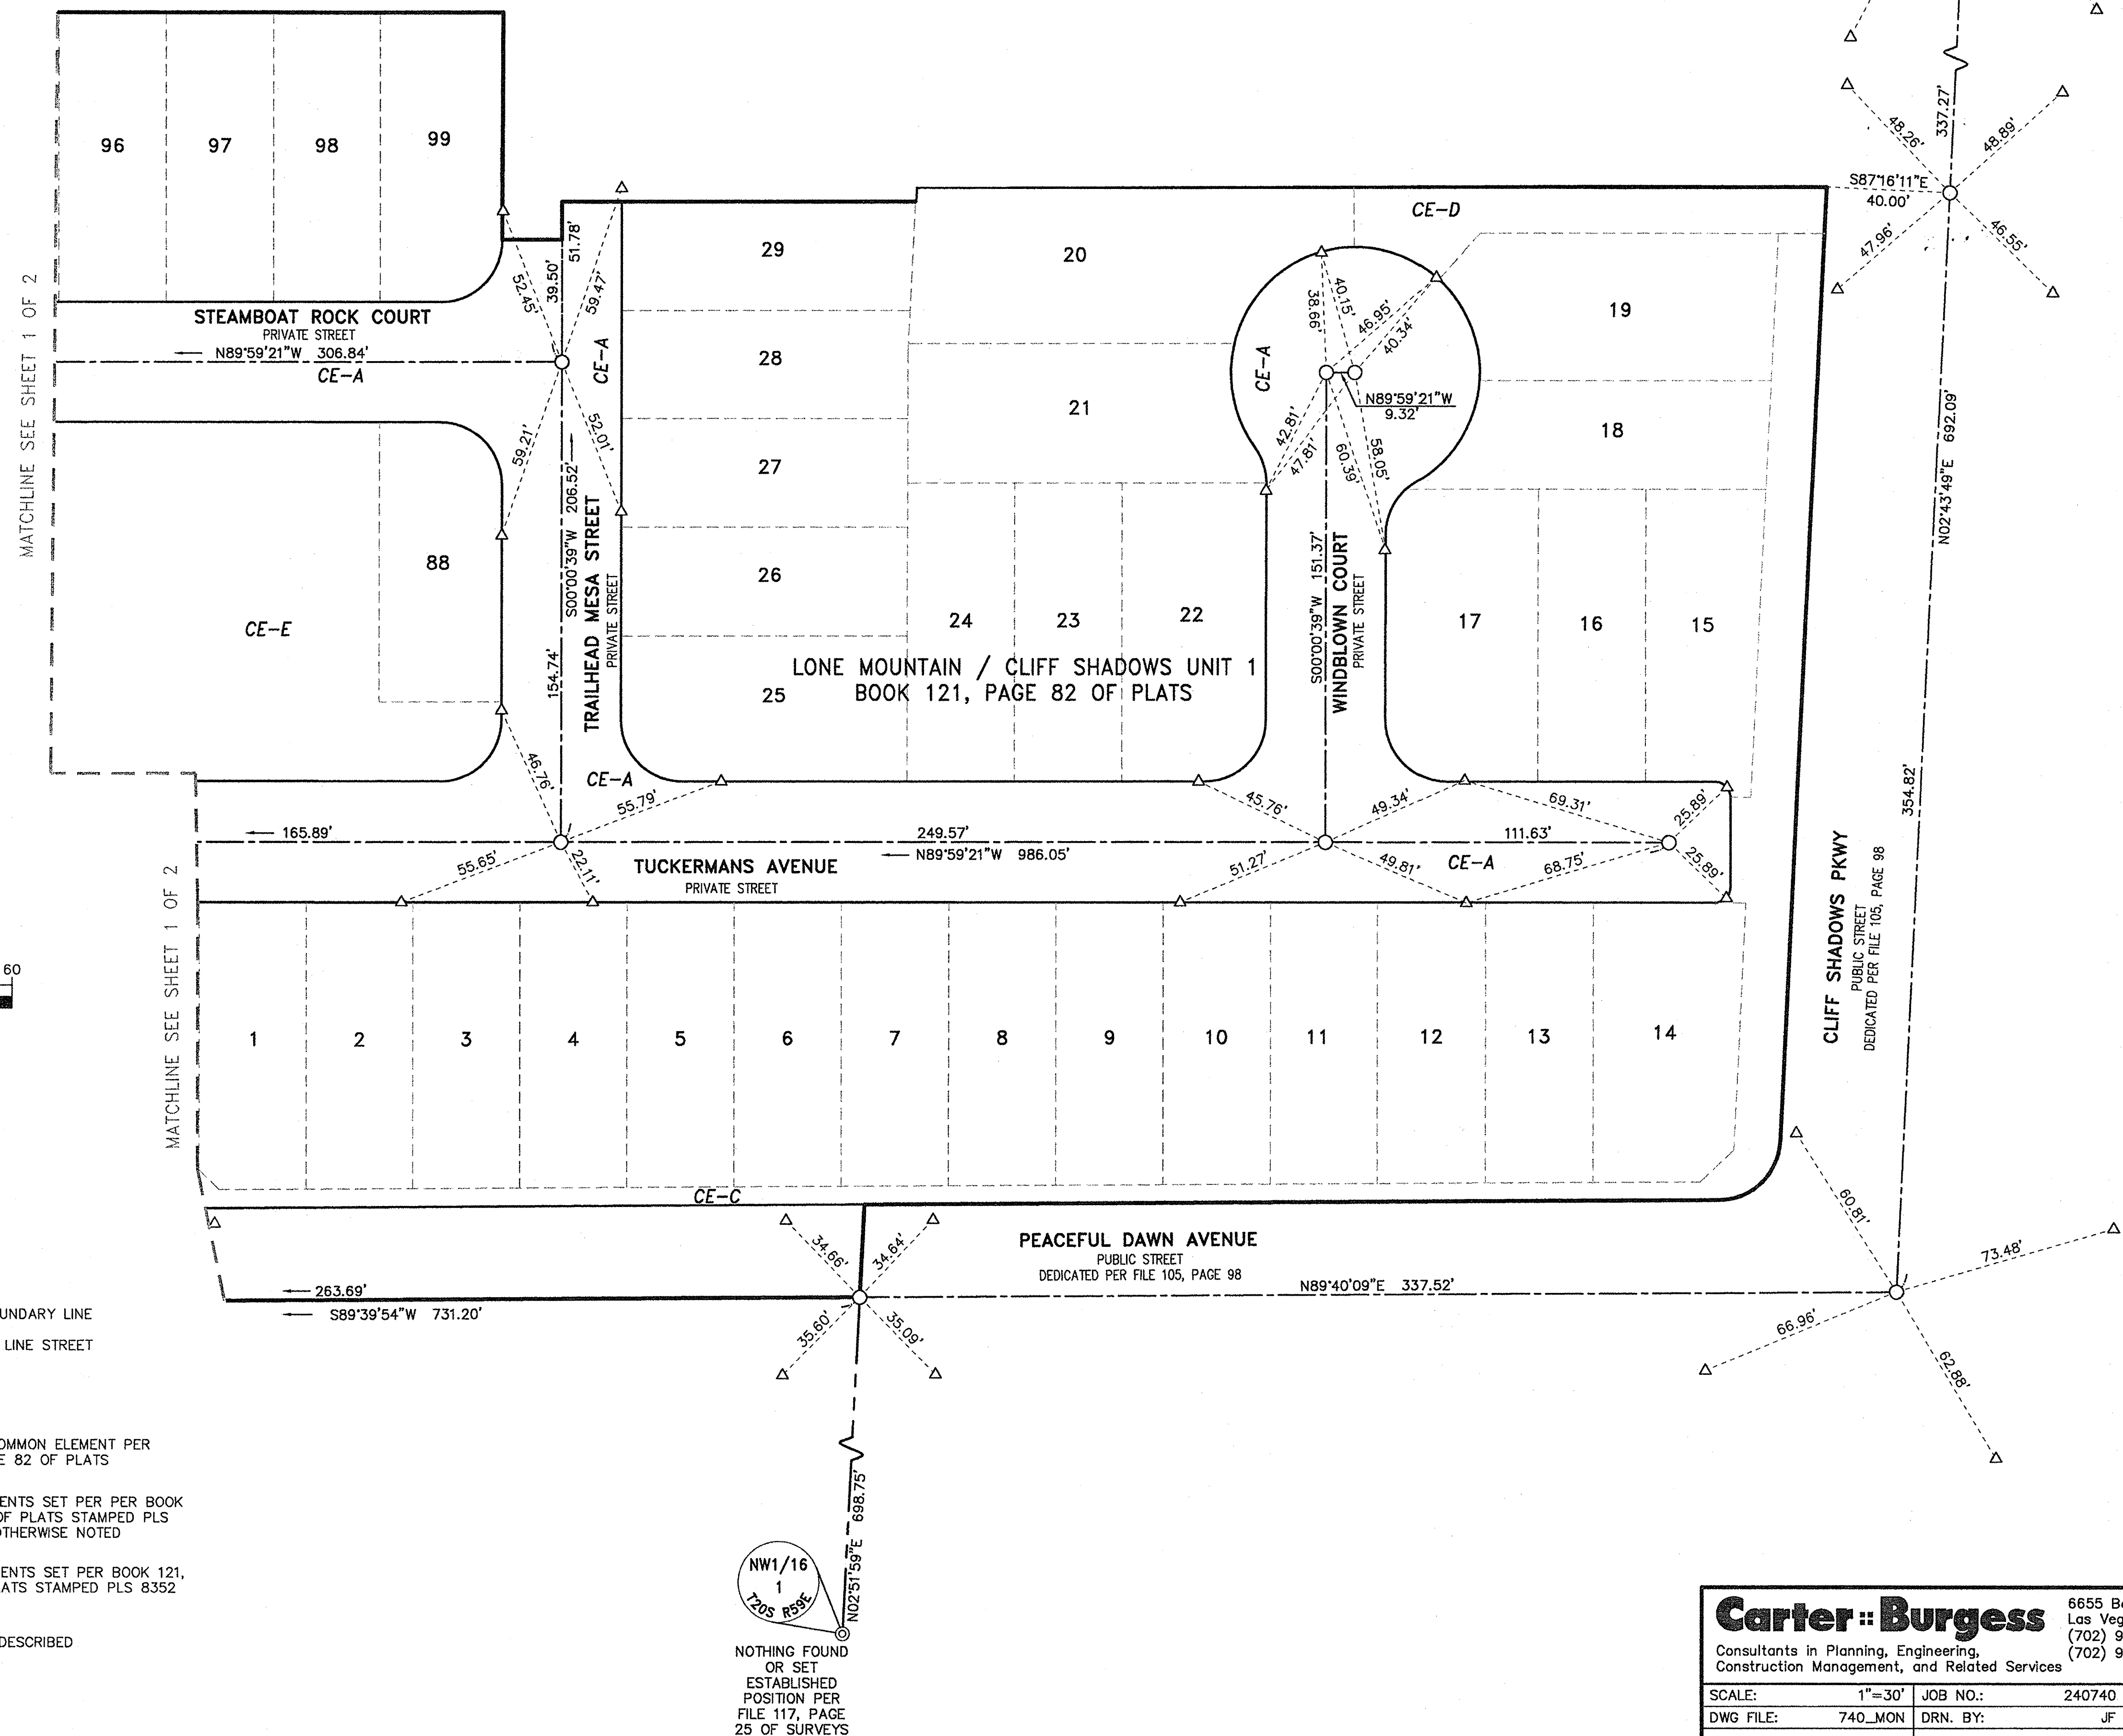

Carter Burgess
6655 Bermuda Road
Las Vegas, Nevada 89119
(702) 938-5400
(702) 938-5454

Consultants in Planning, Engineering, Construction Management, and Related Services

SCALE: 1"=30'	JOB NO.: 240740	SHEET	OF
DWG FILE: 740_MON	DRN. BY: JF	2	2
DATE: AUGUST 2007	CKD. BY: BB		

109220

058-4844-1