



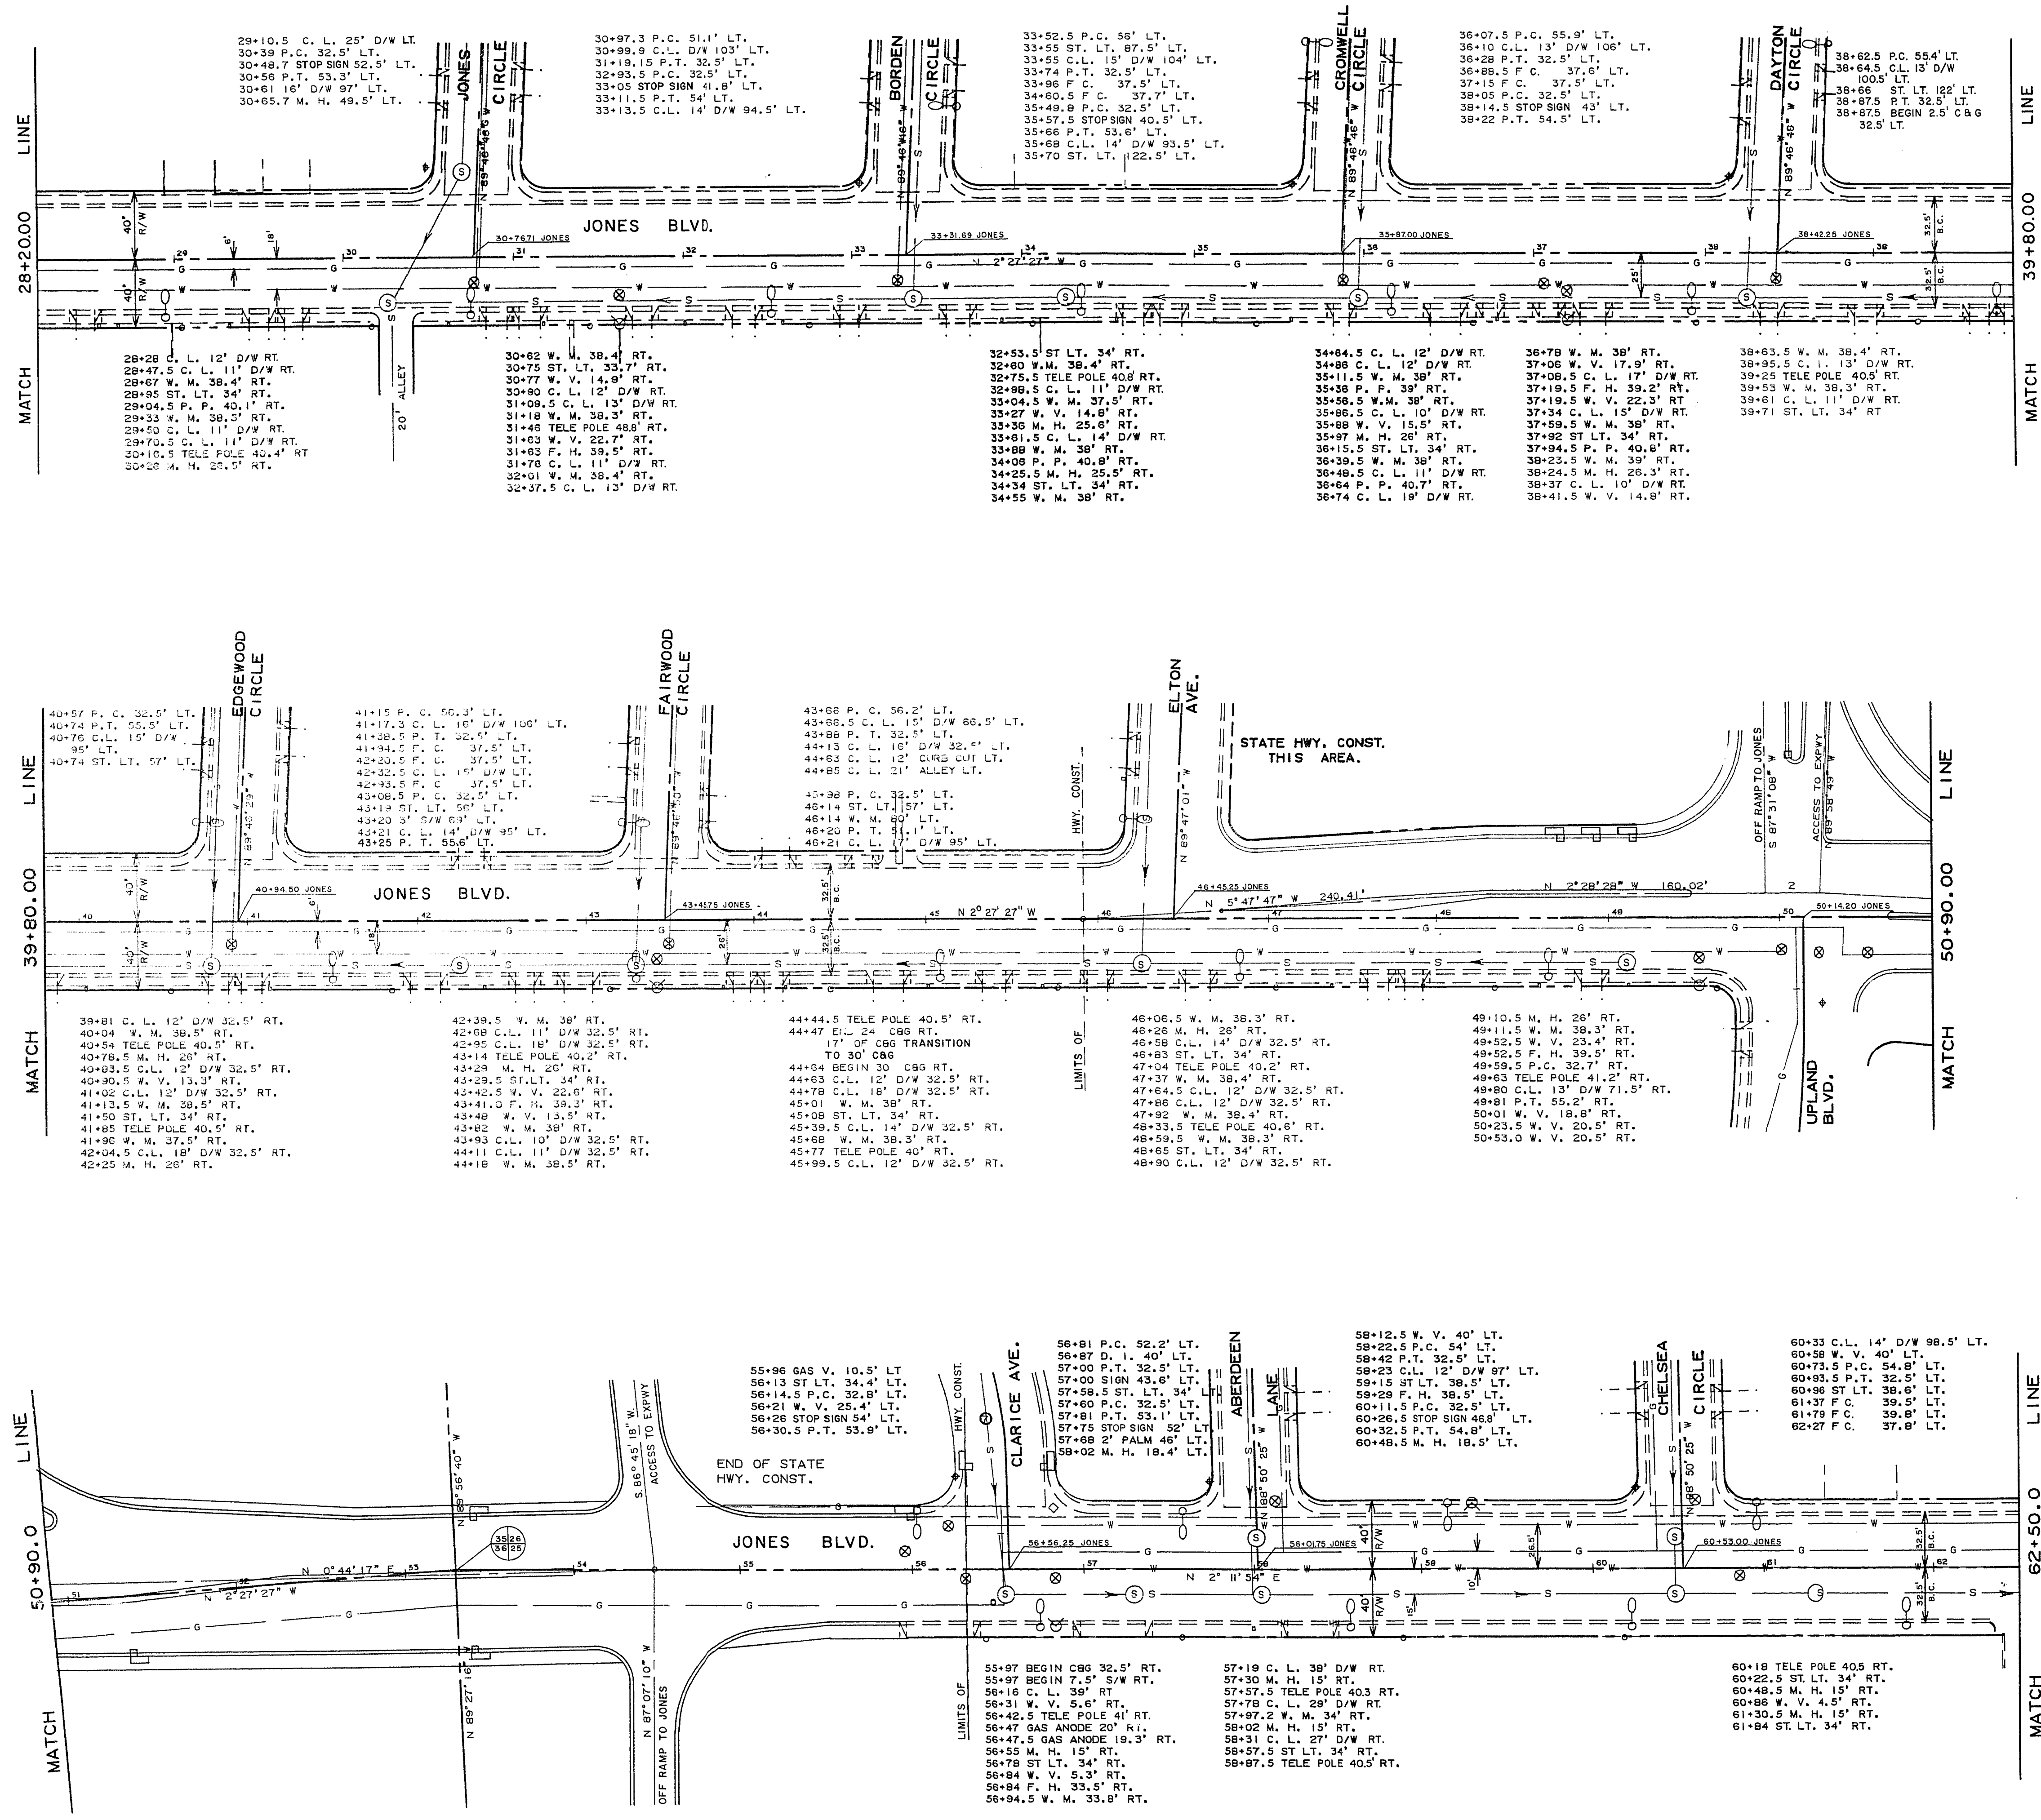

LEGEND	
C&G	CURB AND GUTTER
CL	CENTER LINE
DI	DROP INLET
D/W	DRIVEWAY
FC	FENCE CORNER
FH	FIRE HYDRANT
M.H.	MANHOLE
P.C.	POINT OF CURVE
P.P.	POWER POLE
P.T.	POINT OF TANGENT
ST.LT.	STREET LIGHT
S/W	SIDEWALK
TELE POLE	TELEPHONE POLE
WM	WATER METER
W.V.	WATER VALVE

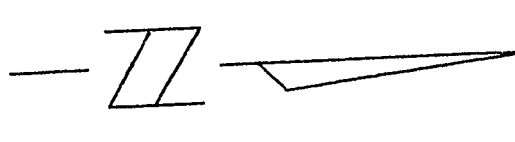

ALL UTILITIES ARE LOCATED ON THE PLANS
AND ARE NOT TO BE DELETED OR MOVED
UNLESS SPECIFICALLY NOTED OTHERWISE
ON THE PLANS OR IN THE FIELD BOOKS

Department of Public Services

Engineering Design Division

ABOVE GROUND
CONSTRUCTION FEATURES &
UNDERGROUND UTILITIES

JONES BLVD.
CHARLESTON BLVD.
TO
SMOKE RANCH ROAD



Drawing no.
107-V948A

25

68

W.O. no. 7694

Scale (V)
Date

Design by L.J. ROHN

Drawn by CALCOMP

Approved by the Director of Public Services
William J. Rohn

12/1/79

Revisions

Date

FEB. 2, 1979