



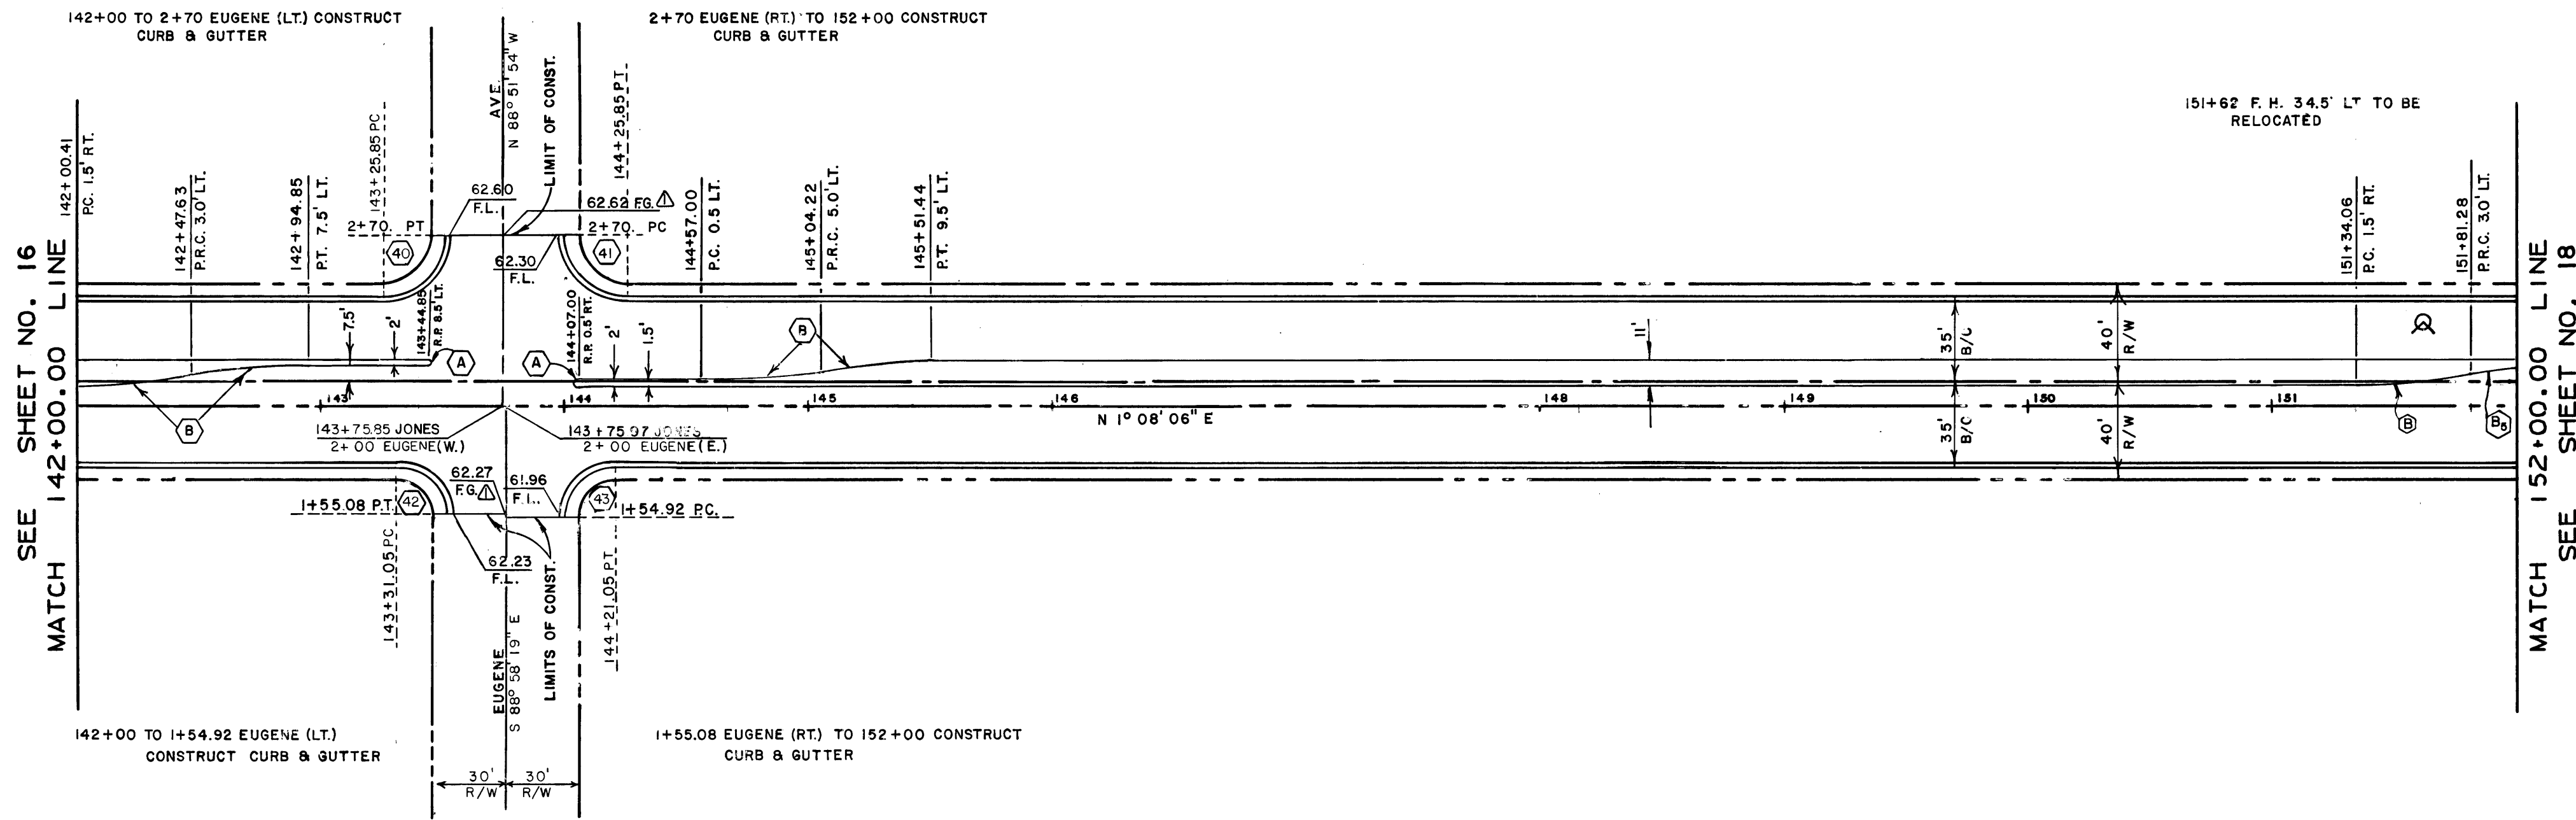

CURVE DATA					
NO.	LOC.	DELTA	RADIUS	TANGENT	LENGTH
A	ISL	180° 00' 00"	1.00'		3.14'
B	ISL	10° 53' 15"	250.00'	23.87'	47.51'
B	ISL	4° 20' 29"	250.00'	9.48'	18.94'
40	BC	90° 00' 00"	25.00'	25.00'	39.27'
41	BC	90° 00' 00"	25.00'	25.00'	39.27'
42	BC	89° 53' 35"	20.00'	19.96'	31.38'
43	BC	90° 06' 25"	20.00'	20.04'	31.45'

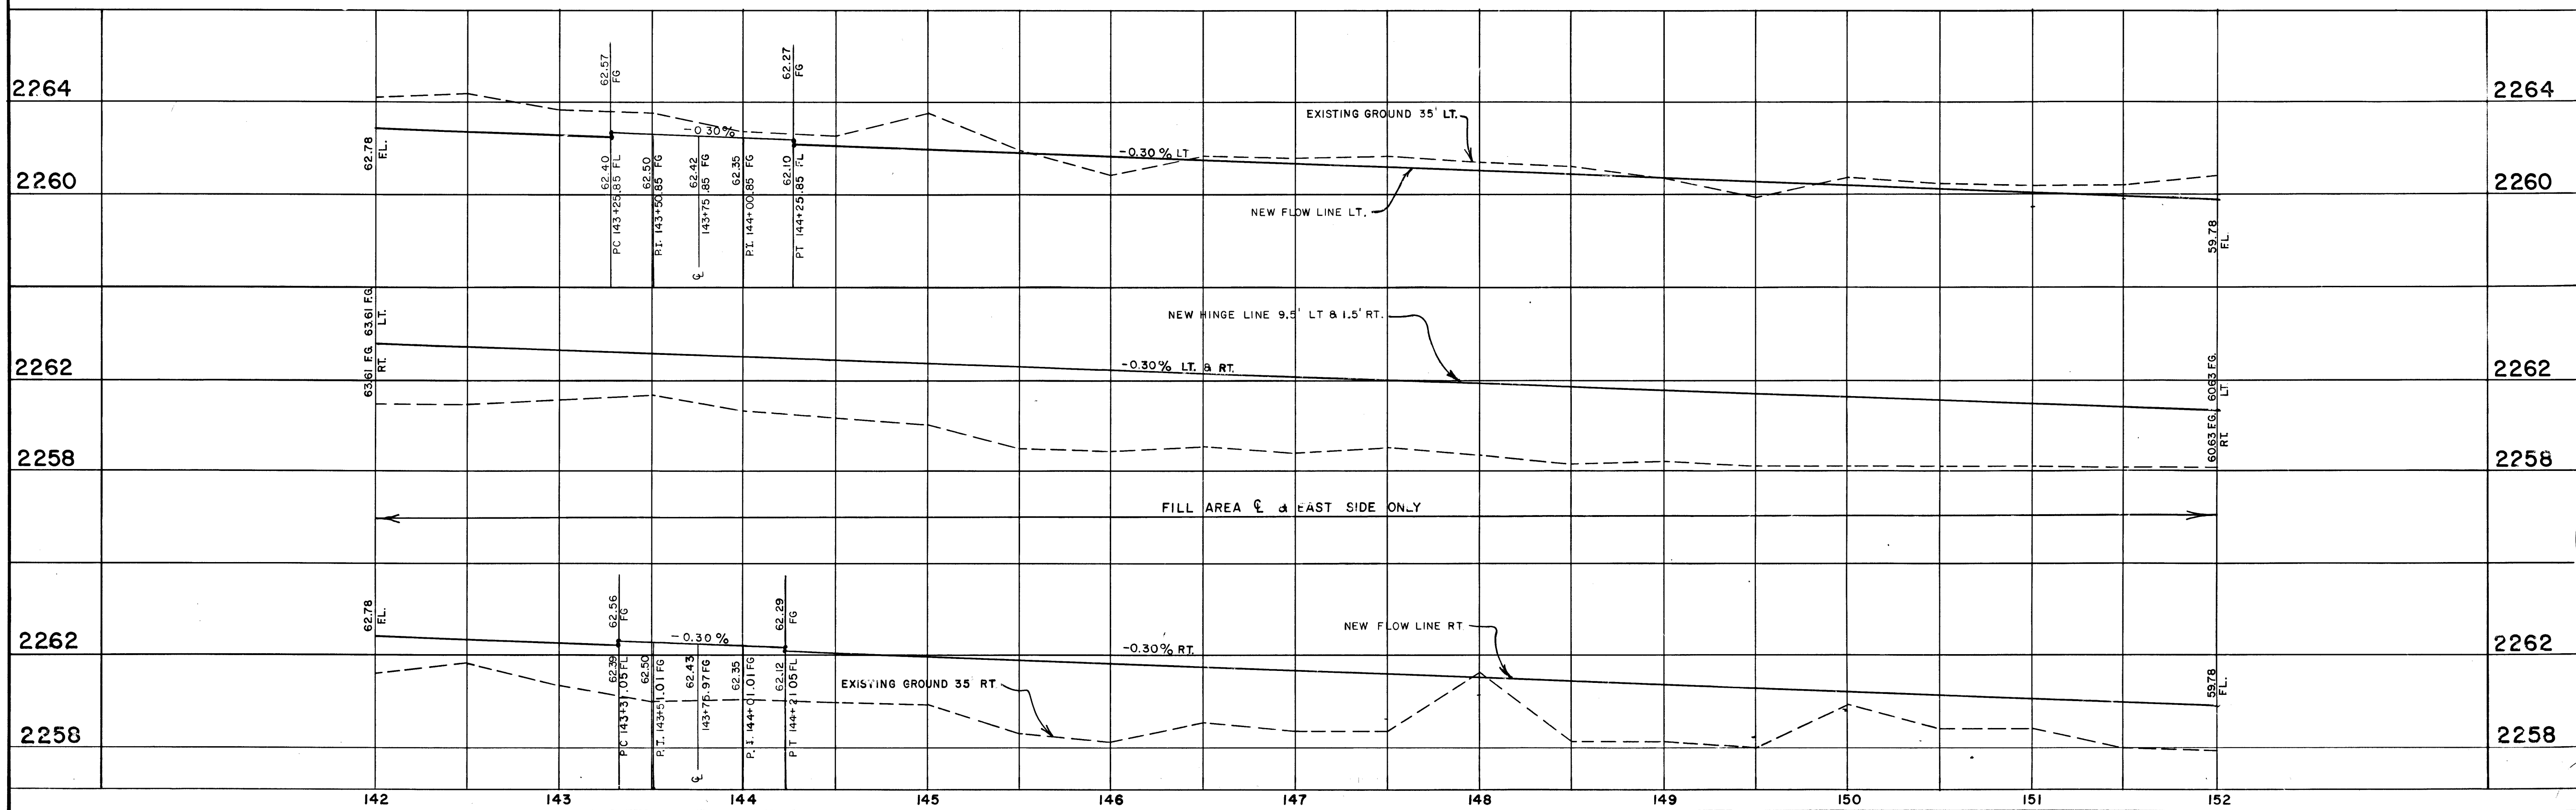

ADD F.G.				
NO.	DESCRIPTION	BY	DATE	APPROVAL
REVISIONS				



EXISTING UTILITIES ARE LOCATED ON THE PLANS FOR THE CONVENIENCE OF THE CONTRACTOR ONLY. THE CONTRACTOR SHALL BEAR FULL RESPONSIBILITY FOR PROTECTION OF UTILITIES AND THE CITY BEARS NO RESPONSIBILITY FOR UTILITIES NOT SHOWN ON THE PLANS OR NOT IN THE LOCATION SHOWN ON THE PLANS.

CITY OF LAS VEGAS
CLARK COUNTY, NEVADA

Department of Public Services
Engineering Design Division

JONES BOULEVARD
CHARLESTON BLVD. TO
SMOKE RANCH ROAD

scale (h) 1" = 50' scale (v) 1" = 4' drawing no. 107-V948A
w.o.no. 7694 f.b.k.no. 74-9XA date
design by L. J. ROHM drawn by E. E. HUNT
approved by Director of Public Services date 12/2/78 sh. 17 of 68

