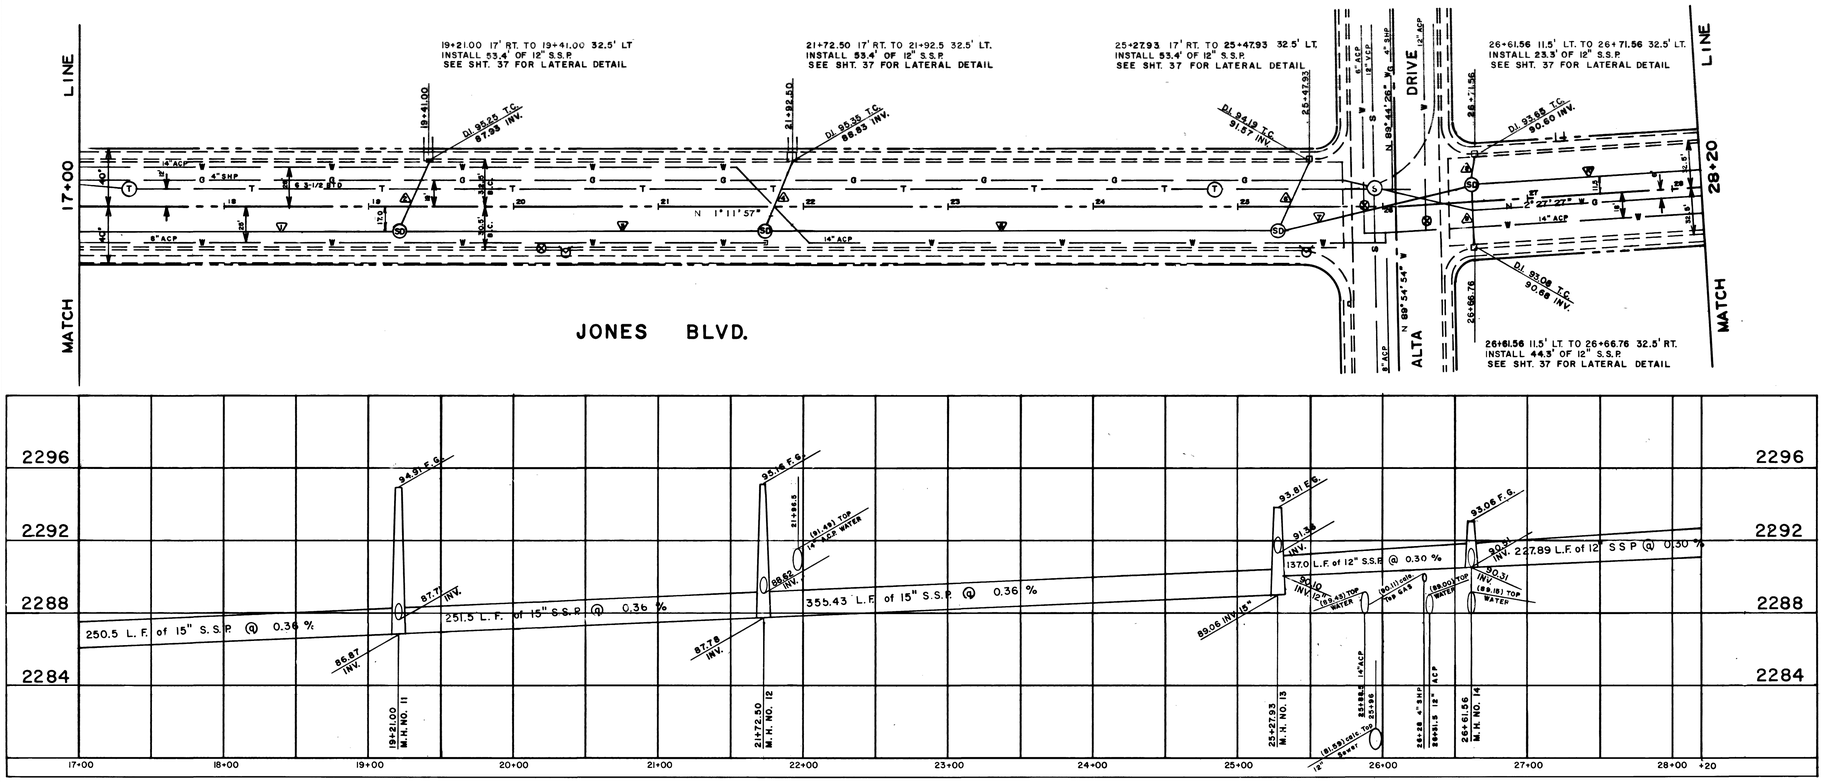

D-LOAD CHART	
LFG	D-LOAD ULT.
1	1754
2	1817
3	1742
4	1887
5	1656
6	3407
7	2649
8	2550
9	4163
10	2649
11	2022
12	4847
13	1836
14	5150
15	1808
16	5393
17	1779
18	4097

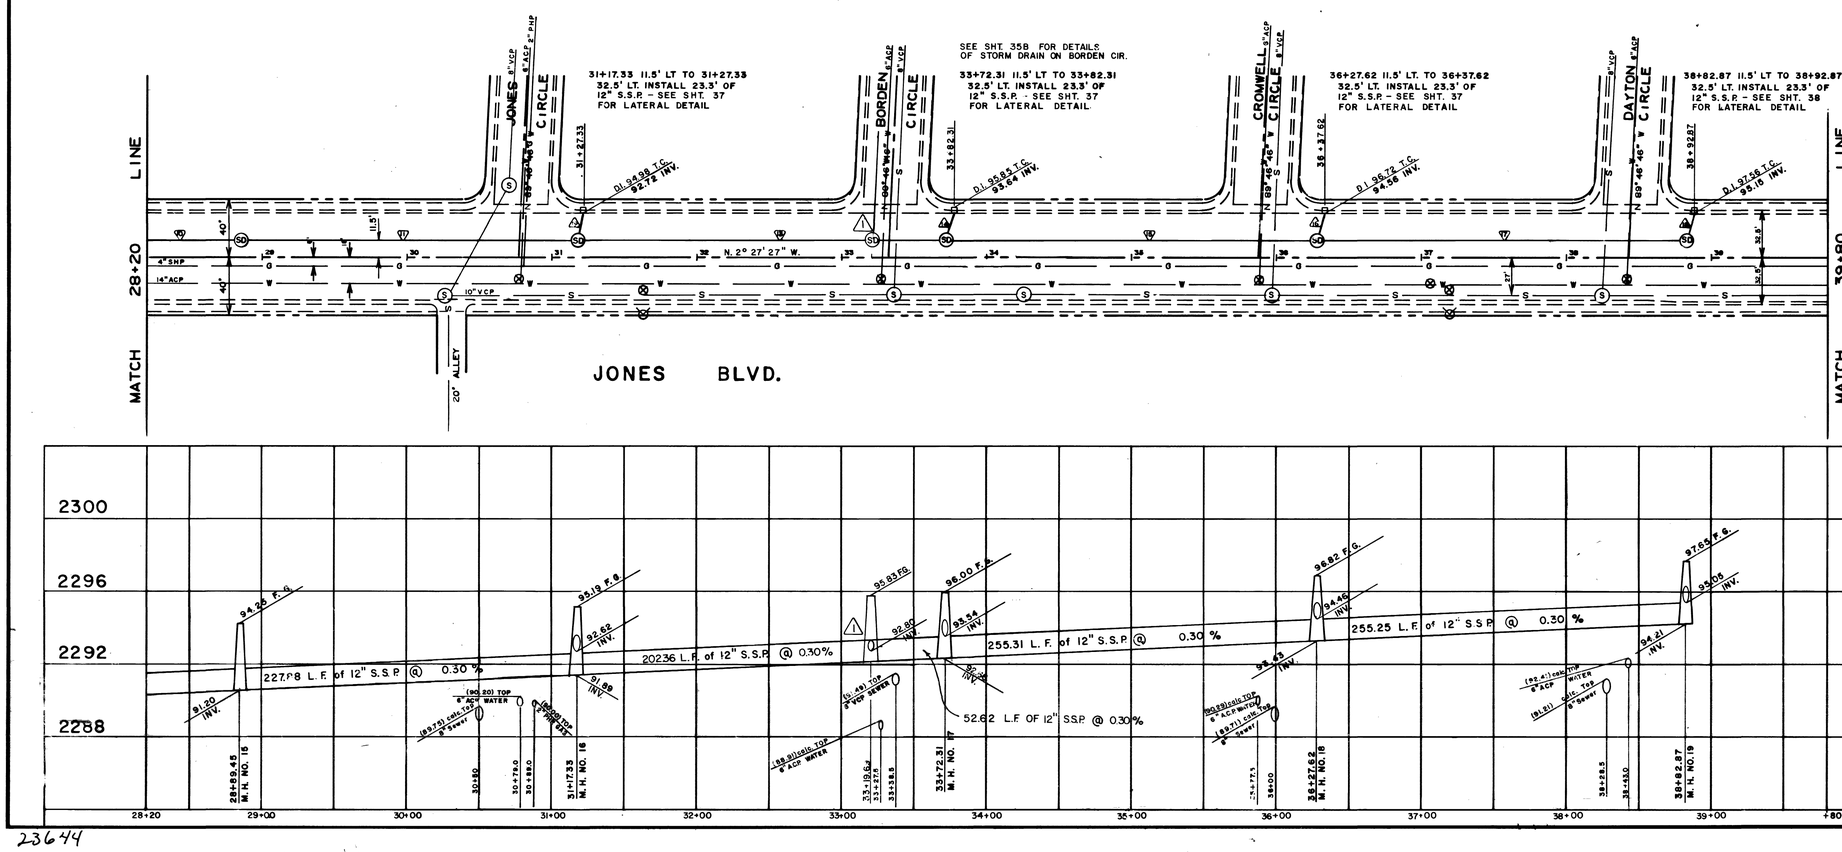

FEB 2 1979

BENCH MARK

No. 06035-D3, S.W. Cor.
JONES & ALTA DRIVE
ELEV. 2294.17

Revisions	Date
ADDED S.D. ON BORDEN CIR.	2/15/79

Scale (h) 1" = 50' | Scale (v) 1" = 4' | W.O. no. 7694

Fld. bk. no. 75-4X | Date

Design by C. KREHNOVI | Drawn by CALCOMP

Approved by the Director of Public Services | Date 12/7/78

Department of Public Services — Engineering Design Division

STORM DRAIN
PLAN AND PROFILE

JONES BLVD.
CHARLESTON BLVD.
TO
SMOKE RANCH ROAD

CITY OF LAS VEGAS — CLARK COUNTY, NEVADA

Drawing no. 107-V948A | 30/66

23644

22444