
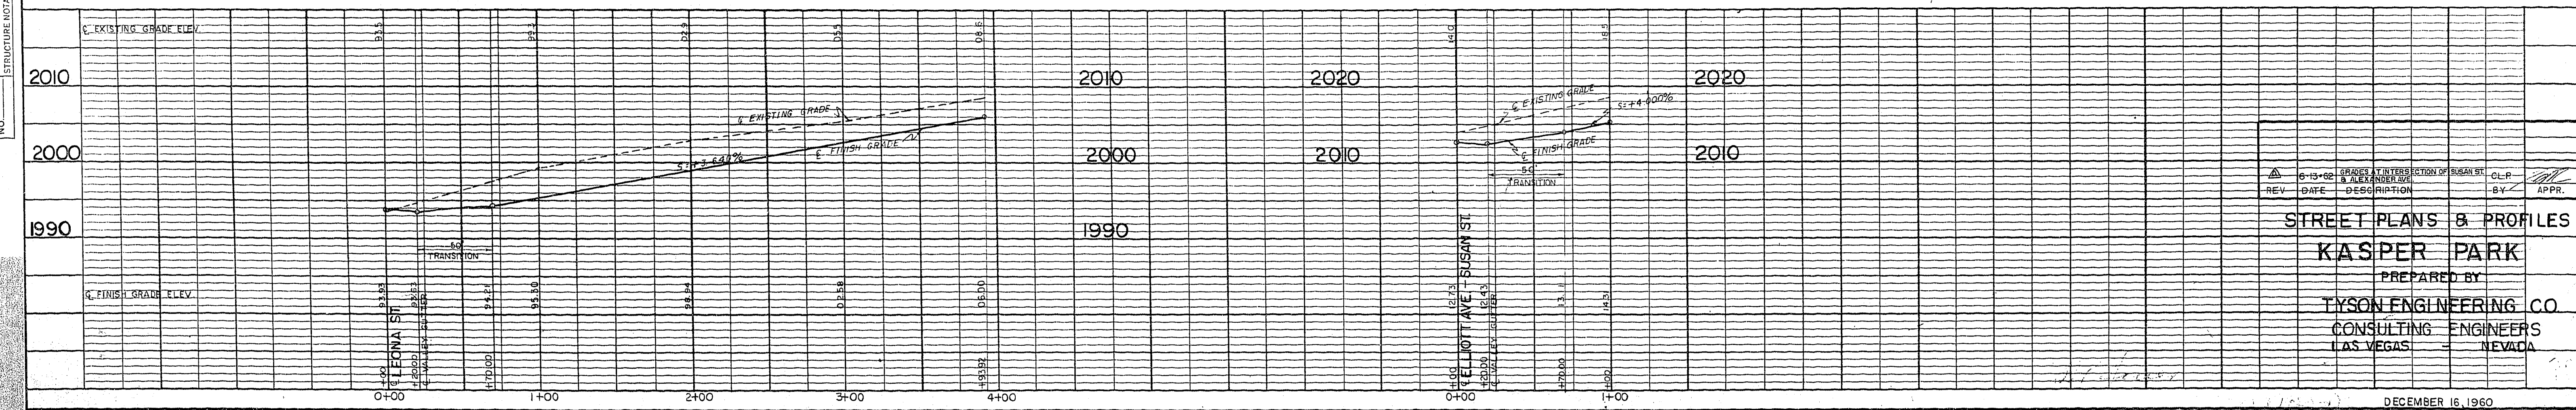
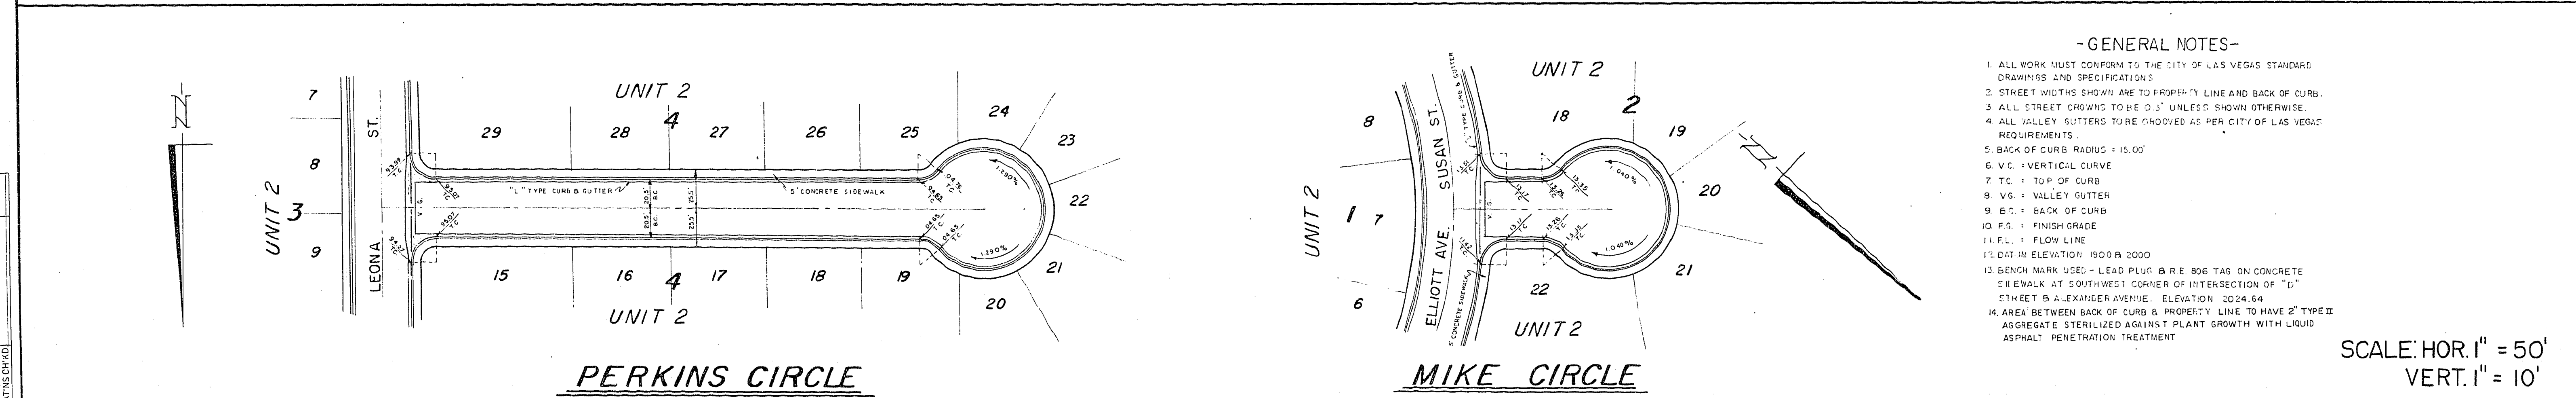
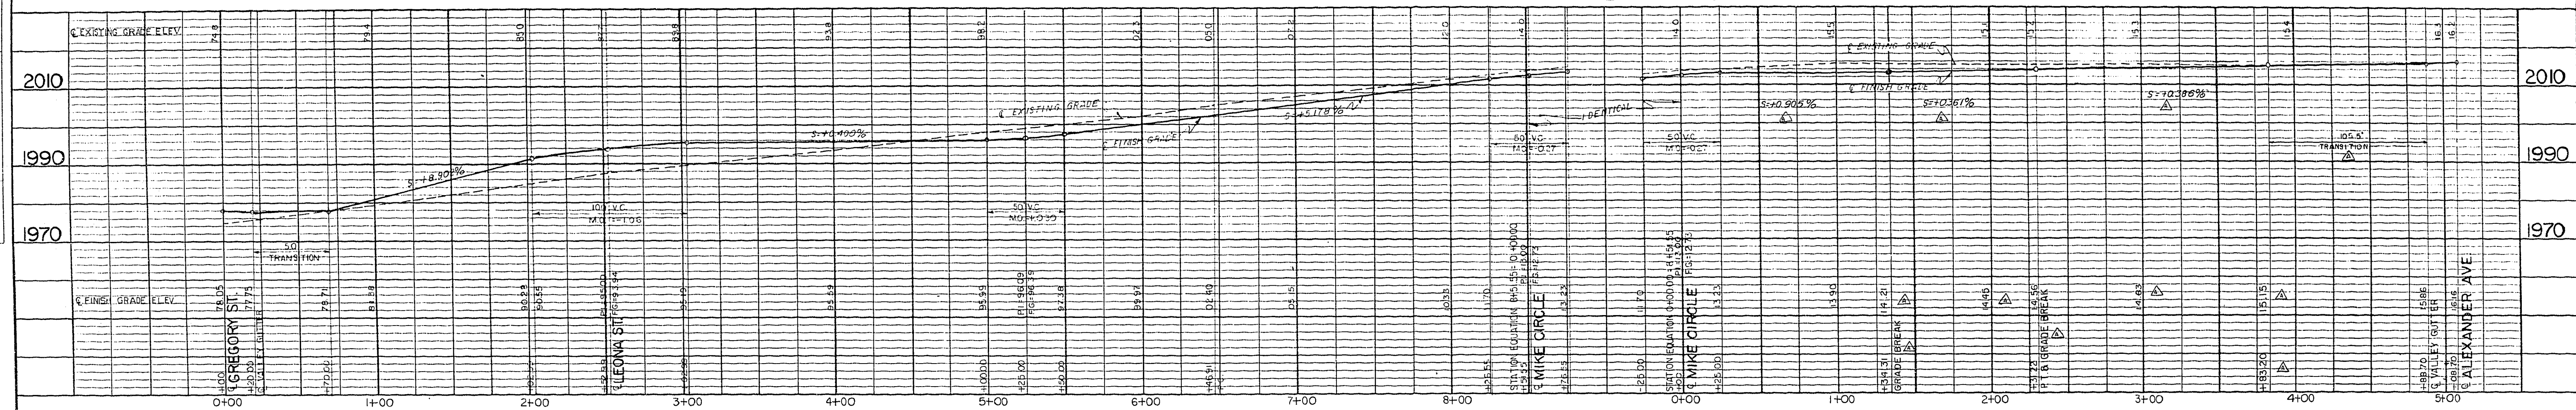


PLAN	DATE	BY
SURVEYED		
NOTE BOOK		
ALIGNED CHECKED		
RET. OF WAY CHECKED		
NO.		

PROFILE	DATE	BY
SURVEYED		
NOTE BOOK		
GRADES CHECKED		
STRUCTURE NOTATIONS CHECKED		
NO.		

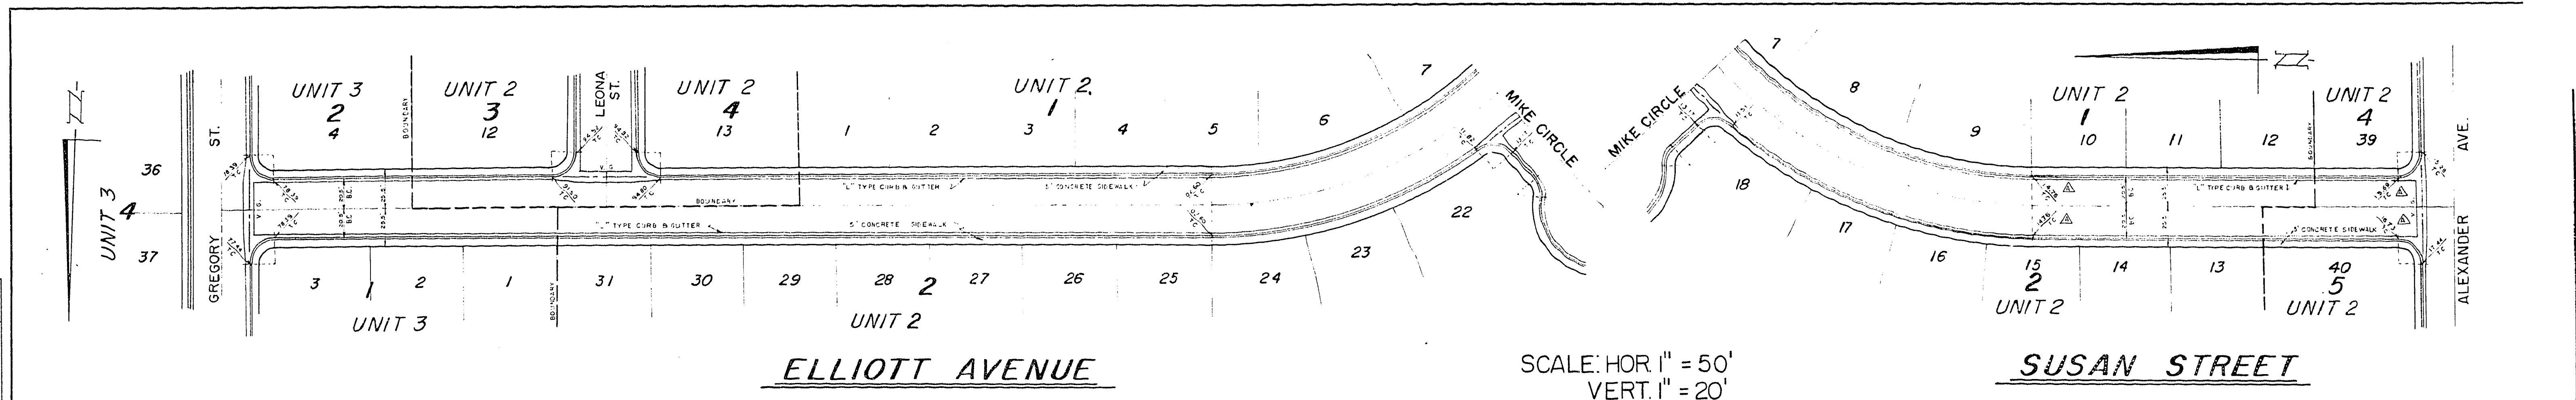

- GENERAL NOTES-
1. ALL WORK MUST CONFORM TO THE CITY OF LAS VEGAS STANDARD DRAWINGS AND SPECIFICATIONS.
 2. STREET WIDTHS SHOWN ARE TO FORTH-Y LINE AND BACK OF CURB.
 3. ALL STREET CROWNS TO BE 0.5' UNLESS SHOWN OTHERWISE.
 4. ALL VALLEY GUTTERS TO BE GROOVED AS PER CITY OF LAS VEGAS REQUIREMENTS.
 5. BACK OF CURB RADIUS = 15.00'
 6. V.C. = VERTICAL CURVE
 7. T.C. = TOP OF CURB
 8. V.G. = VALLEY GUTTER
 9. B.C. = BACK OF CURB
 10. F.G. = FINISH GRADE
 11. F.L. = FLOW LINE
 12. DAT. = ELEVATION 1900 & 2000
 13. BENCH MARK USED - LEAD PLUG & R. 806 TAG ON CONCRETE SIDEWALK AT SOUTHWEST CORNER OF INTERSECTION OF "D" STREET & ALEXANDER AVENUE. ELEVATION 2024.64
 14. AREA BETWEEN BACK OF CURB & PROPERTY LINE TO HAVE 2" TYPE II AGGREGATE STERILIZED AGAINST PLANT GROWTH WITH LIQUID ASPHALT PENETRATION TREATMENT

STREET PLANS & PROFILES
KASPER PARK
PREPARED BY
TYSON ENGINEERING CO.
CONSULTING ENGINEERS
LAS VEGAS - NEVADA

177-17 1074-1920-2