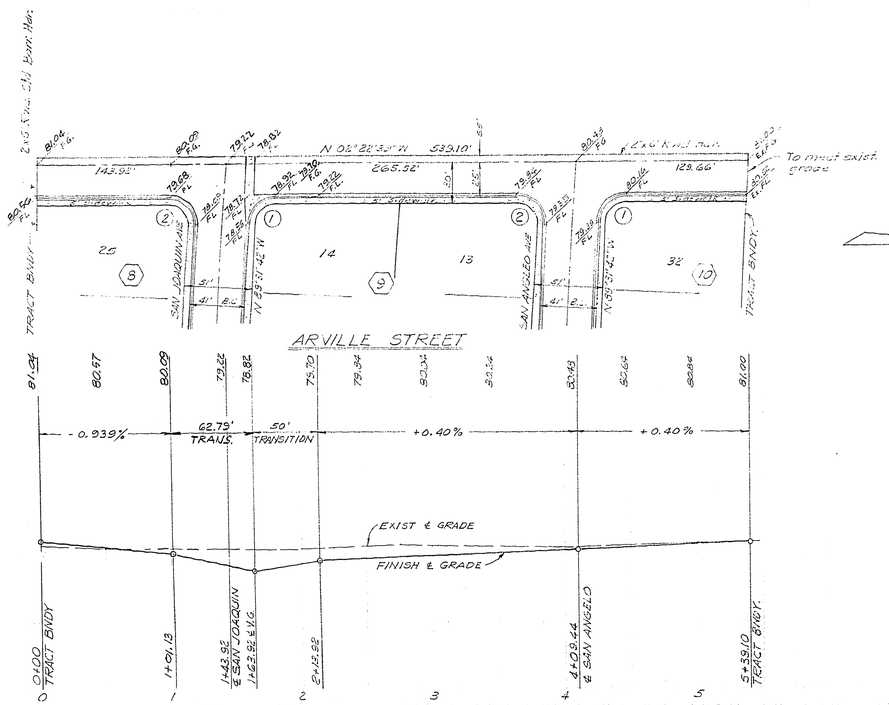


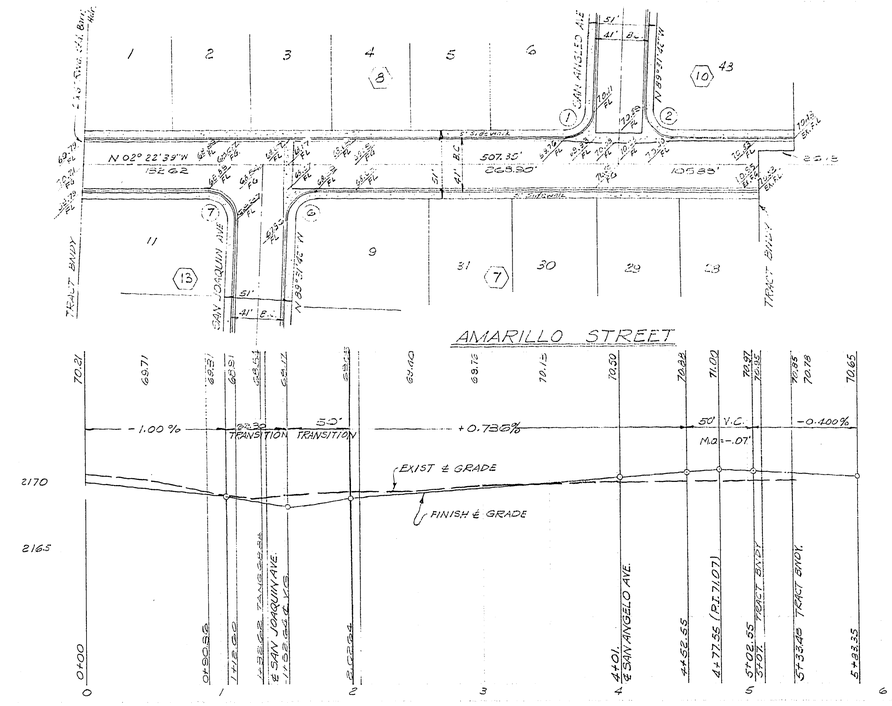


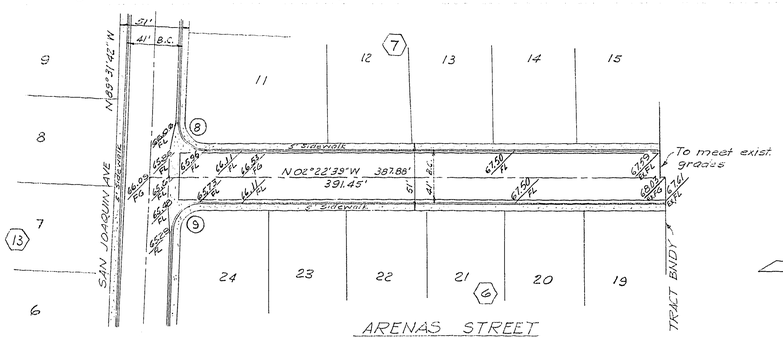


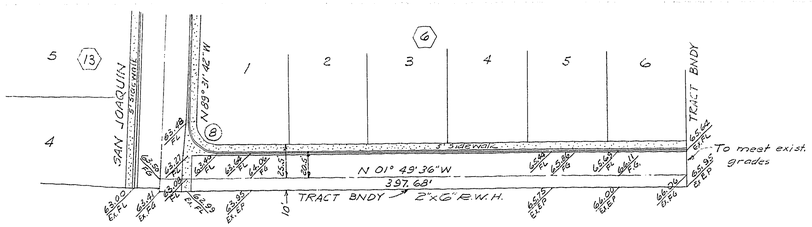


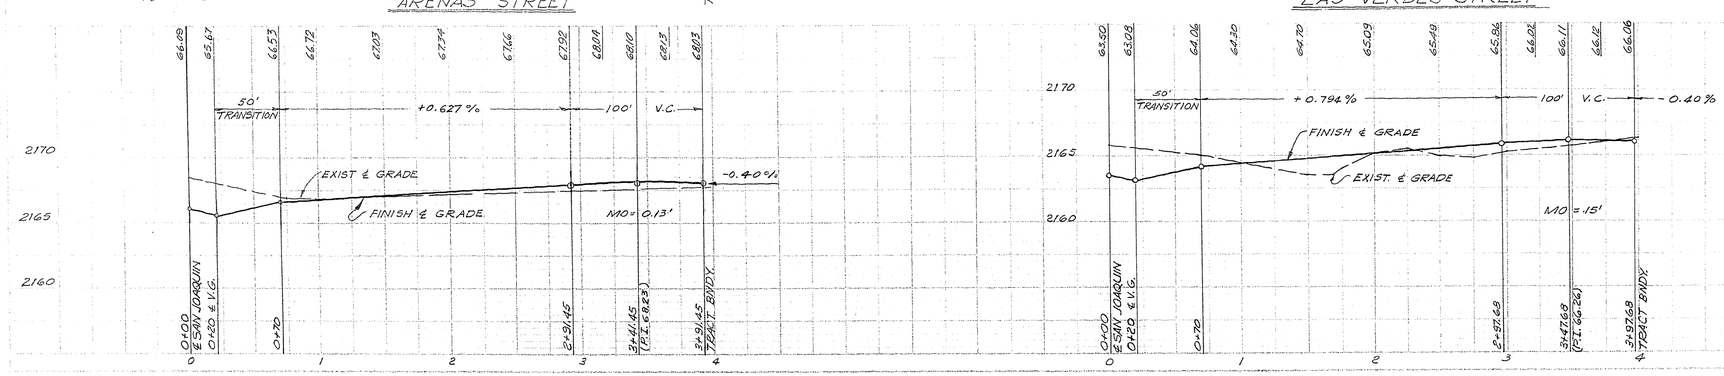


APPROVALS

City Engineer — Date

Field Engineer — Date

| REV. | DATE | DESCRIPTION | BY | APPROVED |
|---|---|---|---|---|
| H | | | | |
| G | | | | |
| F | | | | |
| E | | | | |
| D | | | | |
| C | | | | |
| B | | | | |
| A | 27 MAY 63 | SMITER V.G. AT SAN JOAQUIN AVE. | MR | |

LAS VERDES HEIGHTS 6 UNIT Nº 2

STREET PLANS & PROFILES

SCALE: HORIZ. 1"=50' VERT. 1"=5'

DESIGNED JK
DRAWN JK
CHECKED

WESTERN ENGINEERS, INC.
LAS VEGAS NEVADA

APPROVED DATE 11-6-62

SHEET 2 OF 5

107Y-1980-6-2

1997 JK