


PLAN

PROFILE

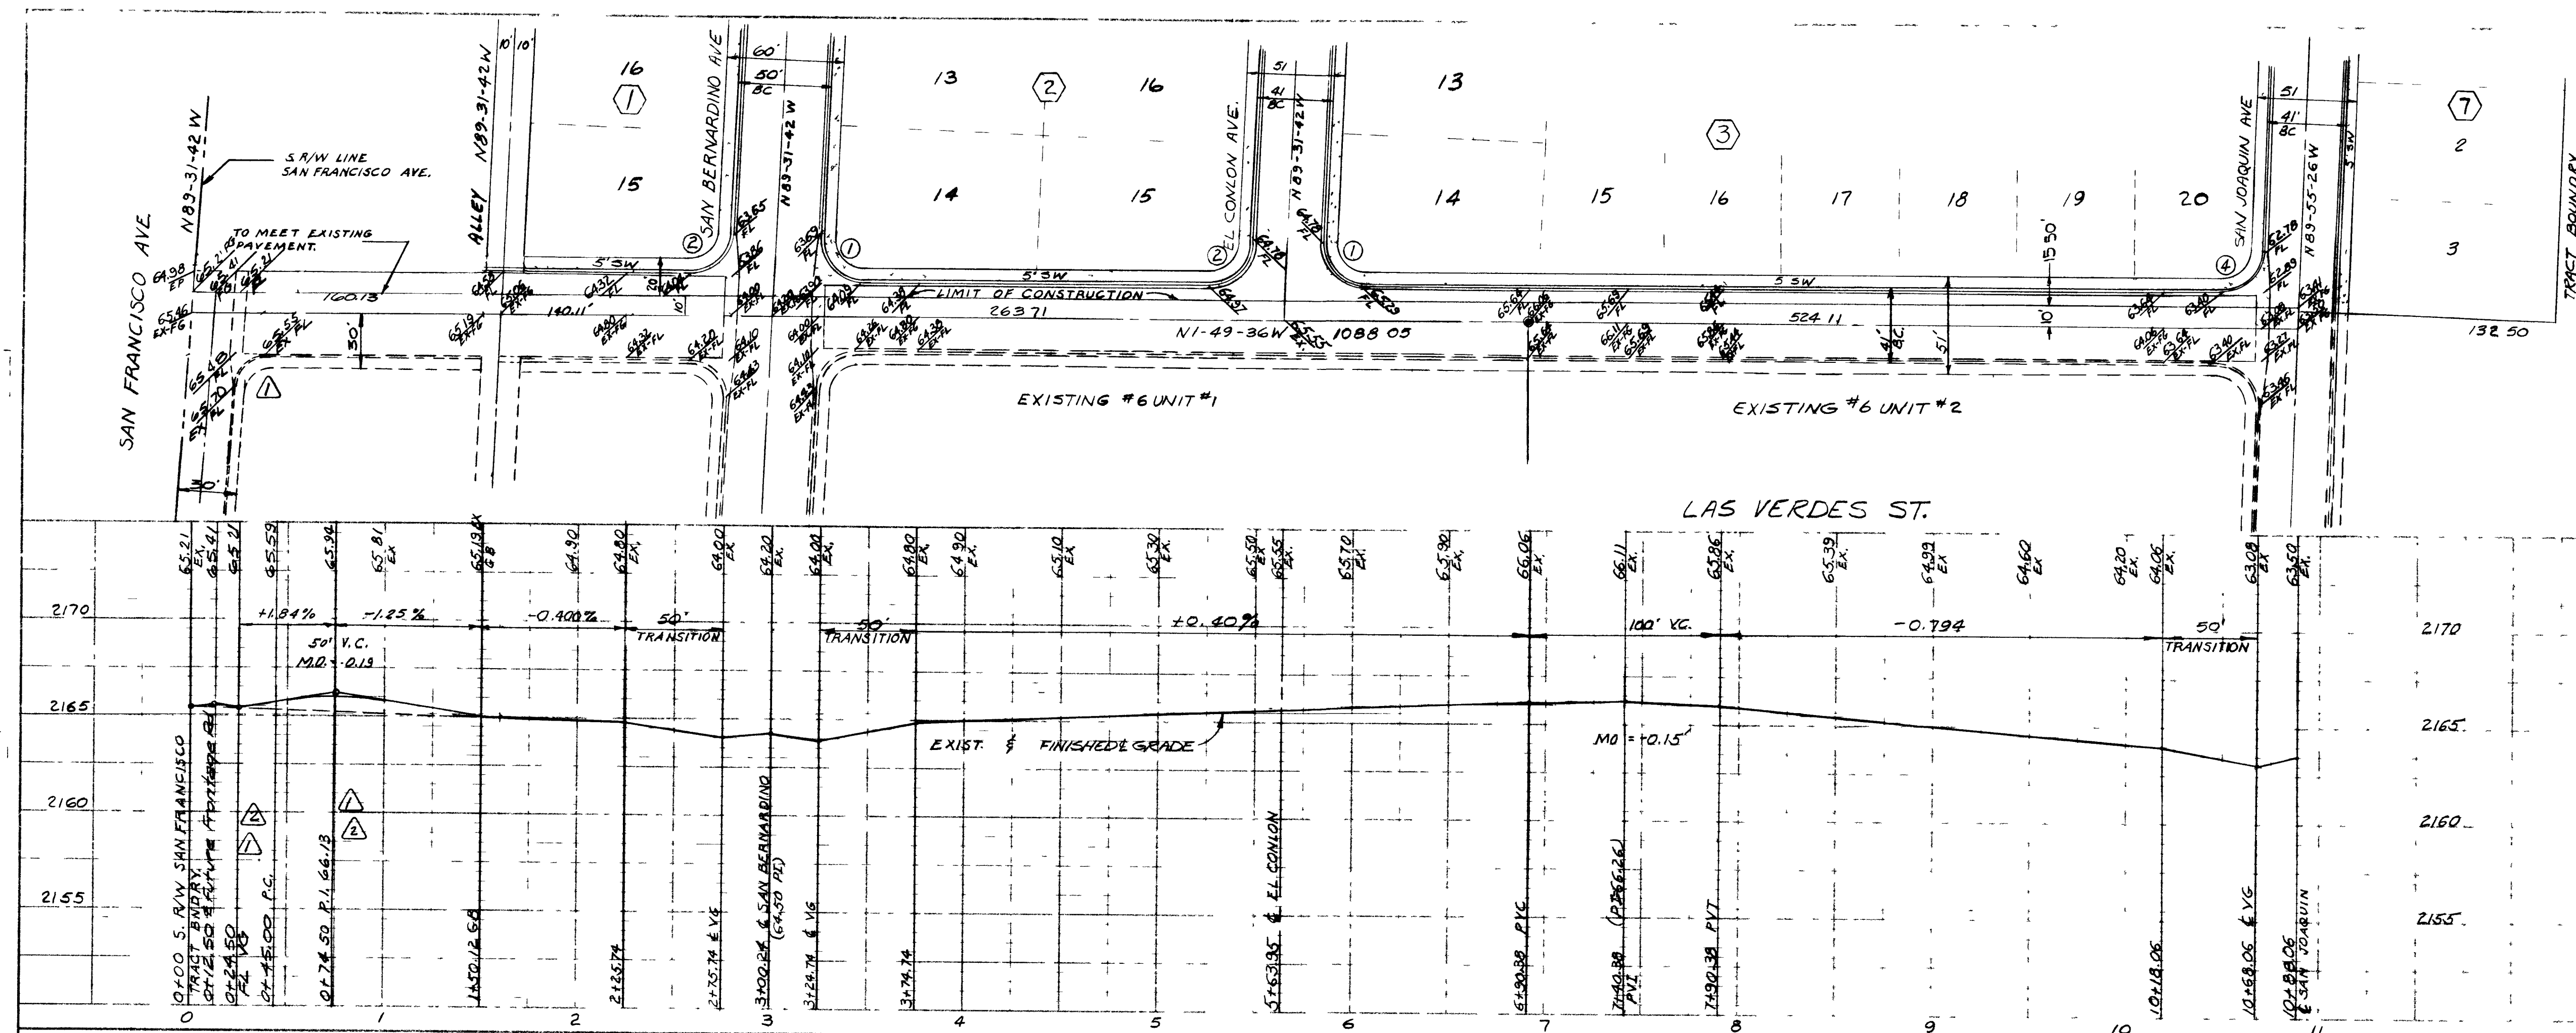

SCALE 1" = 50'

APPROVALS

J. J. Haul 9-21-62
CITY ENGINEER DATE
J. J. Haul 9-21-62
FIELD ENGINEER DATE

DESIGNED	AC	WESTERN ENGINEERS INC	SHEET	4
DRAWN	ROR	LAS VEGAS NEVADA	OF	7
CHECKED		APPROVED	DATE	
LAS VERDES HEIGHTS UNIT 6- N° 3 STREET PLAN & PROFILE SCALE: HORIZ. 1" = 50' VERT. 1" = 5'				
REV	DATE	DESCRIPTION	BY	APPR.
10-6-62		Grades	HK	
10-18-62		Grades	ROR	

4355

19.12.10 107Y-1980-6-3

10-10-68



1077-7750-1-1