



BCR CURVE DATA

N	Δ	R	L	T
15	90° 00' 00"	59.00'	80.39'	55.00'
19	08° 19' 21"	104.50'	15.18'	7.40'
20	10° 20' 10"	59.50'	10.01'	5.02'
21	39° 20' 38"	55.50'	38.21'	19.90'
22	40° 12' 31"	55.50'	38.96'	20.32'
23	16° 38' 17"	55.50'	10.12'	8.12'
24	106° 38' 42"	59.50'	103.30'	74.52'
43	28° 30' 10"	19.50'	30.12'	19.00'
48	90° 55' 25"	19.50'	30.94'	19.82'
50	90° 00' 00"	54.50'	54.19'	34.50'
53	180° 00' 00"	5.00'	15.71'	-

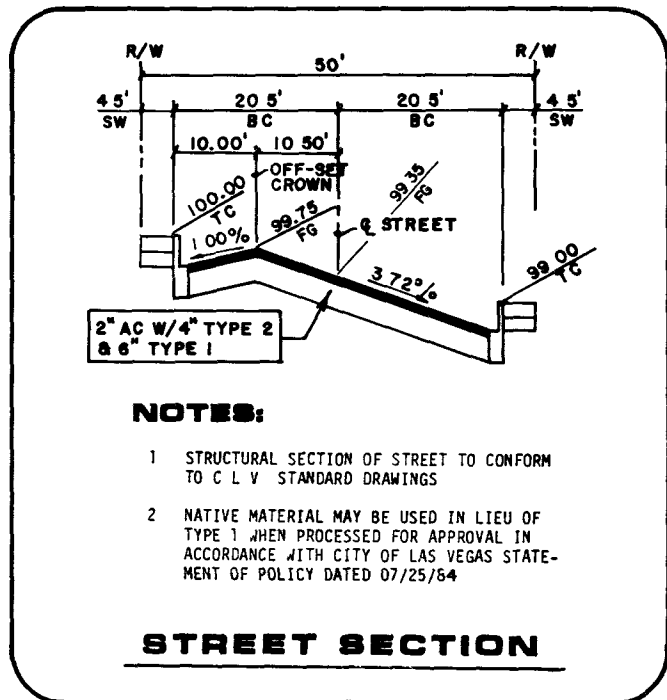

TERRACE GREEN AVENUE

- REVISED ISLAND NOTES:
- REMOVE EXIST. "A" TYPE CURB
 - MATCH EXISTING TOP OF CURBS AT BCR'S & STA 0+67.01 OF NEW BULLNOSE
 - NEW 3" A.C. PAVE W/4" TYPE 2 & 6" TYPE 1
 - LIMITS OF SAWCUT AND REMOVAL OF EXISTING A.C. PAVEMENT TO BE DETERMINED.

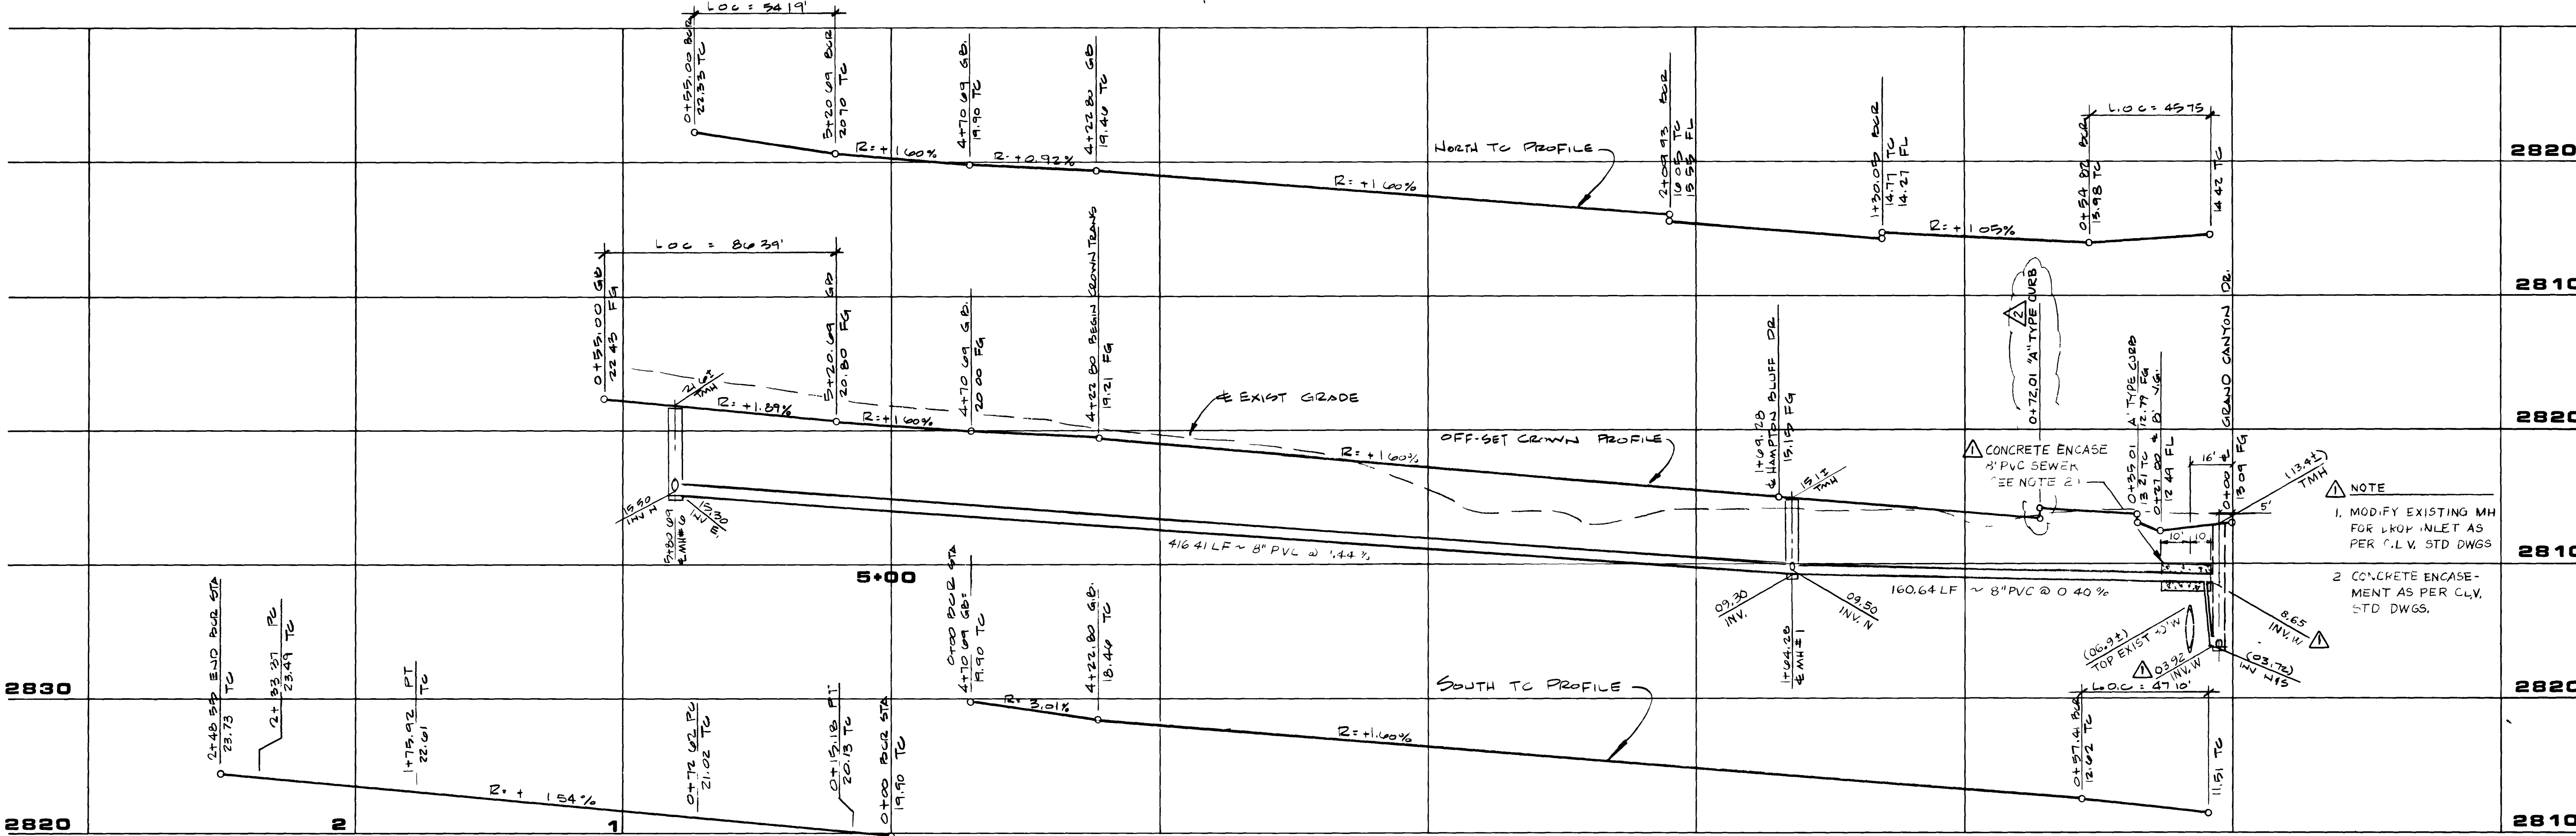

REVISIONS

REV	DATE	DESCRIPTION

RECORDED & INDEXED

DAVID A. HOBBS

1555 SOUTH RAINBOW BLVD / LAS VEGAS, NEVADA 89102

G.C. WALLACE, INC.
Engineering/Architecture

LEWIS HOMES OF NEVADA
LEWIS HOMES - LAKES WEST NO. 3
TERRACE GREEN AVENUE

SHEET
7
OF 13 SHEETS

