

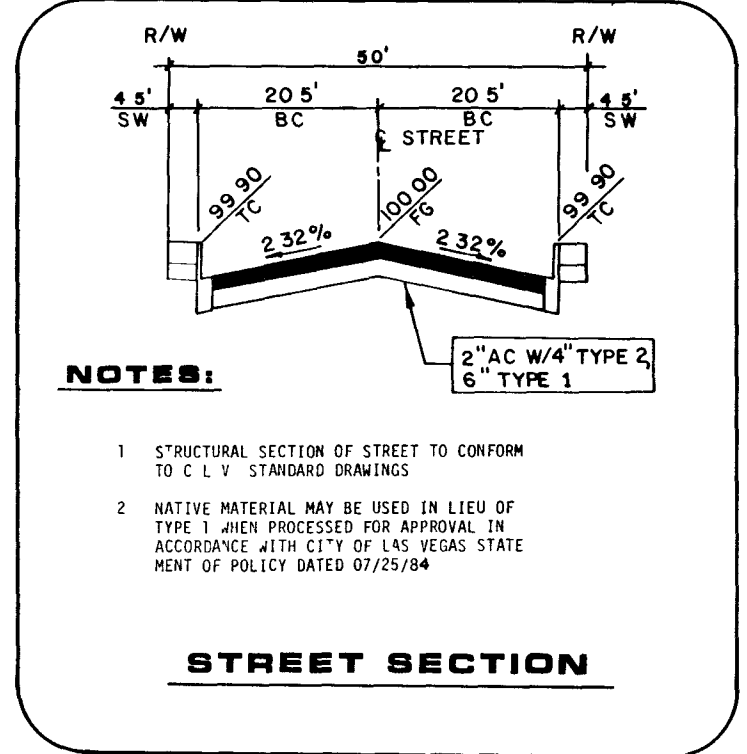


BCR CURVE DATA

No.	Δ	R	L	T
29	110° 21' 02"	19.50'	37.56'	28.03'
30	07° 36' 21"	809.50'	107.48'	53.82'
31	38° 14' 53"	54.50'	36.35'	18.90'
32	00° 51' 23"	809.50'	12.10'	6.05'
33	06° 45' 04"	809.50'	95.38'	47.75'
34	100° 17' 24"	41.00'	71.77'	49.11'
35	102° 11' 45"	41.00'	73.13'	50.81'
36	54° 00' 36"	41.00'	38.65'	20.90'
37	18° 56' 16"	54.50'	18.01'	9.09'
38	19° 18' 37"	54.50'	18.37'	9.27'
39	03° 36' 37"	850.50'	53.59'	26.80'
40	03° 37' 22"	850.50'	53.78'	26.90'
41	04° 16' 54"	850.50'	63.56'	31.79'
42	04° 19' 59"	850.50'	64.32'	32.18'
43	03° 41' 59"	850.50'	54.92'	27.47'
44	03° 17' 26"	850.50'	48.85'	24.43'
49	78° 43' 47"	19.50'	25.77'	15.16'
51	06° 33' 07"	809.50'	92.57'	46.33'
52	06° 47' 41"	809.50'	96.00'	48.06'
55	29° 29' 46"	41.00'	183.54'	52.01'
56	13° 20' 49"	809.50'	188.57'	94.71'
57	15° 30' 16"	830.00'	224.60'	112.99'
58	11° 31' 48"	830.00'	167.05'	83.80'
59	27° 02' 04"	830.00'	391.63'	199.53'
60	26° 27' 39"	850.50'	392.79'	199.96'

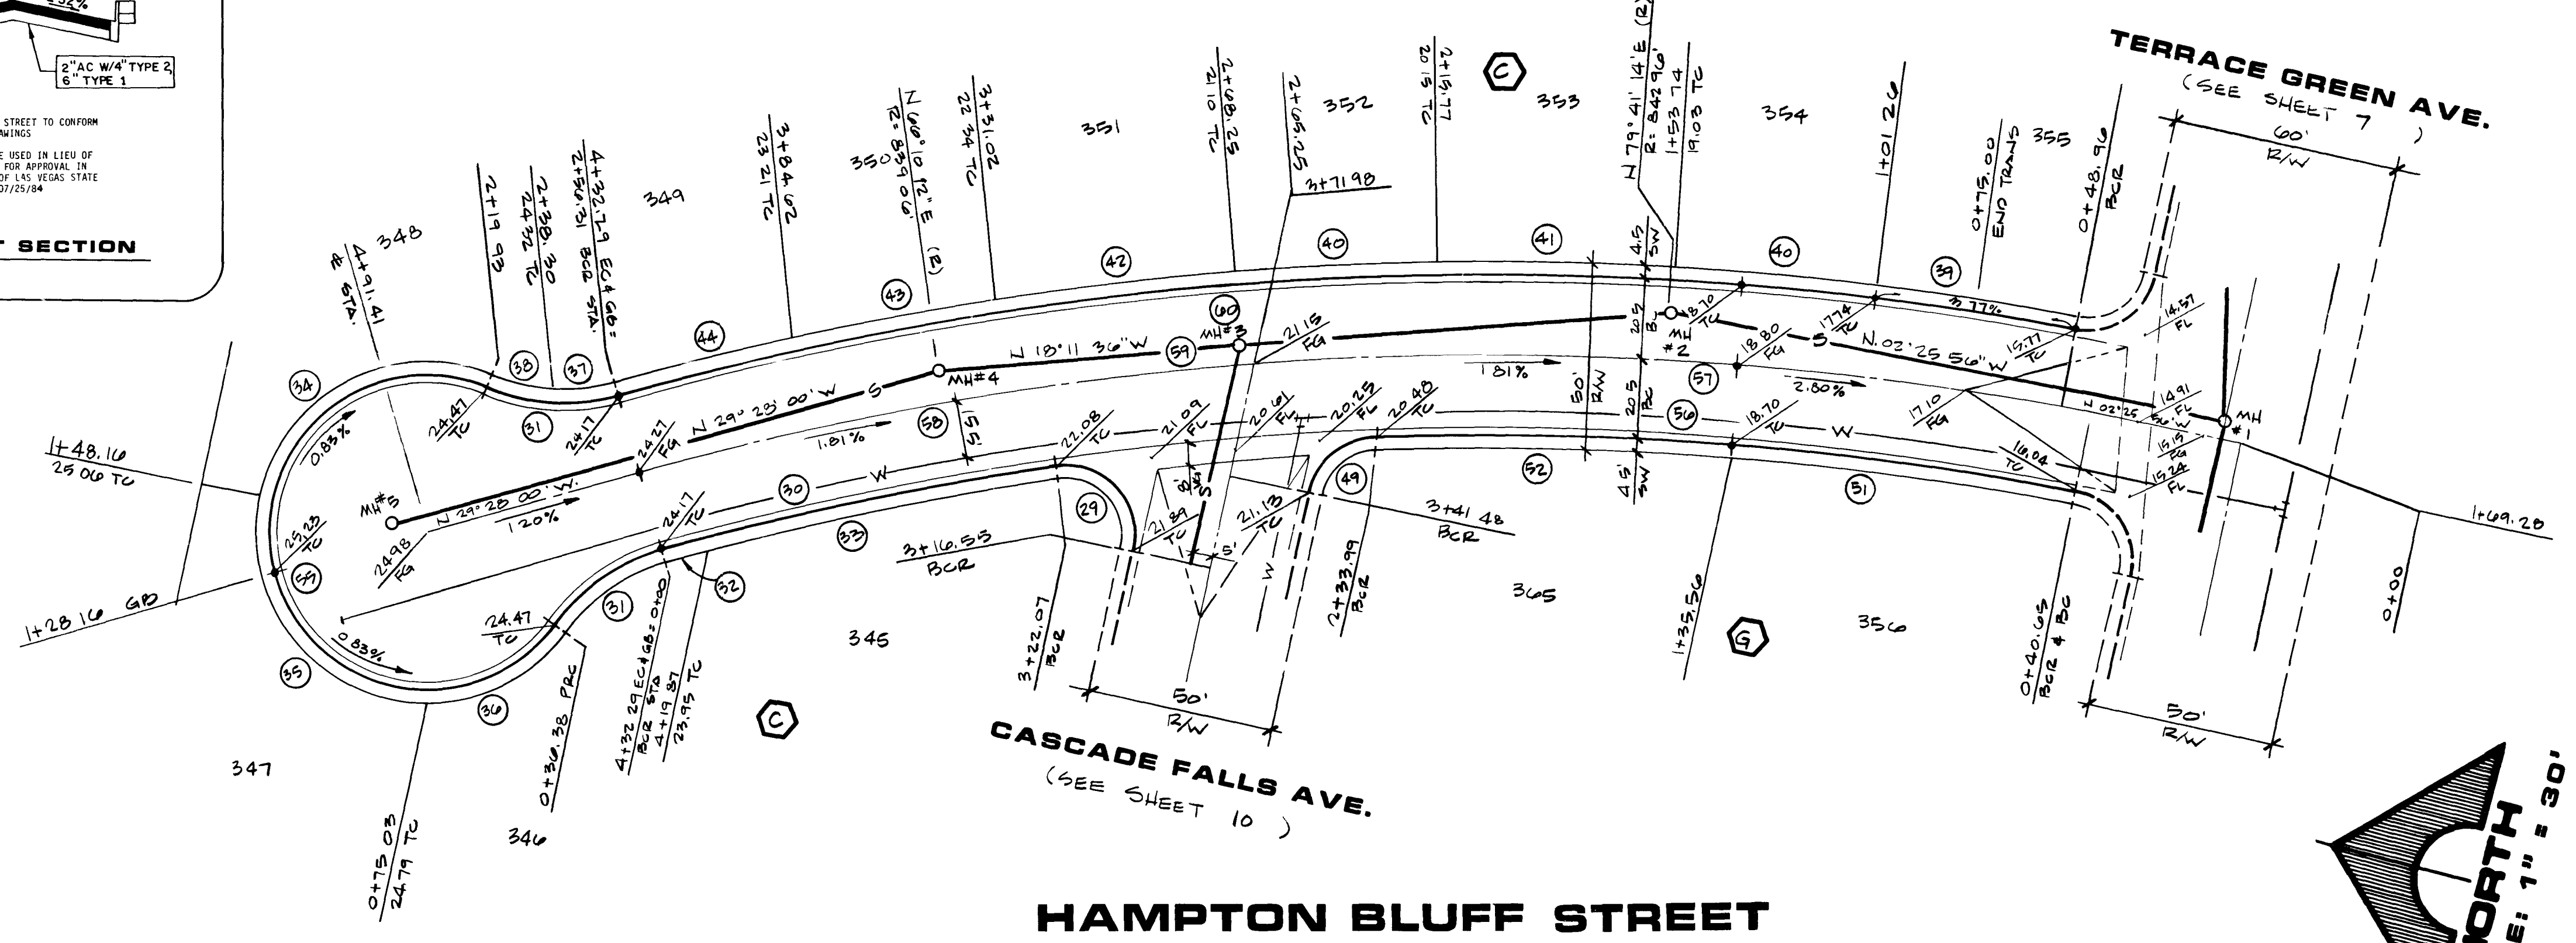

CUL-DE-SAC PROFILE

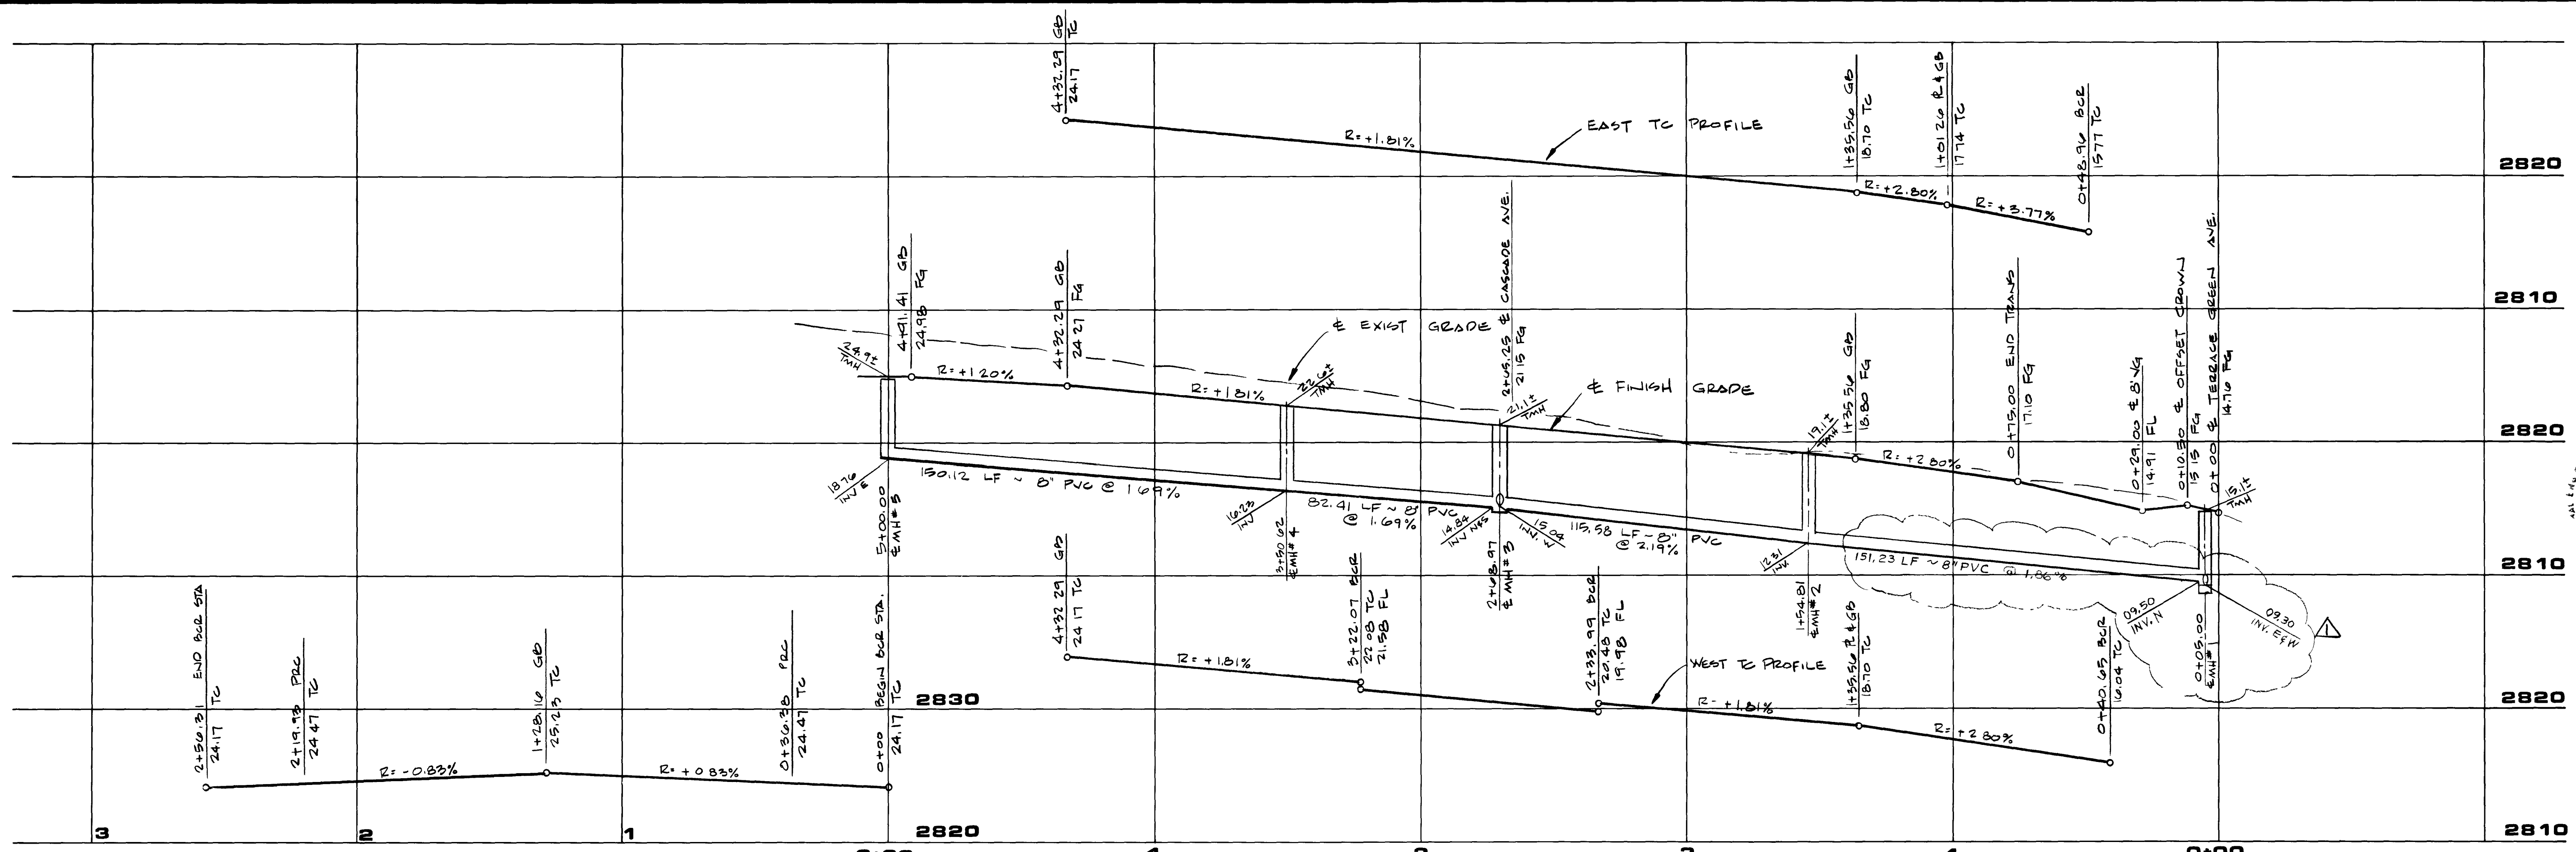

RECOMMENDED BY: [Signature]

DATE: 10/17/06

DESCRIPTION: RAISE INVERT, FEEDS, SAN GR

PROJECT NO: 5543.8640

DATE: 10/17/06

REVISION: 1

DESIGNER: DAVID RUI, RUCS

PROJECT: 1555 SOUTH RAINBOW BLVD LAS VEGAS, NEVADA 89102

G.C. WALLACE, INC.
Engineering/Architecture

LEWIS HOMES OF NEVADA
LEWIS HOMES - LAKES WEST NO. 3
HAMPTON BLUFF STREET

SHEET 8 OF 13 SHEETS

