


BC. CURVE DATA

NO	Δ	R	T	C	L
1	91° 12' 29"	20.00	20.43	28.58	31.84
2	04° 40' 55"	490.00	20.03	40.03	40.04
3	82° 06' 46"	20.00	17.42	26.27	28.66
8	40° 04' 46"	525.00	191.50	359.81	367.25
9	43° 24' 09"	500.00	198.99	369.77	378.76
10	12° 09' 52"	500.00	53.28	105.96	106.15
11	31° 14' 17"	500.00	139.78	269.24	272.60
12	30° 10' 42"	475.00	128.07	247.31	250.19
17	06° 30' 58"	475.00	27.04	53.99	54.02
18	95° 38' 54"	20.00	22.08	29.64	33.39
25	90° 00' 00"	20.00	20.00	28.28	31.42

SC. CURVE DATA

NO	Δ	R	T	C	L
37	31° 26' 50"	775.00	218.19	420.05	425.36'
38	09° 44' 04"	775.00	65.99'	131.51	131.67'
39	13° 09' 05"	800.00	92.22	183.23	183.63
40	34° 51' 51"	800.00	251.20	479.32	486.80
41	48° 00' 56"	800.00	356.31	650.98	670.42
42	04° 11' 57"	800.00	29.33	58.62	58.63
43	01° 08' 47"	825.00	8.29	16.51	16.51'
44	40° 45' 49"	825.00	306.52	574.65	586.95'
49	88° 42' 36"	20.00	19.55	27.96	30.97
50	86° 57' 50"	20.00	18.97'	27.52	30.36
56	93° 25' 01"	20.00	21.23	29.11	32.61

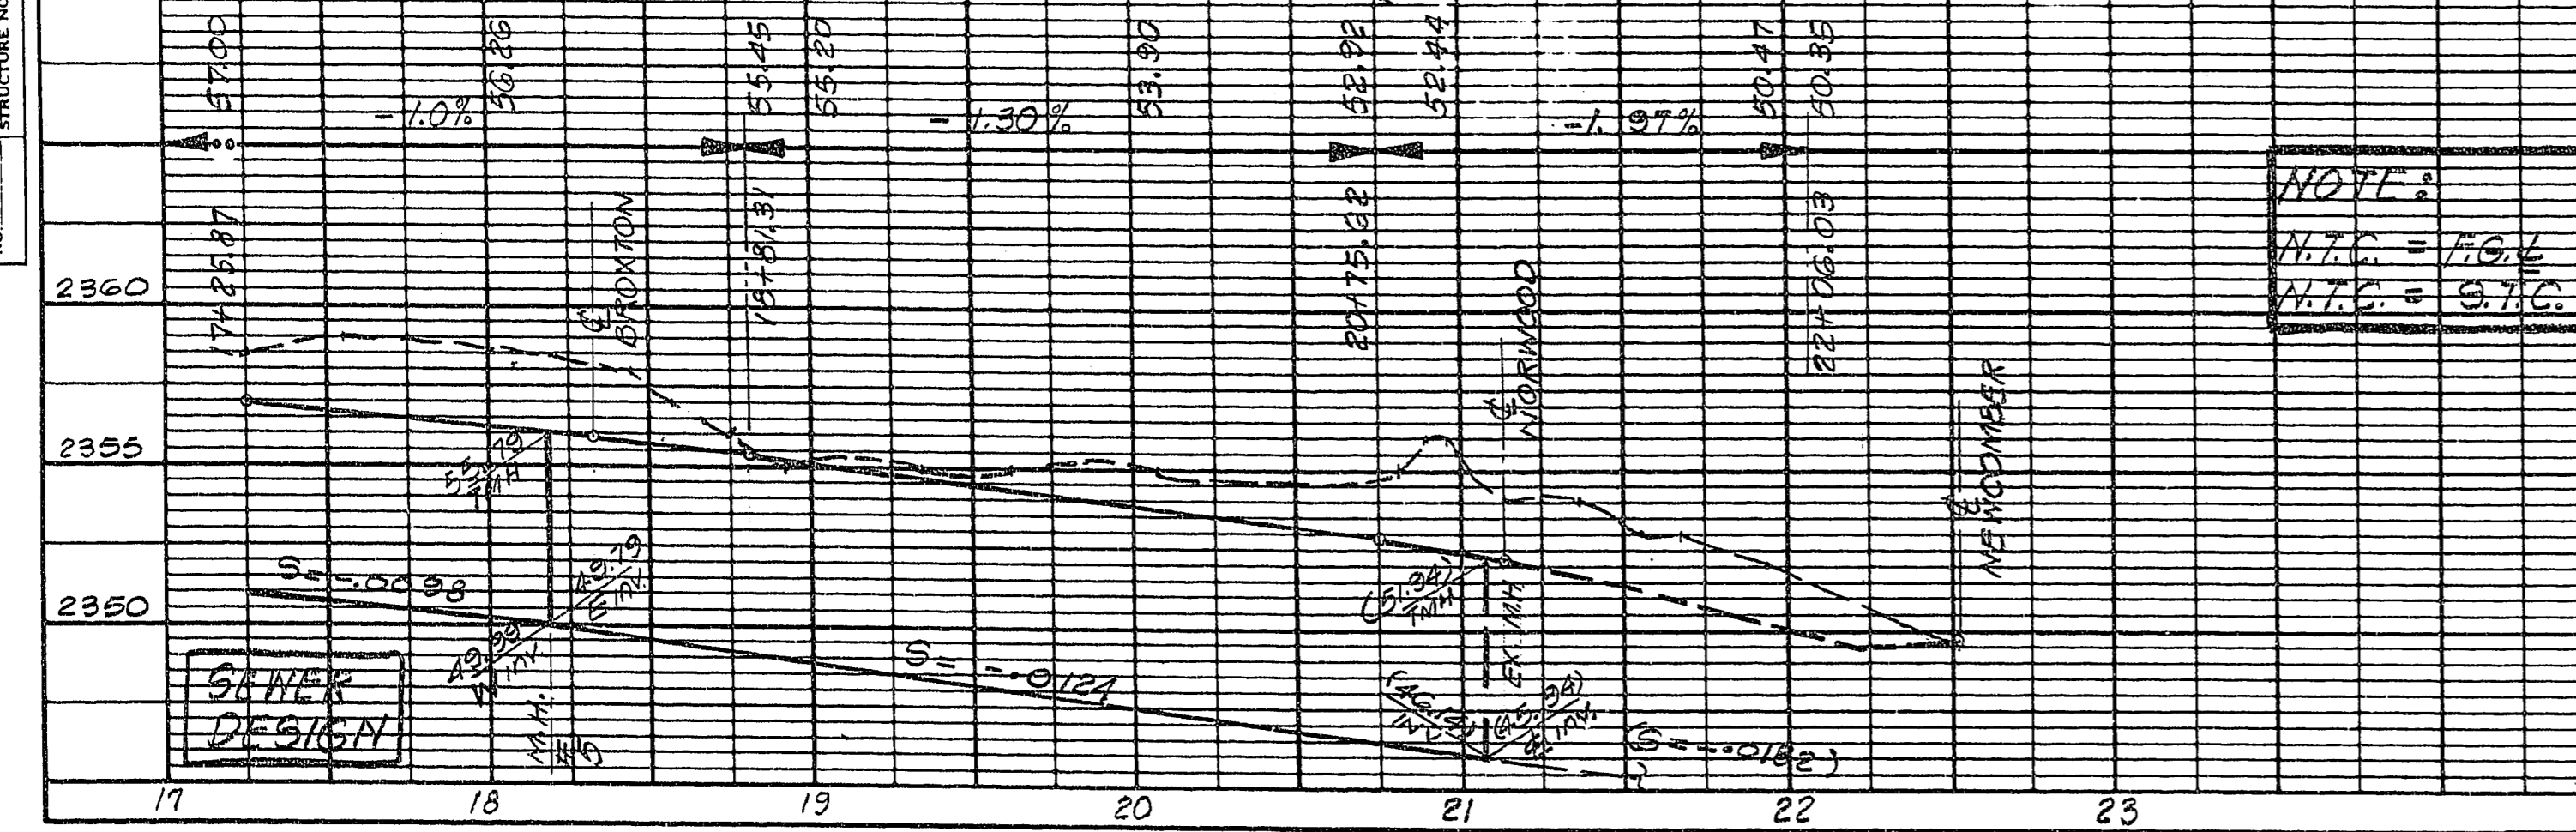

REVISIONS

REVISION NO.	DESCRIPTION	BY	DATE	APPROVAL
1	REV. Δ delta as shown, chg T.C. elev.	JP	9/10/78	KST

LEWIS HOMES - CHAS. NO 5  
LAS VEGAS, NEVADA  
Street Plan & Profile  
CELESTE AVENUE

DMJM DANIEL, MANN, JOHNSON, & MENDENHALL  
PLANNING • ARCHITECTURE • ENGINEERING • SYSTEMS • ECONOMICS  
309 S. THIRD ST., LAS VEGAS, NEVADA 89101 • TEL. (702) 384-8881  
Rory S. Ondacono 5-1-73  
CIVIL ENGINEER NO. 5272

SCALE (H) 1"=50' SCALE (V) 1"=5' DATE 5-1-73  
JOB NO. 6743-14-8  
DR. J.P. SHEET 4 OF 12  
CHK. BY:

DATE: \_\_\_\_\_ BY: \_\_\_\_\_  
PLAN SURVEYED: \_\_\_\_\_  
NOTE BOOK: \_\_\_\_\_  
ALIGNED: \_\_\_\_\_  
CHECKED: \_\_\_\_\_  
DATE: \_\_\_\_\_

DATE: \_\_\_\_\_ BY: \_\_\_\_\_  
PROFILE SURVEYED: \_\_\_\_\_  
NOTE BOOK: \_\_\_\_\_  
CHECKED: \_\_\_\_\_  
DATE: \_\_\_\_\_

APPROVALS  
LAS VEGAS CITY ENGINEER  
LAS VEGAS FIELD ENGINEER  
DATE: 5-24-73

DATE: \_\_\_\_\_ BY: \_\_\_\_\_  
SCALE (H) 1"=50' SCALE (V) 1"=5' DATE 5-1-73  
JOB NO. 6743-14-8  
DR. J.P. SHEET 4 OF 12  
CHK. BY:

2017.56 1074-2026-5