

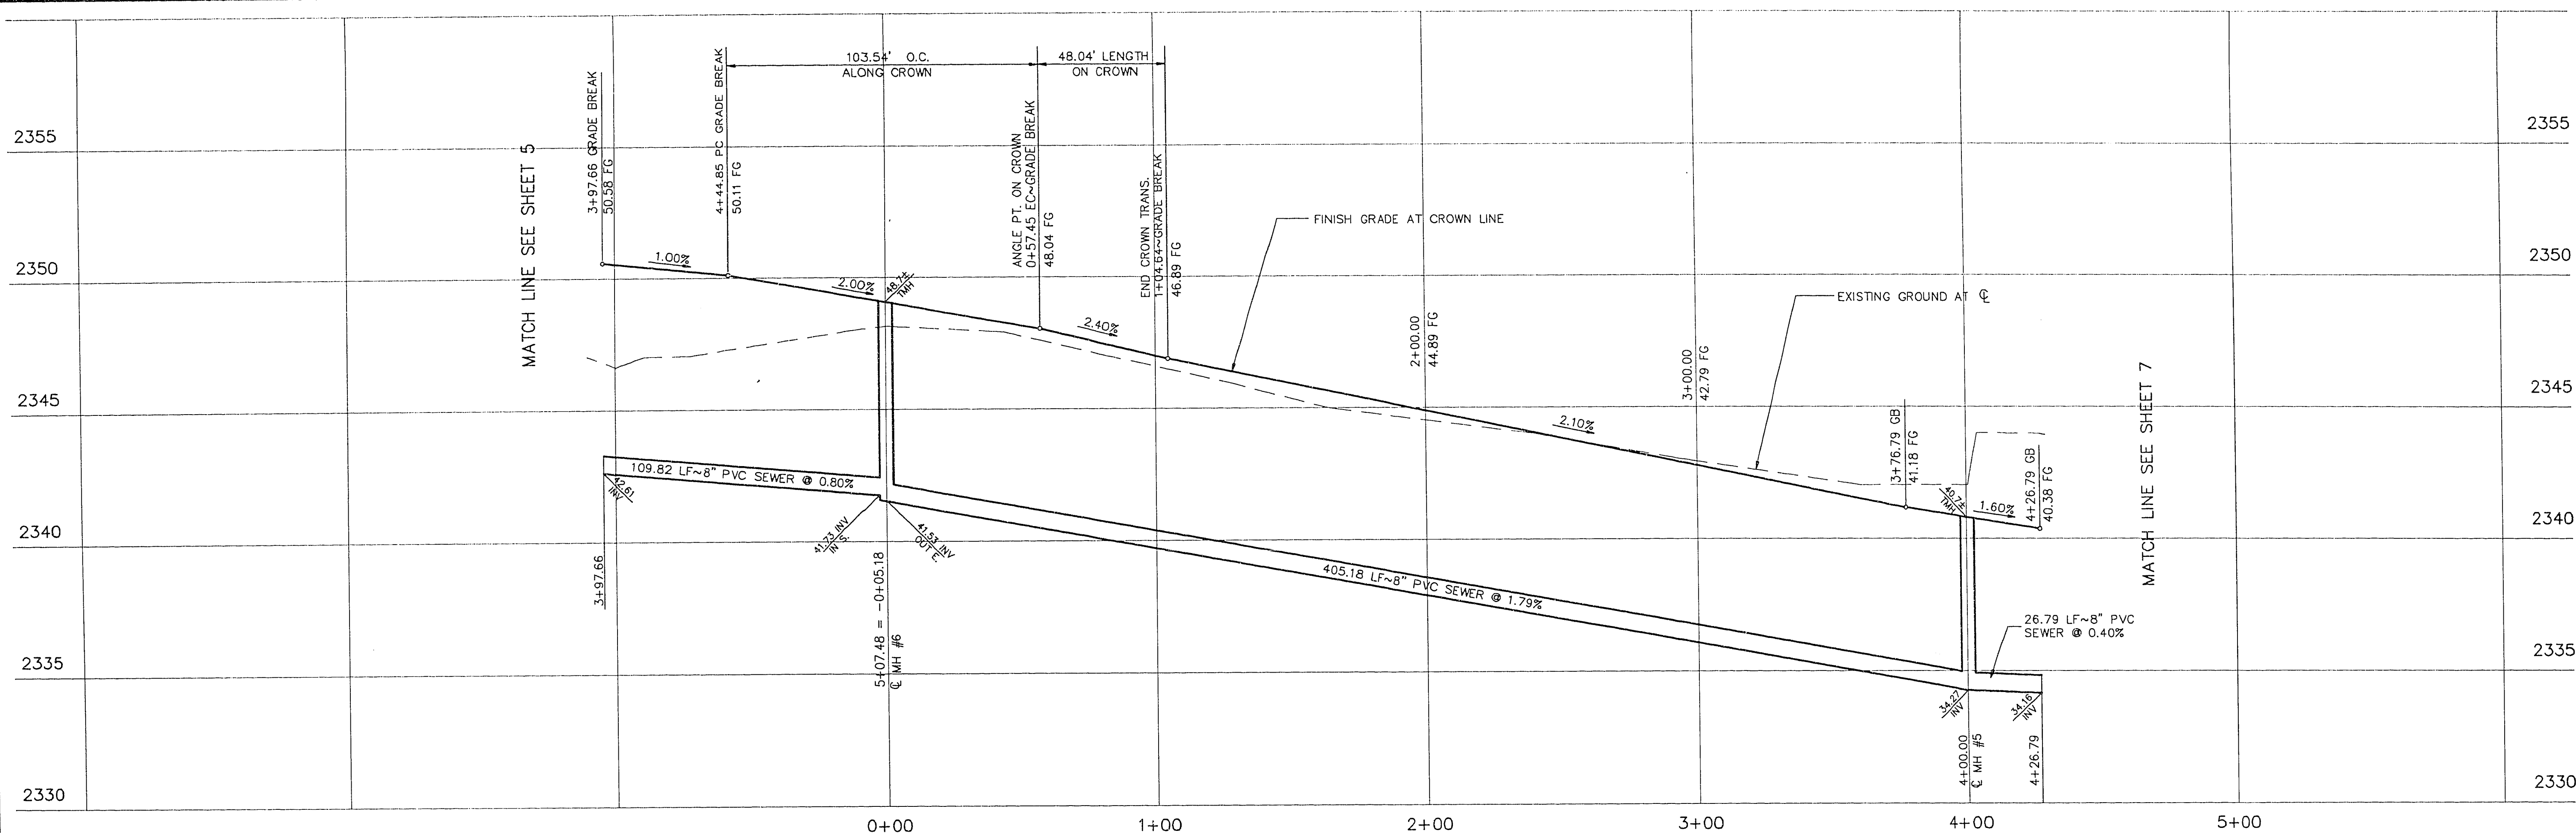
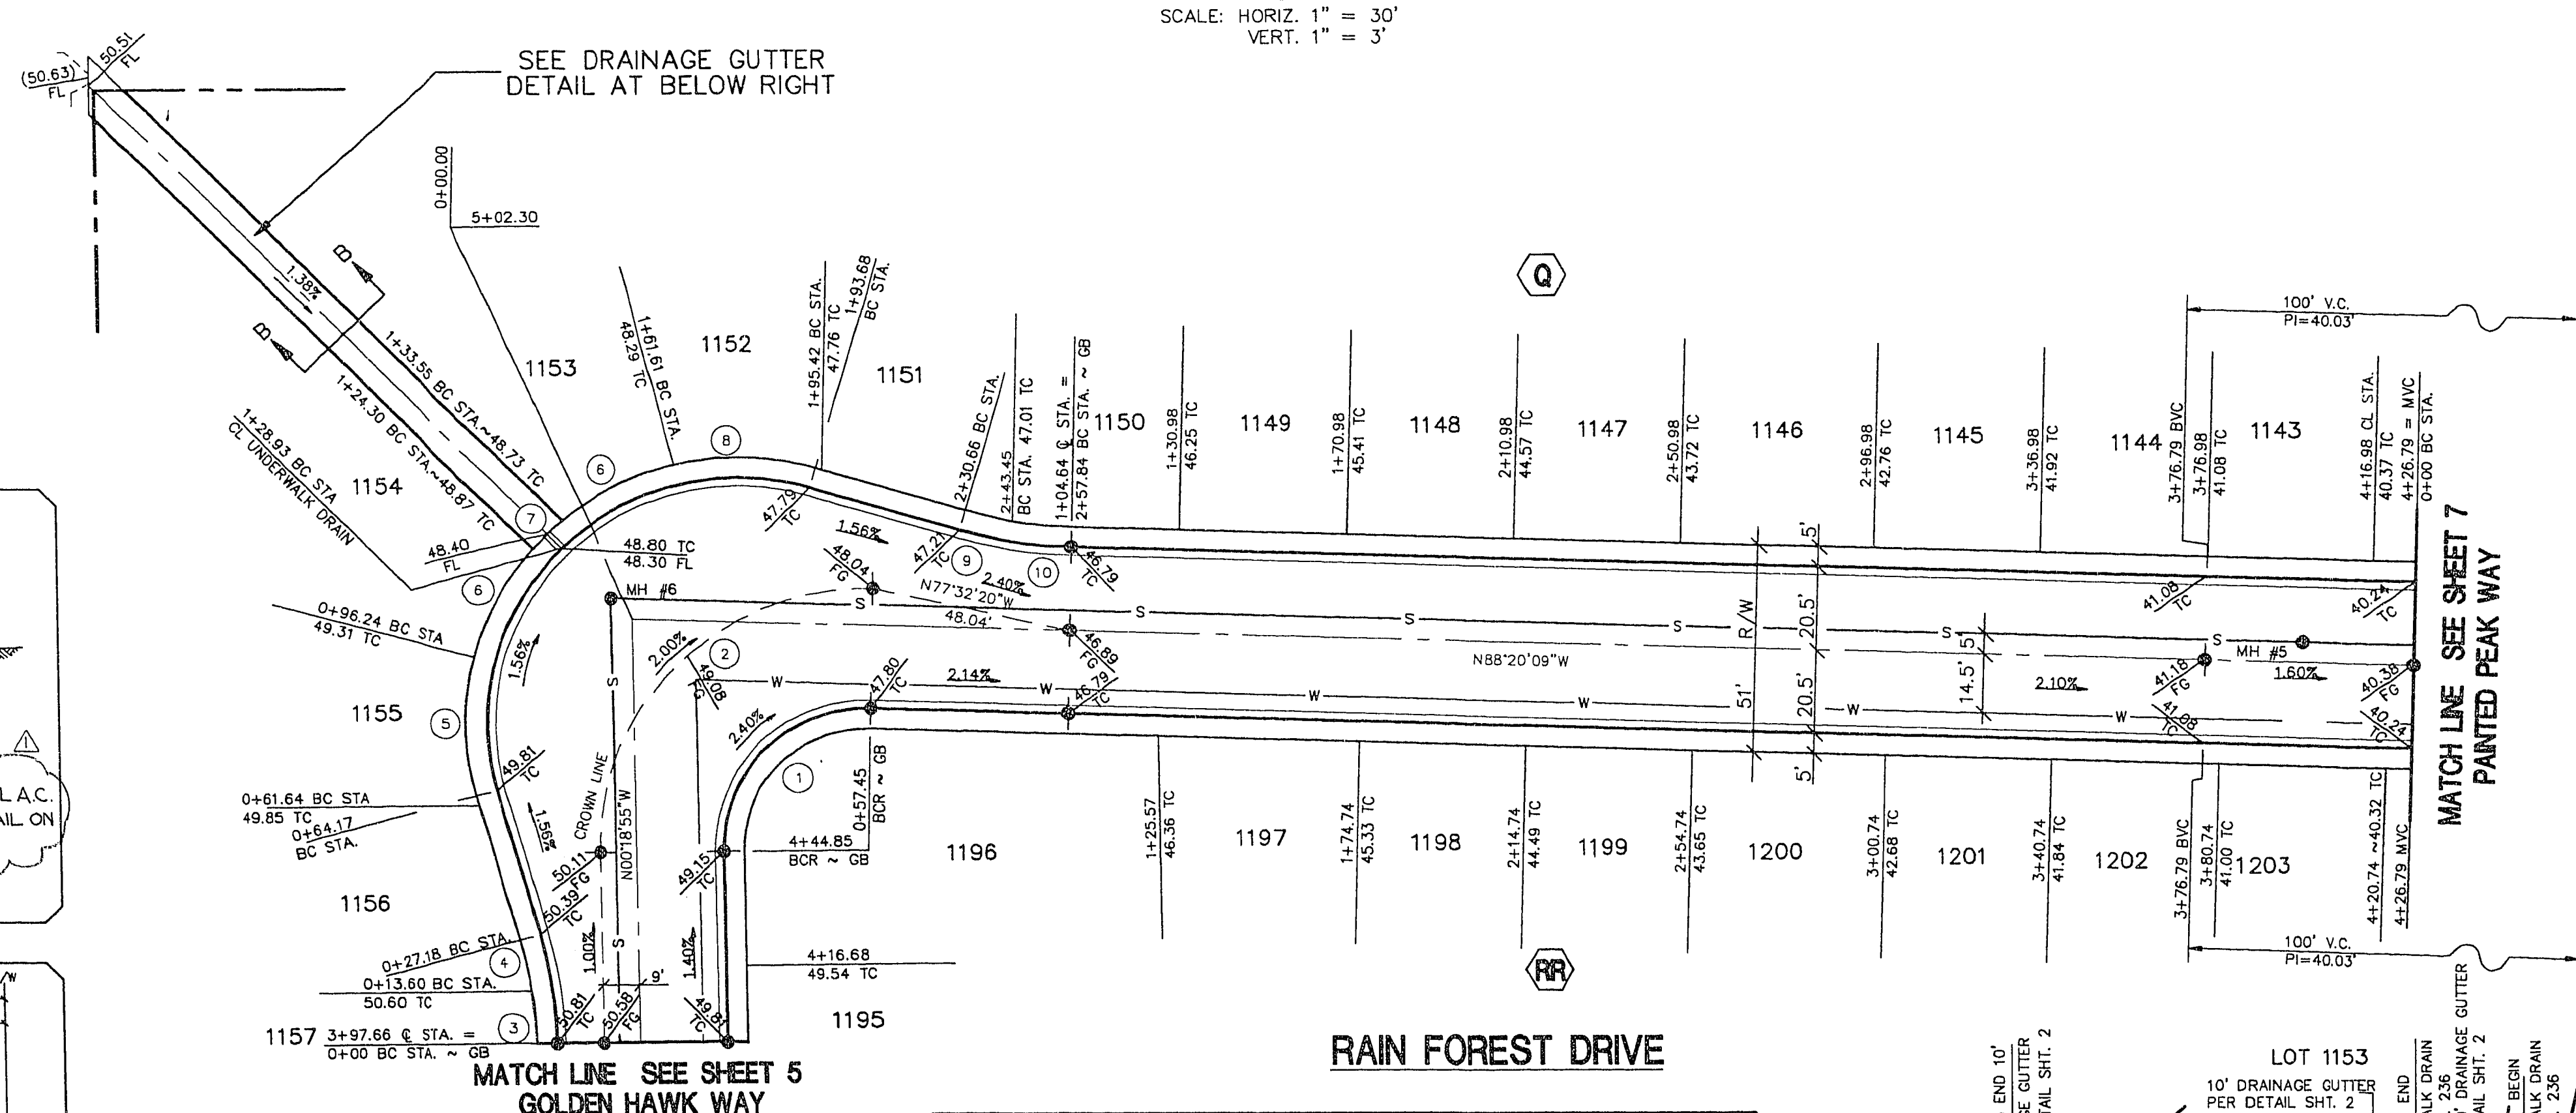
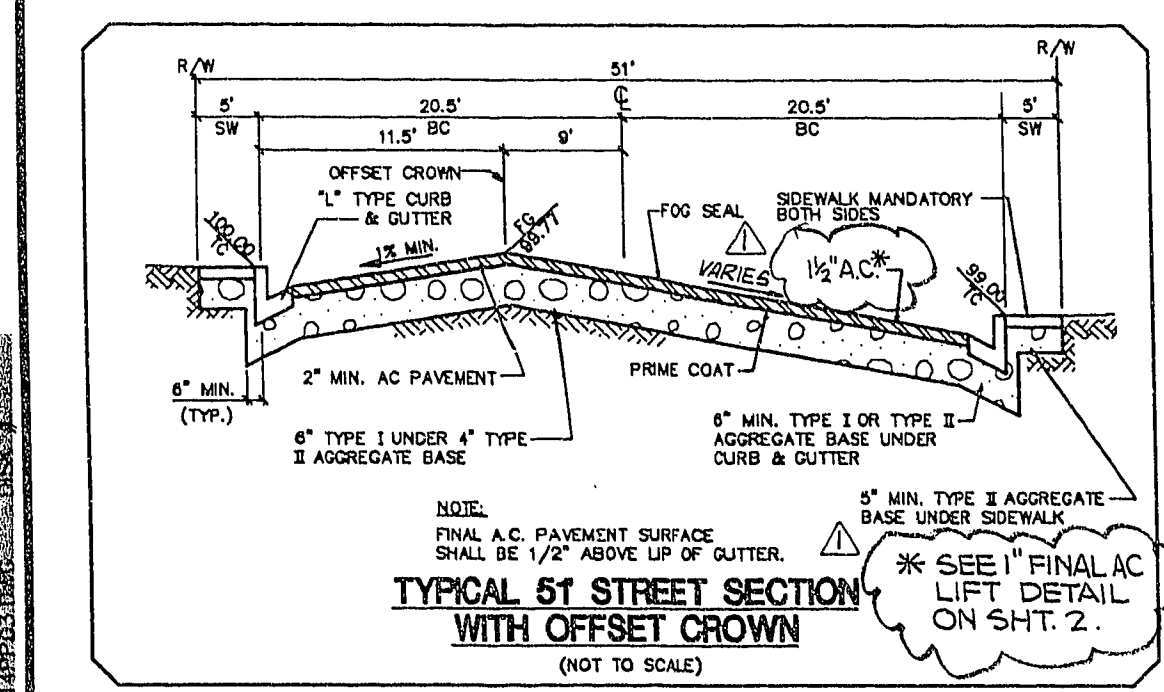


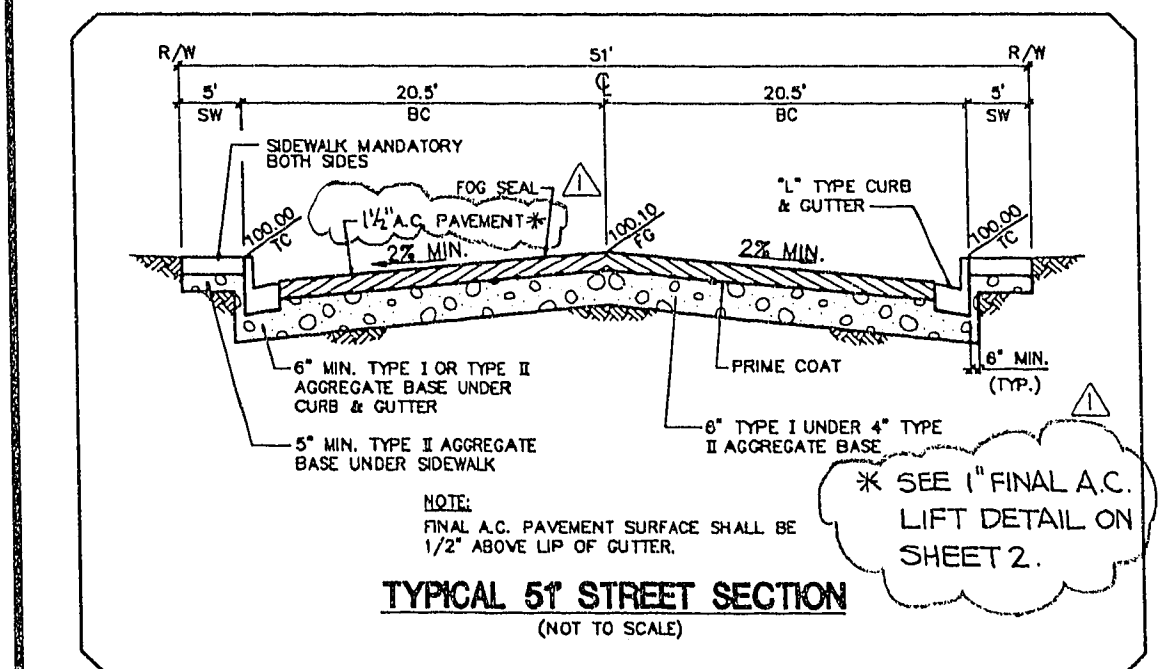




PROFILE
SCALE: HORIZ. 1" = 30'
VERT. 1" = 3'

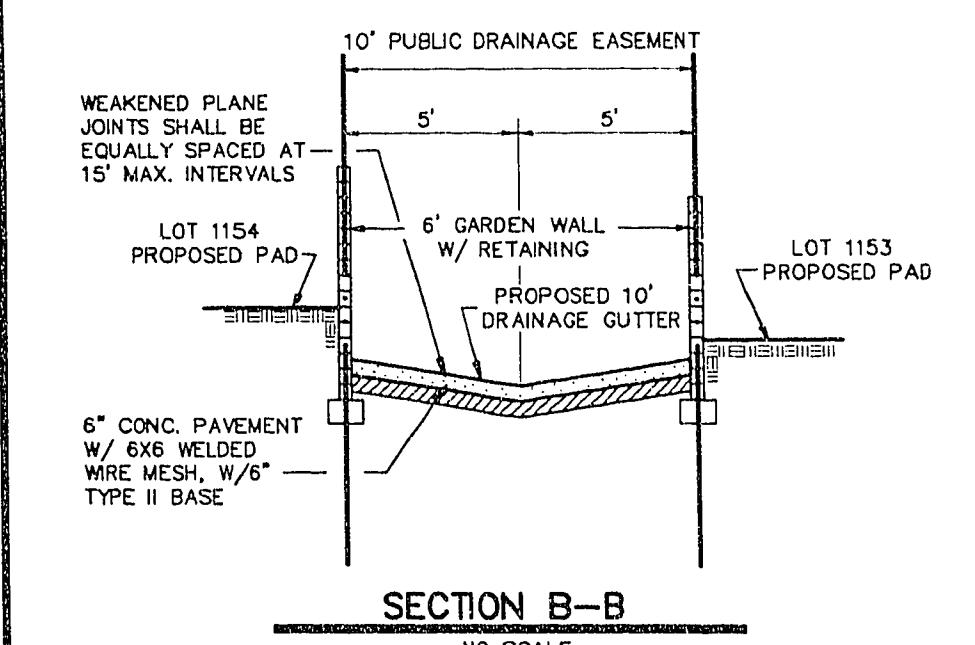

CURVE DATA

DESC.	CURVE	DELTA	RADIUS	LENGTH	TANGENT
BCR	1	91°58'46"	35.00	56.19	36.23
CROWN	2	91°58'46"	64.50	103.54	66.77
BC	3	07°03'51"	105.00	12.95	6.48
BC	4	07°46'08"	105.00	14.24	7.13
BC	5	30°07'37"	61.00	32.70	16.42
BC	6	26°20'05"	61.00	28.04	14.27
BC	7	08°11'22"	61.00	9.25	4.63
BC	8	30°07'37"	61.00	32.07	16.42
BC	9	07°21'15"	105.00	13.48	6.75
BC	10	07°28'44"	105.00	13.71	6.86
BC	11	26°21'08"	61.00	28.08	14.28

- NOTES**
- ALL STATIONING IS CENTERLINE STATIONING UNLESS OTHERWISE NOTED.
 - ALL SEWER LENGTHS ARE FROM MANHOLE CENTER TO MANHOLE CENTER.
 - CROSS GUTTERS WITH A GRADE OF ONE PERCENT (1%) OR LESS SHALL BE CHECKED FOR GRADE PRIOR TO CONSTRUCTION AND WATER TESTED AS SOON AS POSSIBLE AFTER CONSTRUCTION. IT IS THE RESPONSIBILITY OF THE CONTRACTOR TO ENSURE PROPER DRAINAGE ACROSS ALL CROSS GUTTERS.

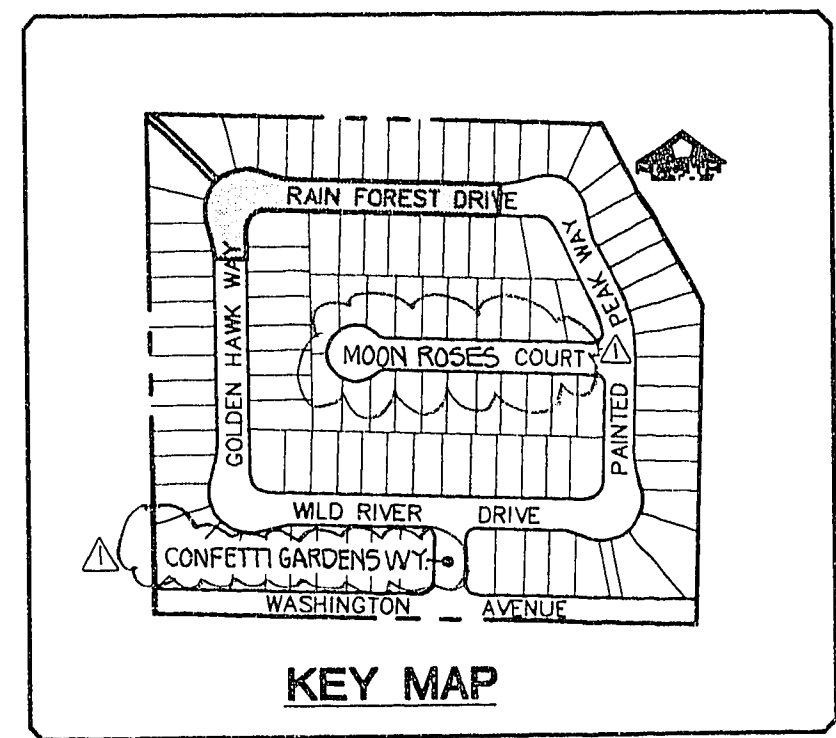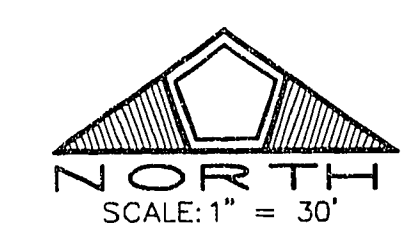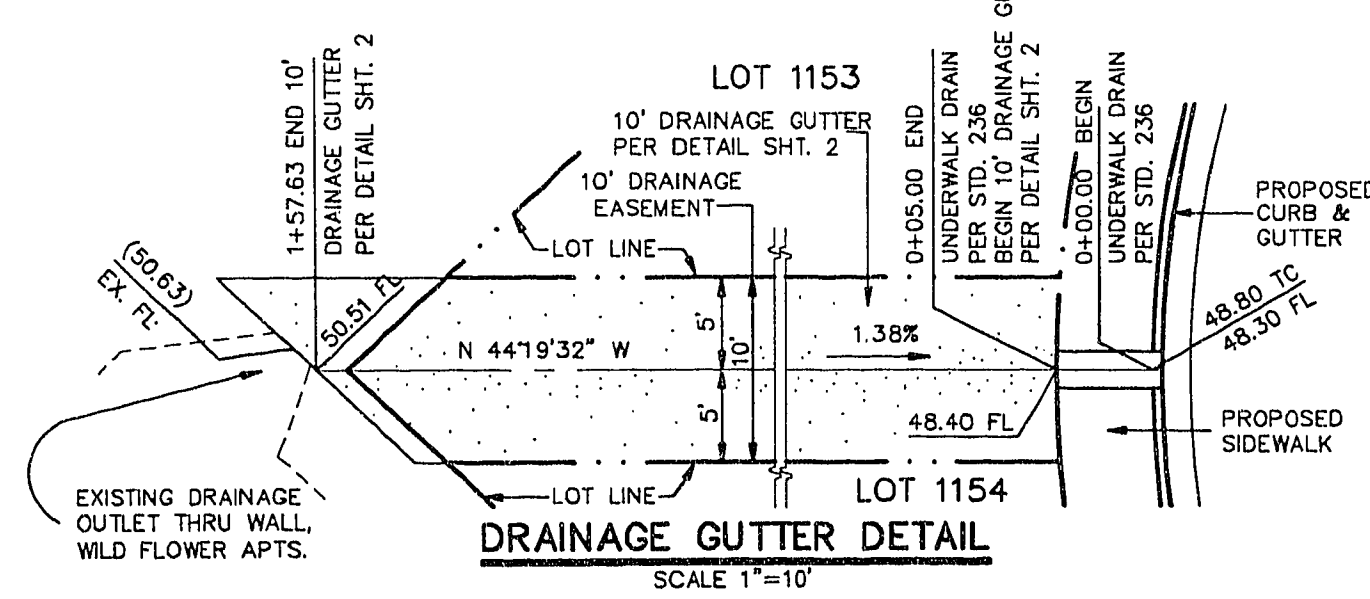

Avoid cutting underground utility lines. It's costly.

Call before you Dig.

1-800-227-2800

UNDERGROUND SERVICE ALERT (USA)

REVISIONS

NO.	DESCRIPTION	DATE
1	REVISED STREET NAMES & PAVEMENT THICKNESS IN SECTIONS.	7-19-12

DATE: 6/12/12

DRAWN BY: KW

DESIGNED BY: MC

CHECKED BY: GR

JOB NO.: 030.117D

SCALE: 1"=30'

PENTACORE

Engineering, Inc.

6763 West Charleston Boulevard
Las Vegas, Nevada 89102

LEWIS HOMES OF NEVADA

RAINBOW VISTA NO. 14

RAIN FOREST DRIVE

PLAN AND PROFILE

SHEET

6

OF 11

26-7-7

107Y-2032-14