
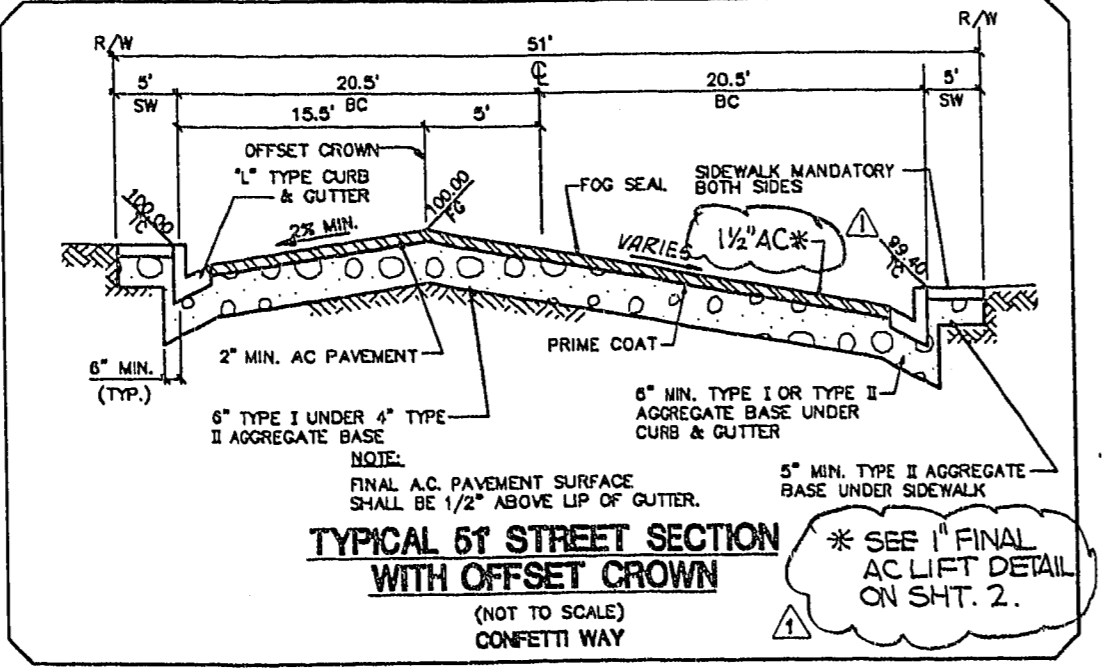
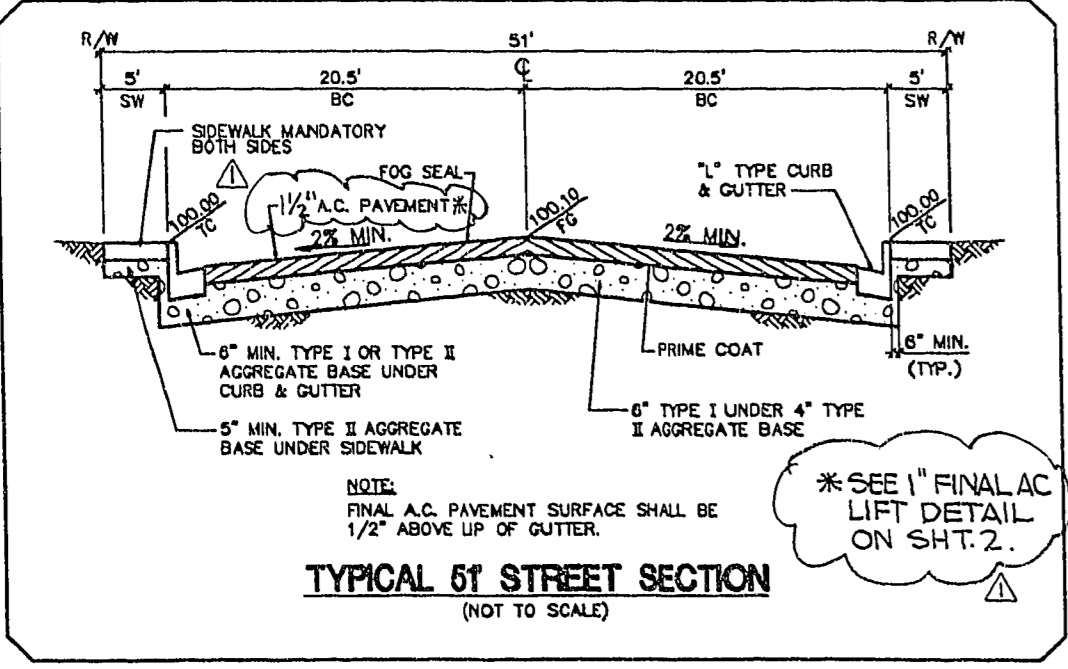
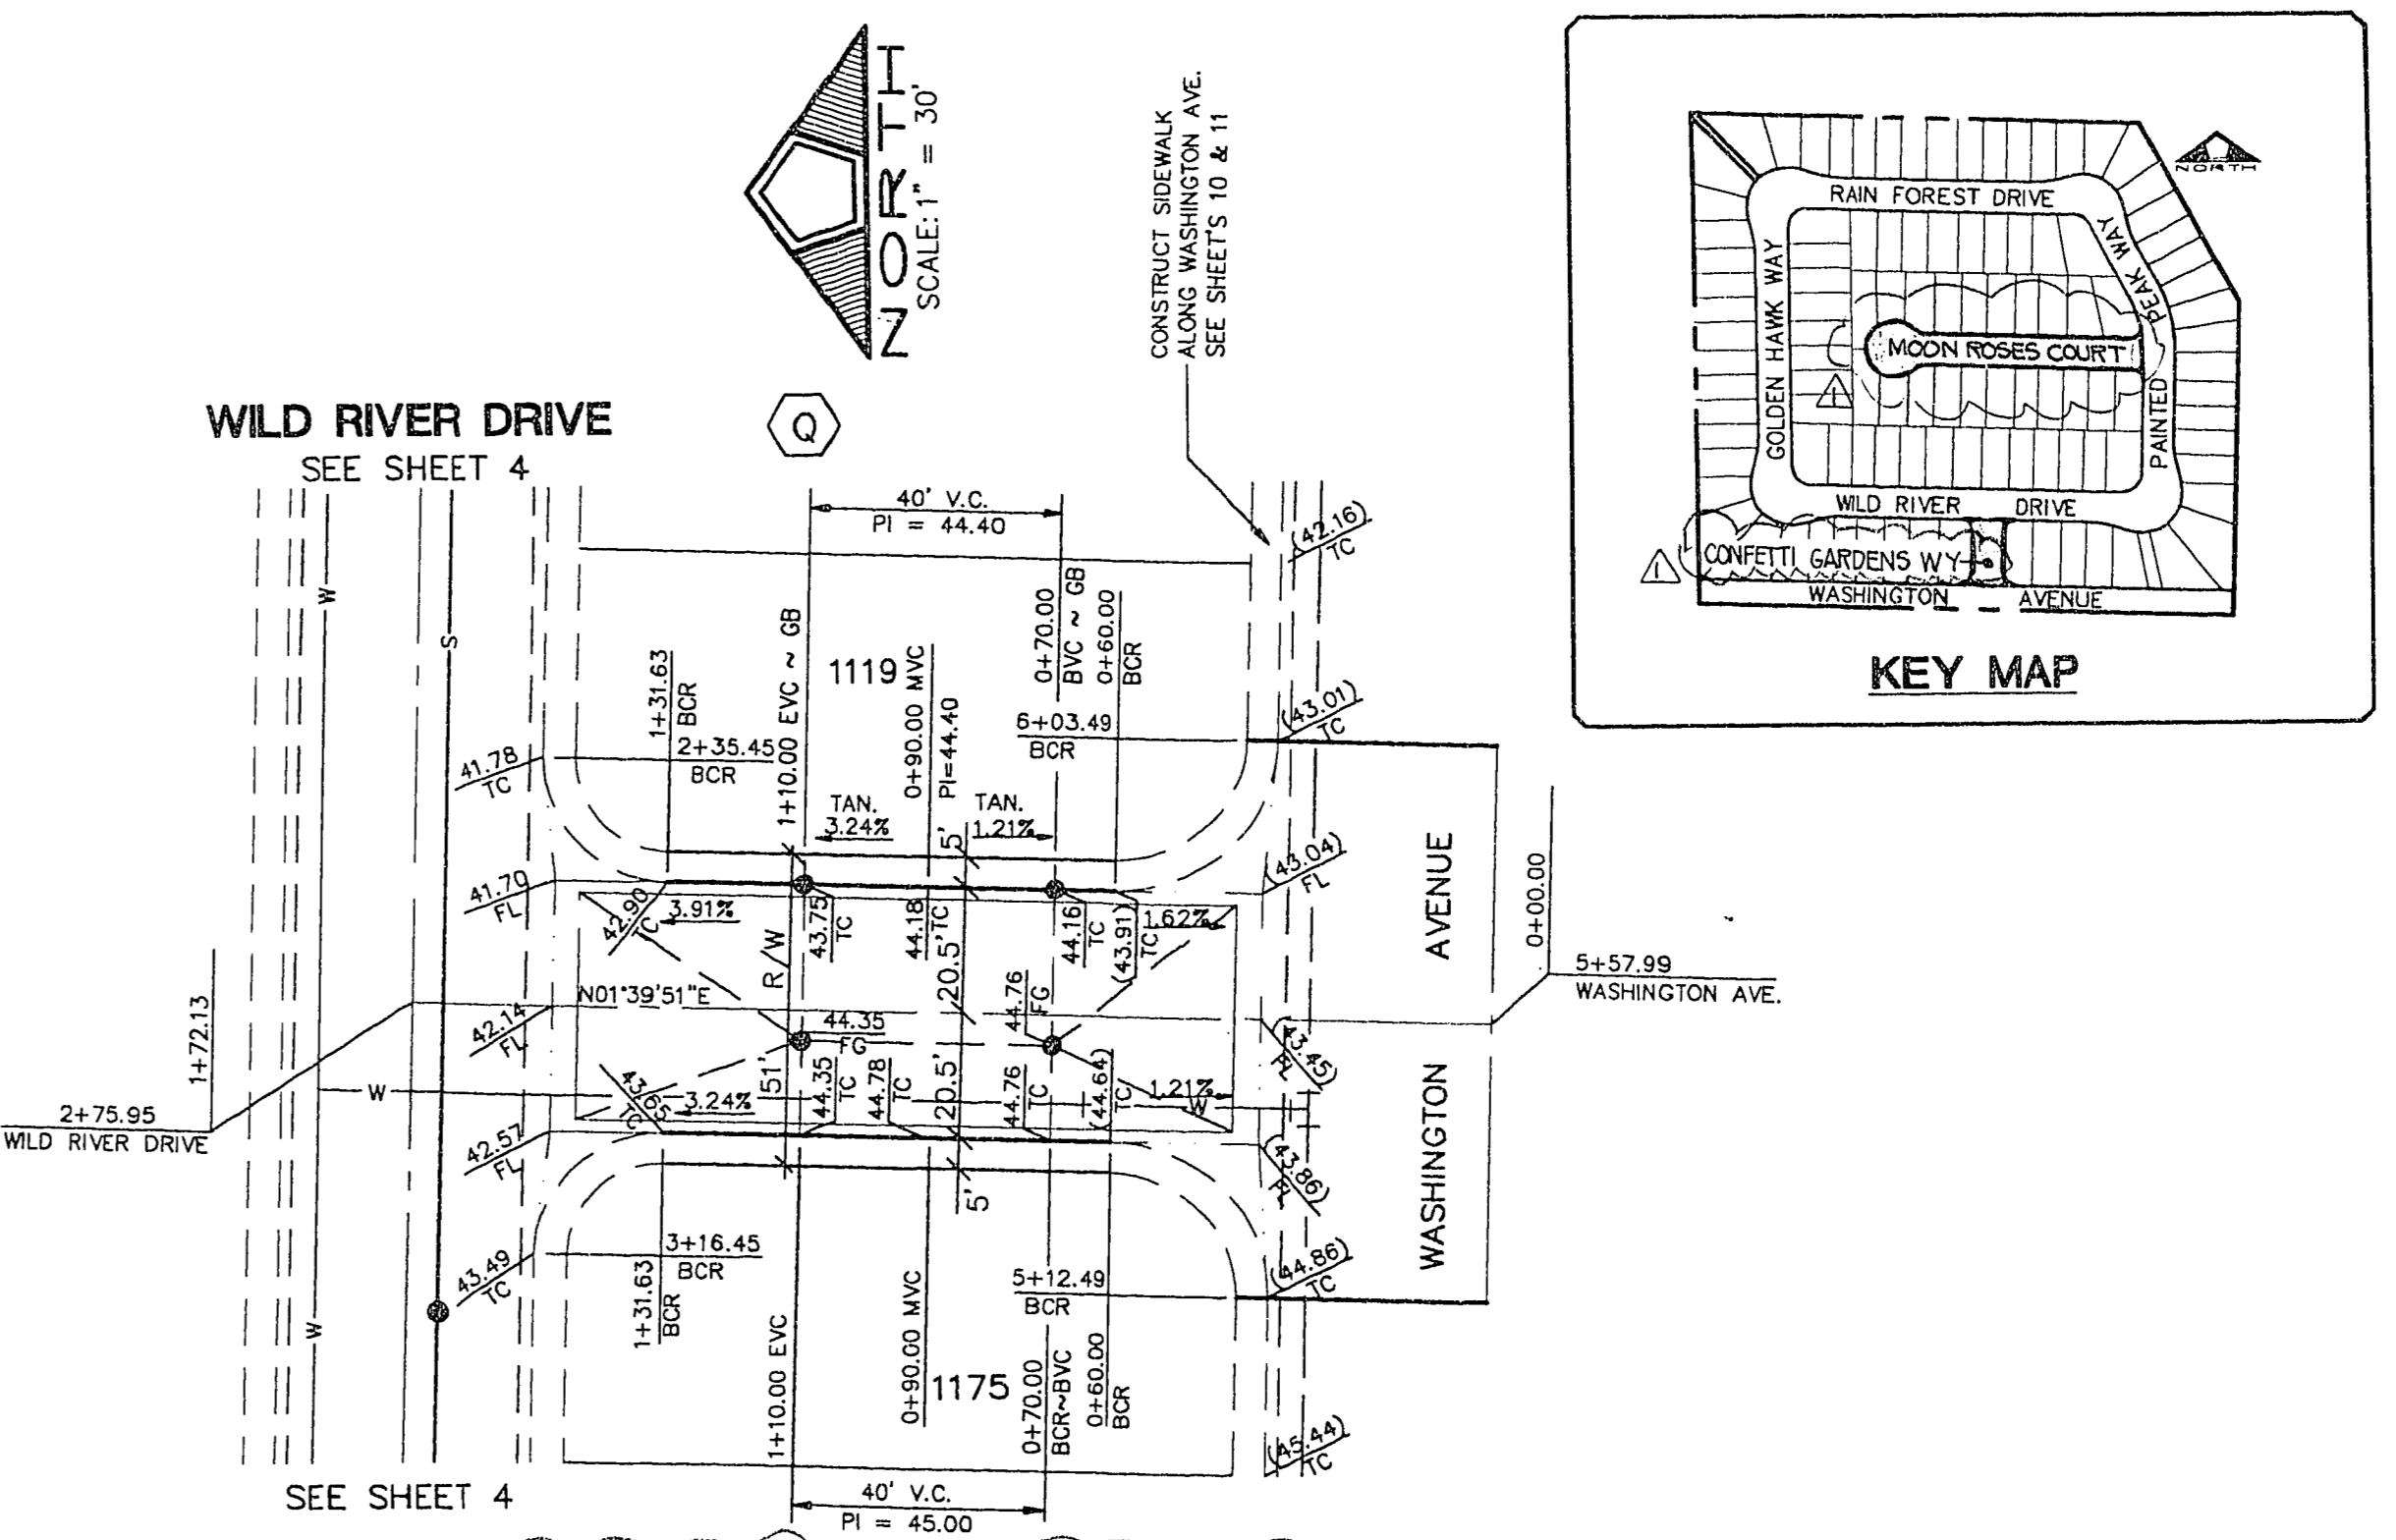
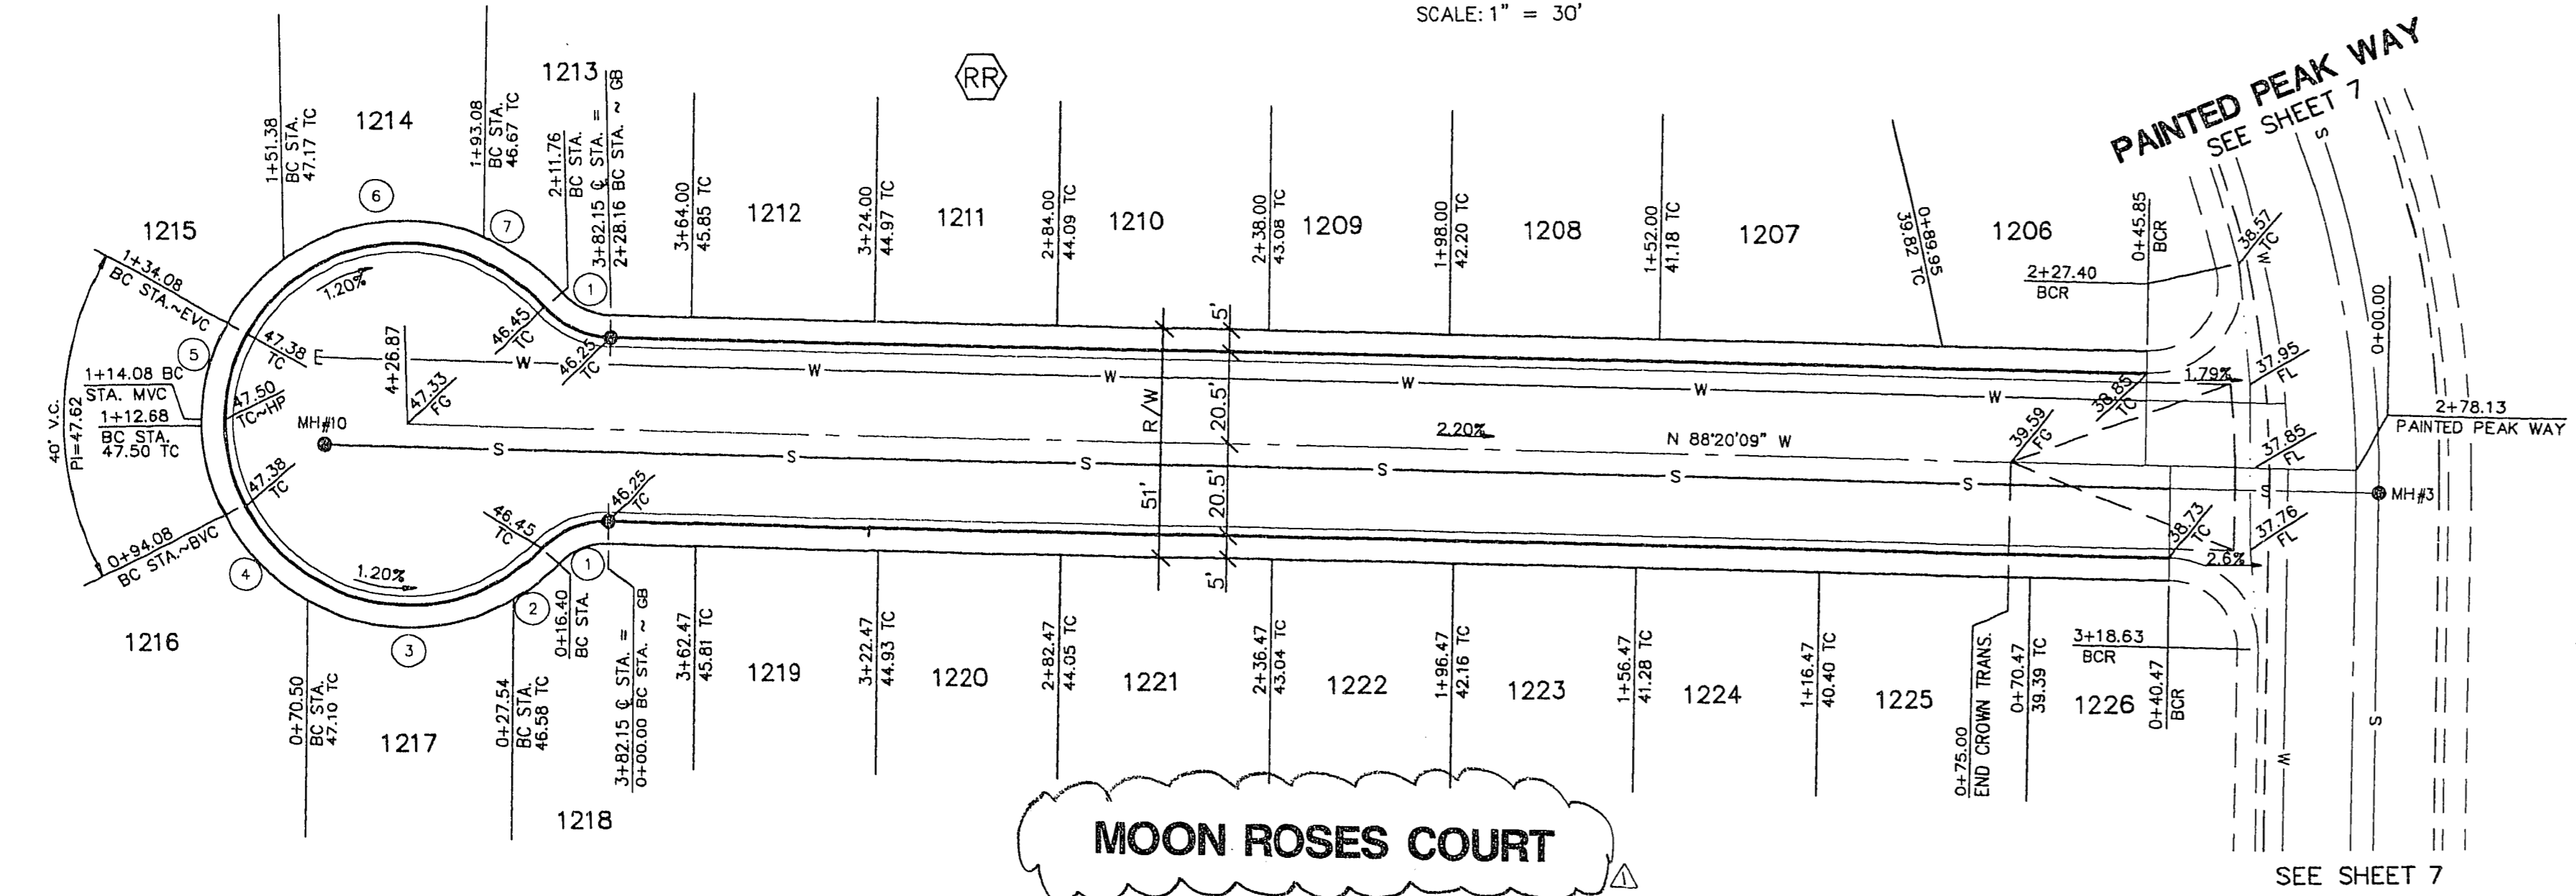


PROFILE
SCALE: HORIZ. 1" = 30'
VERT. 1" = 3'

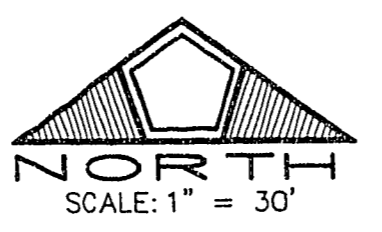

- NOTES**
1. ALL STATIONING IS CENTERLINE STATIONING UNLESS OTHERWISE NOTED.
 2. ALL SEWER LENGTHS ARE FROM MANHOLE CENTER TO MANHOLE CENTER.
 3. CROSS GUTTERS WITH A GRADE OF ONE PERCENT (1%) OR LESS SHALL BE CHECKED FOR GRADE PRIOR TO CONSTRUCTION AND WATER TESTED AS SOON AS POSSIBLE AFTER CONSTRUCTION. IT IS THE RESPONSIBILITY OF THE CONTRACTOR TO ENSURE PROPER DRAINAGE ACROSS ALL CROSS GUTTERS.

CURVE DATA

DESC.	CURVE	DELTA	RADIUS	LENGTH	TANGENT
BC	1	4811.23'	18.50'	18.40'	8.72'
BC	2	1349.41'	40.50'	11.14'	5.51'
BC	3	6048.18'	40.50'	42.98'	23.79'
BC	4	5940.40'	40.50'	42.18'	23.23'
BC	5	5434.41'	40.50'	38.70'	20.23'
BC	6	5859.43'	40.50'	41.70'	22.91'
BC	7	2675.38'	40.50'	18.68'	9.51'

Avoid cutting underground utility lines. It's costly.

Call before you Dig.

1-800-227-2600
UNDERGROUND SERVICE ALERT (USA)

RECOMMENDED: DEAN W. BRUSHUSA, P.E., CIVIL ENGINEER, LICENSE NO. 100,819, STATE OF NEVADA. DATE: 6/12/02. REVISED STREET NAMES & PAVEMENT THICKNESS IN SECTIONS. NO. DESCRIPTION. DATE.

DATE: 6/12/02
DRAWN BY: KW
DESIGNED BY: UC
CHECKED BY: GR
JOB NO.: 030.170
SCALE: 1"=30'

PENTACORE
Engineering, Inc.
6763 West Charleston Boulevard
Las Vegas, Nevada 89102
(702) 258-0115

LEWIS HOMES OF NEVADA
RAINBOW VISTA NO. 14
MOON ROSES CT. & CONFETTI GARDENS WAY
PLAN AND PROFILE

SHEET **8** OF 11

26.79

1071-2032-14