
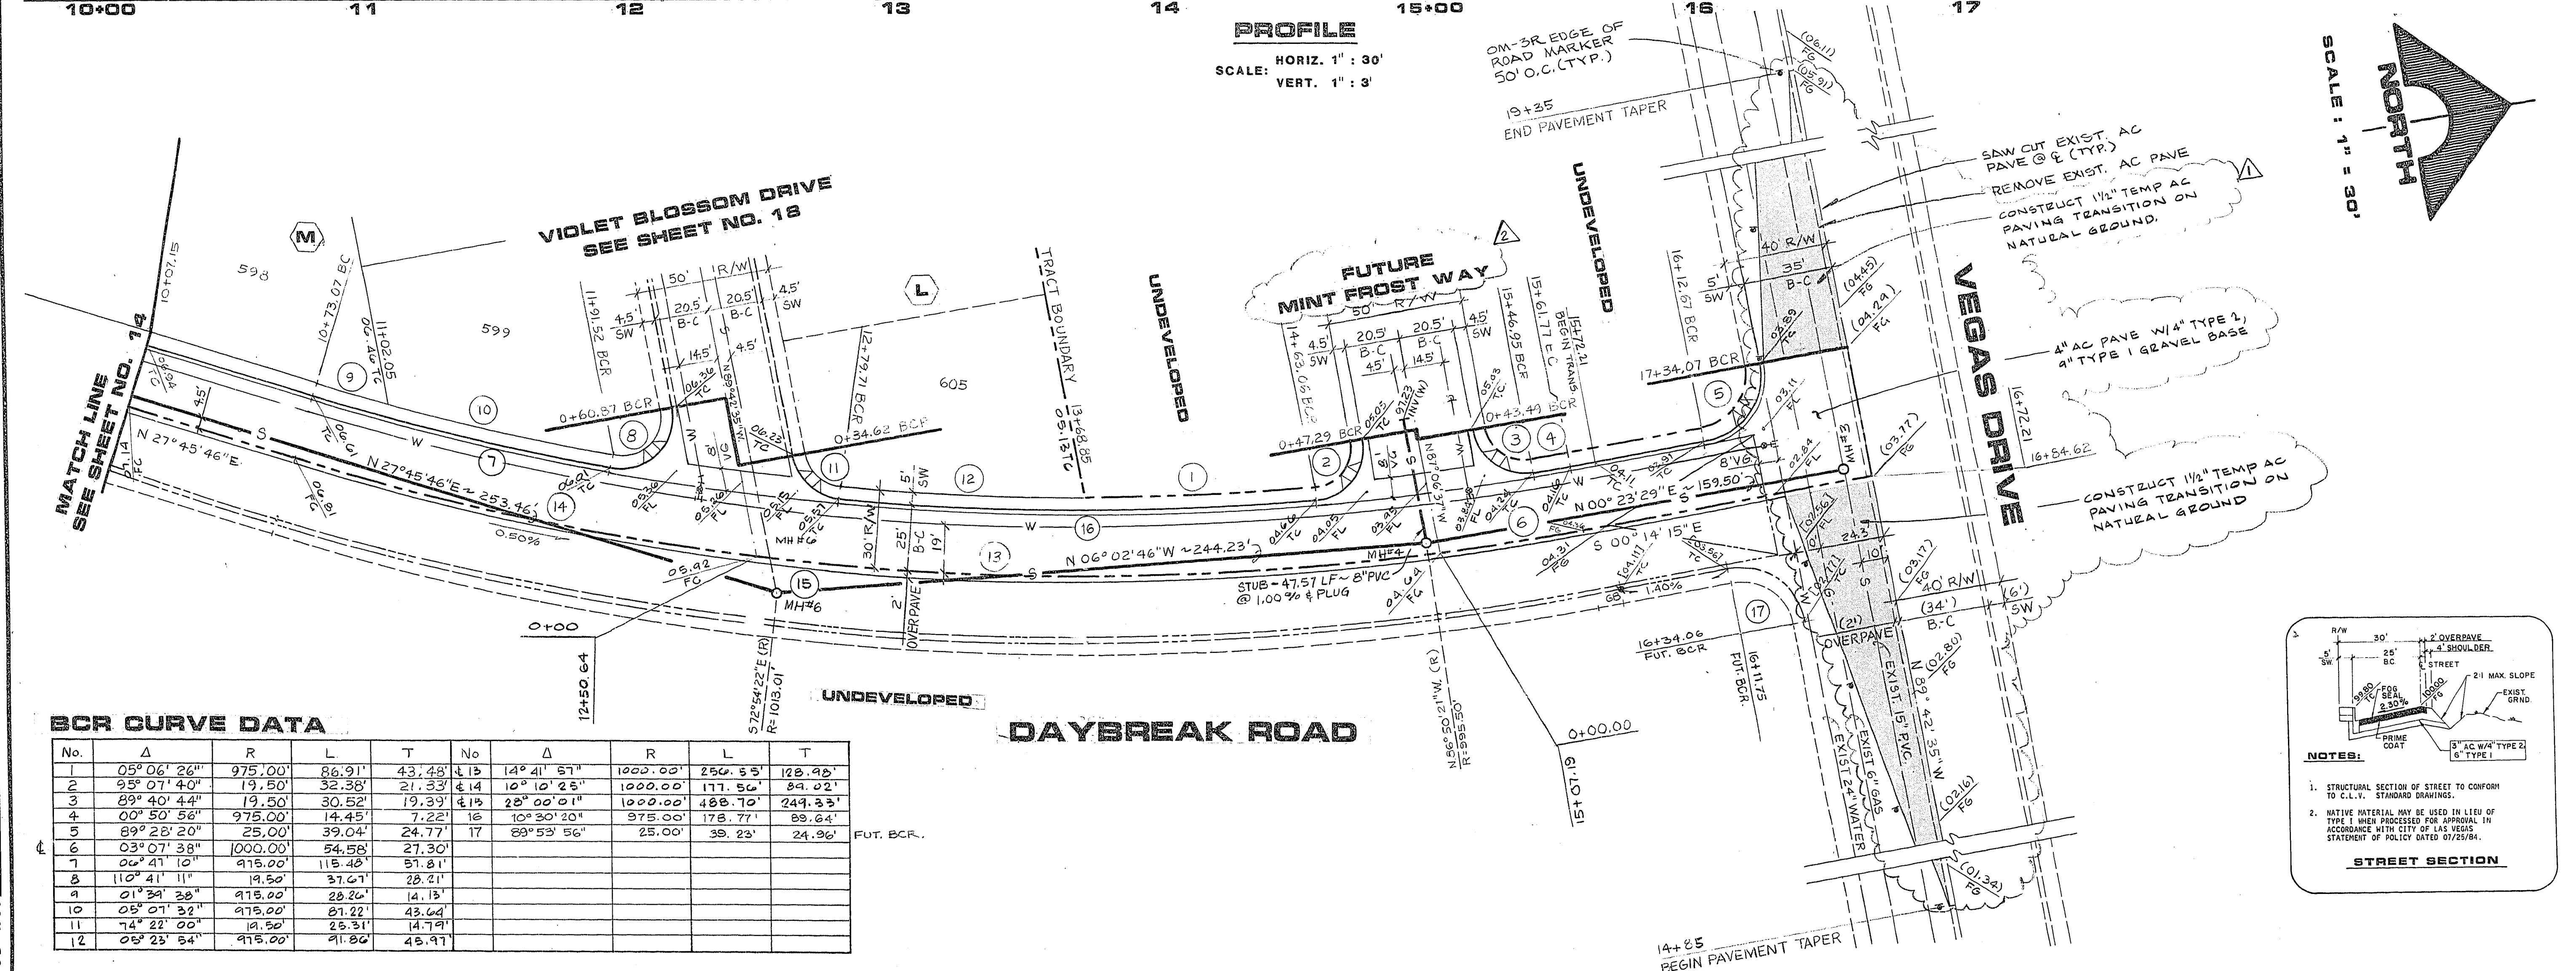


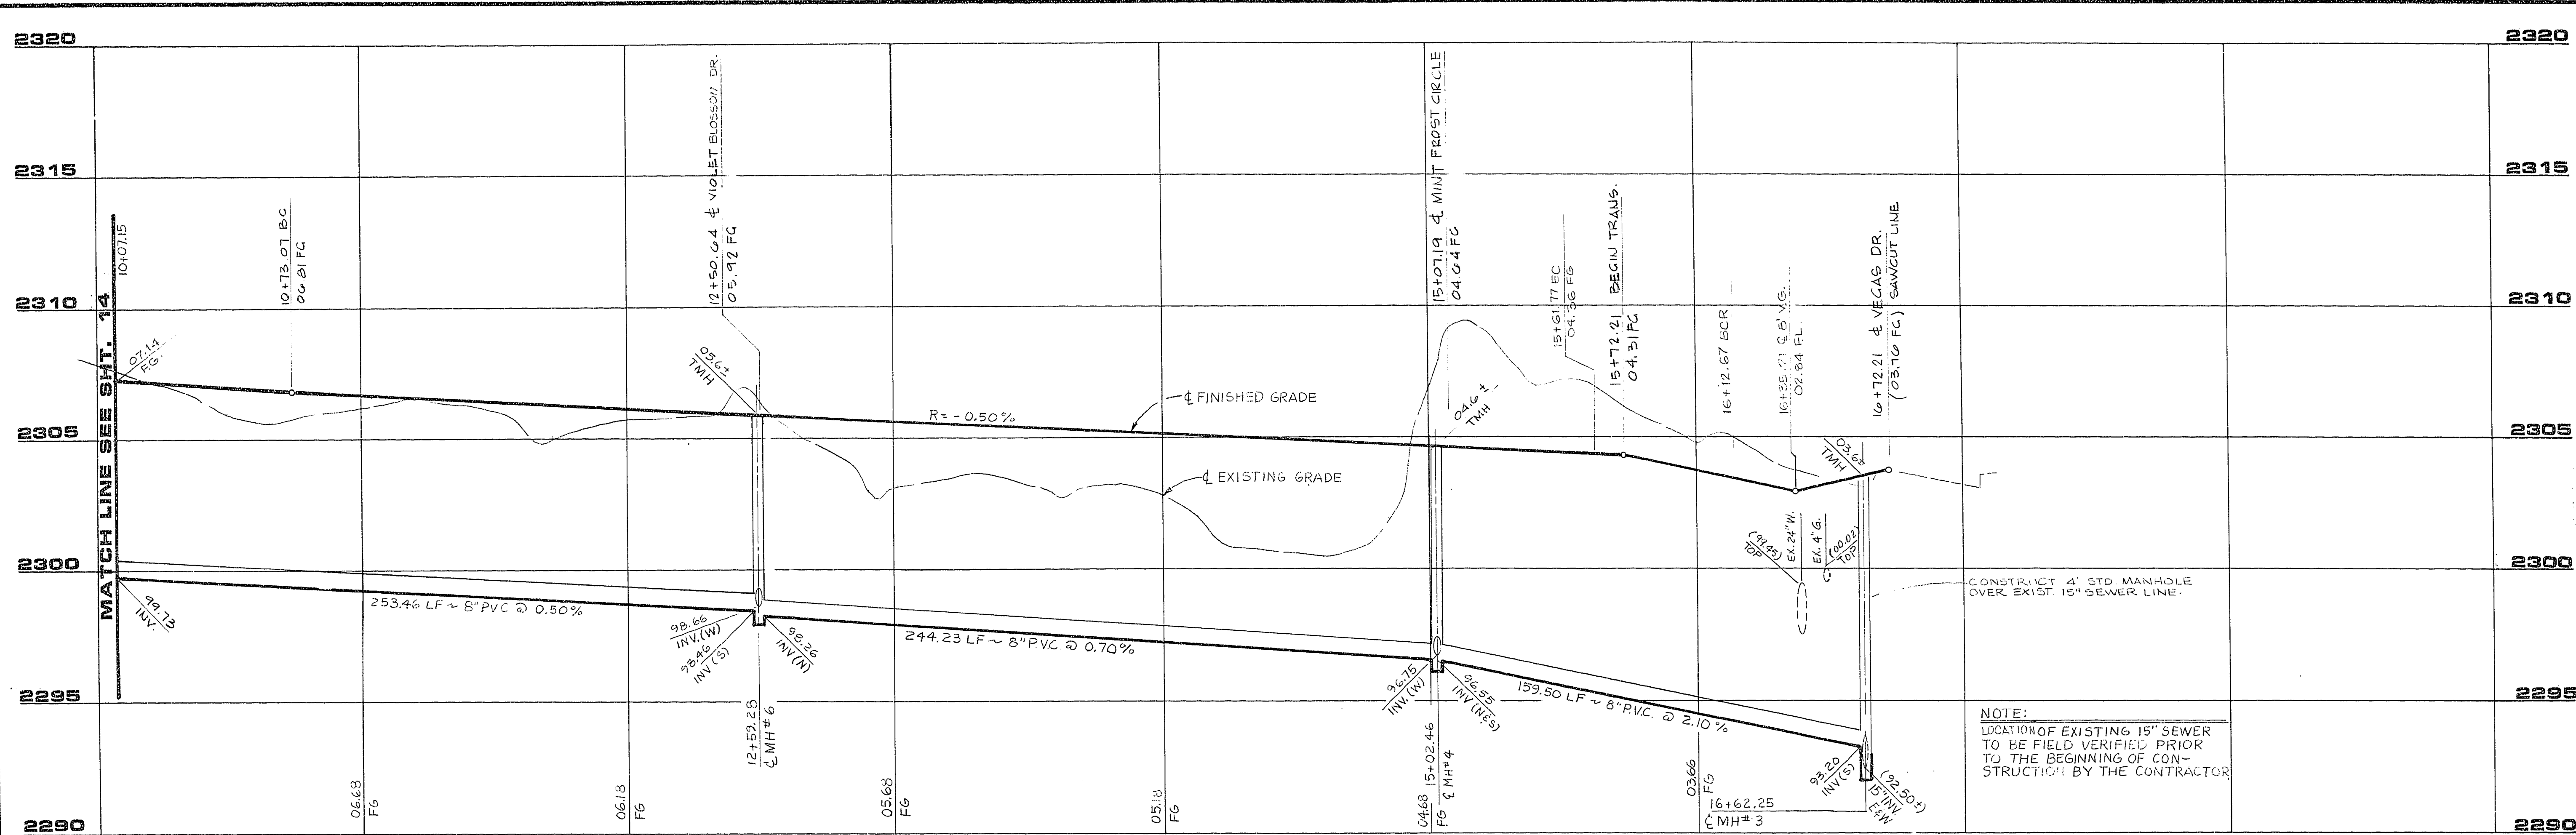

BCR CURVE DATA											
No.	Δ	R	L	T	No	Δ	R	L	T	No	Δ
1	05° 06' 26"	975.00'	86.91'	43.48'	13	14° 41' 57"	1000.00'	250.53'	128.95'	1	05° 06' 26"
2	95° 07' 40"	19.50'	32.38'	21.33'	14	10° 10' 25"	1000.00'	177.56'	89.02'	2	95° 07' 40"
3	89° 40' 44"	19.50'	30.52'	19.39'	15	28° 00' 01"	1000.00'	488.70'	249.33'	3	89° 40' 44"
4	00° 50' 56"	975.00'	14.45'	7.22'	16	10° 30' 20"	975.00'	178.77'	89.64'	4	00° 50' 56"
5	89° 28' 20"	25.00'	39.04'	24.77'	17	89° 53' 56"	25.00'	39.23'	24.36'	5	89° 28' 20"
6	03° 07' 38"	1000.00'	54.58'	27.30'							

RECOMMENDED
DATE
3-7-89
BY
DAVID P. NUCKLE
R.E. NO.
5255

DESCRIPTION
1. 11/89 ADDED TEMP. A.C. PAVING
2. 11/89 ADDED TEMP. A.C. PAVING
155 SOUTH RAINBOW BLVD., LAS VEGAS, NEVADA 89102

G.C. WALLACE, INC.
Engineering/Architecture

LEWIS HOMES OF NEVADA
LEWIS HOMES - RAINBOW VISTA NO. 9
DAYBREAK ROAD

SHEET
15
OF 25 SHEETS