


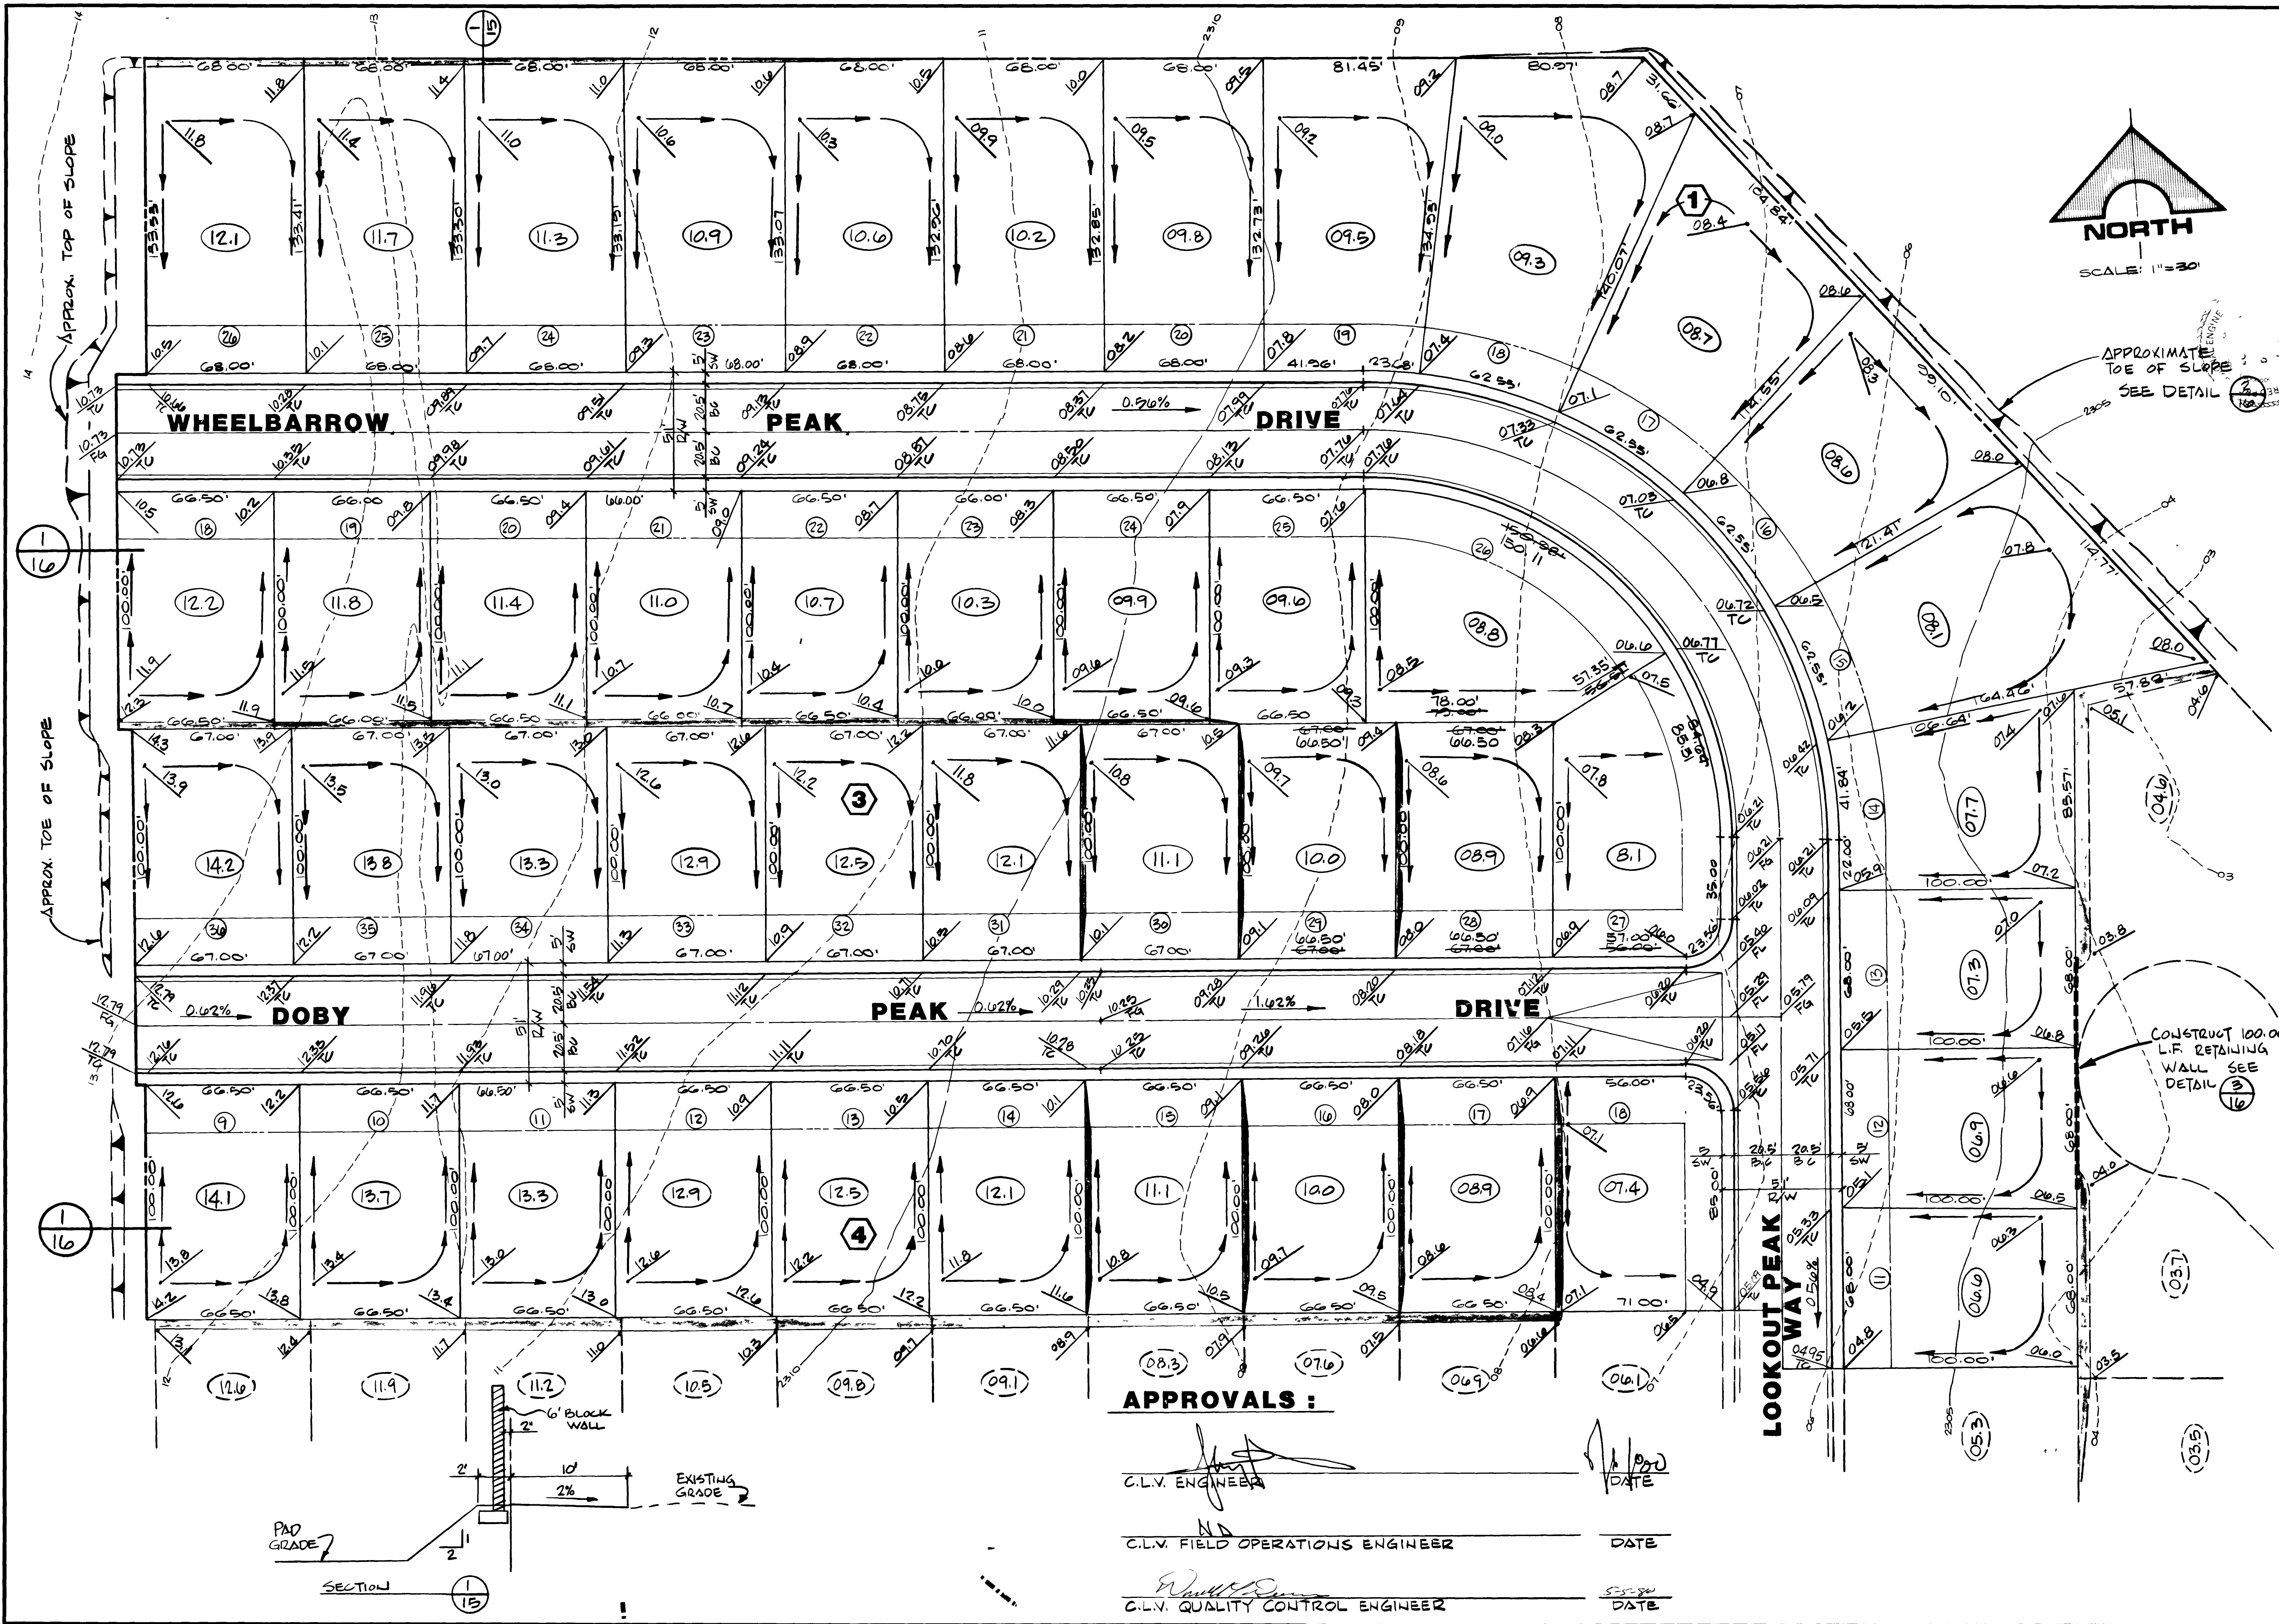

APPROVALS :

C.L.V. ENGINEER

C.L.V. FIELD OPERATIONS ENGINEER

C.L.V. QUALITY CONTROL ENGINEER

DATE

DATE

DATE

REV	DATE	DESCRIPTION
G.C. WALLACE
Consulting Engineers, Inc.

BEAUTY BUILT HOMES, INC.
LONE MOUNTAIN ESTATES UNIT NO. 1
GRADING PLAN II

SHEET
15
OF 16 SHEETS

