


B/C CURVE DATA


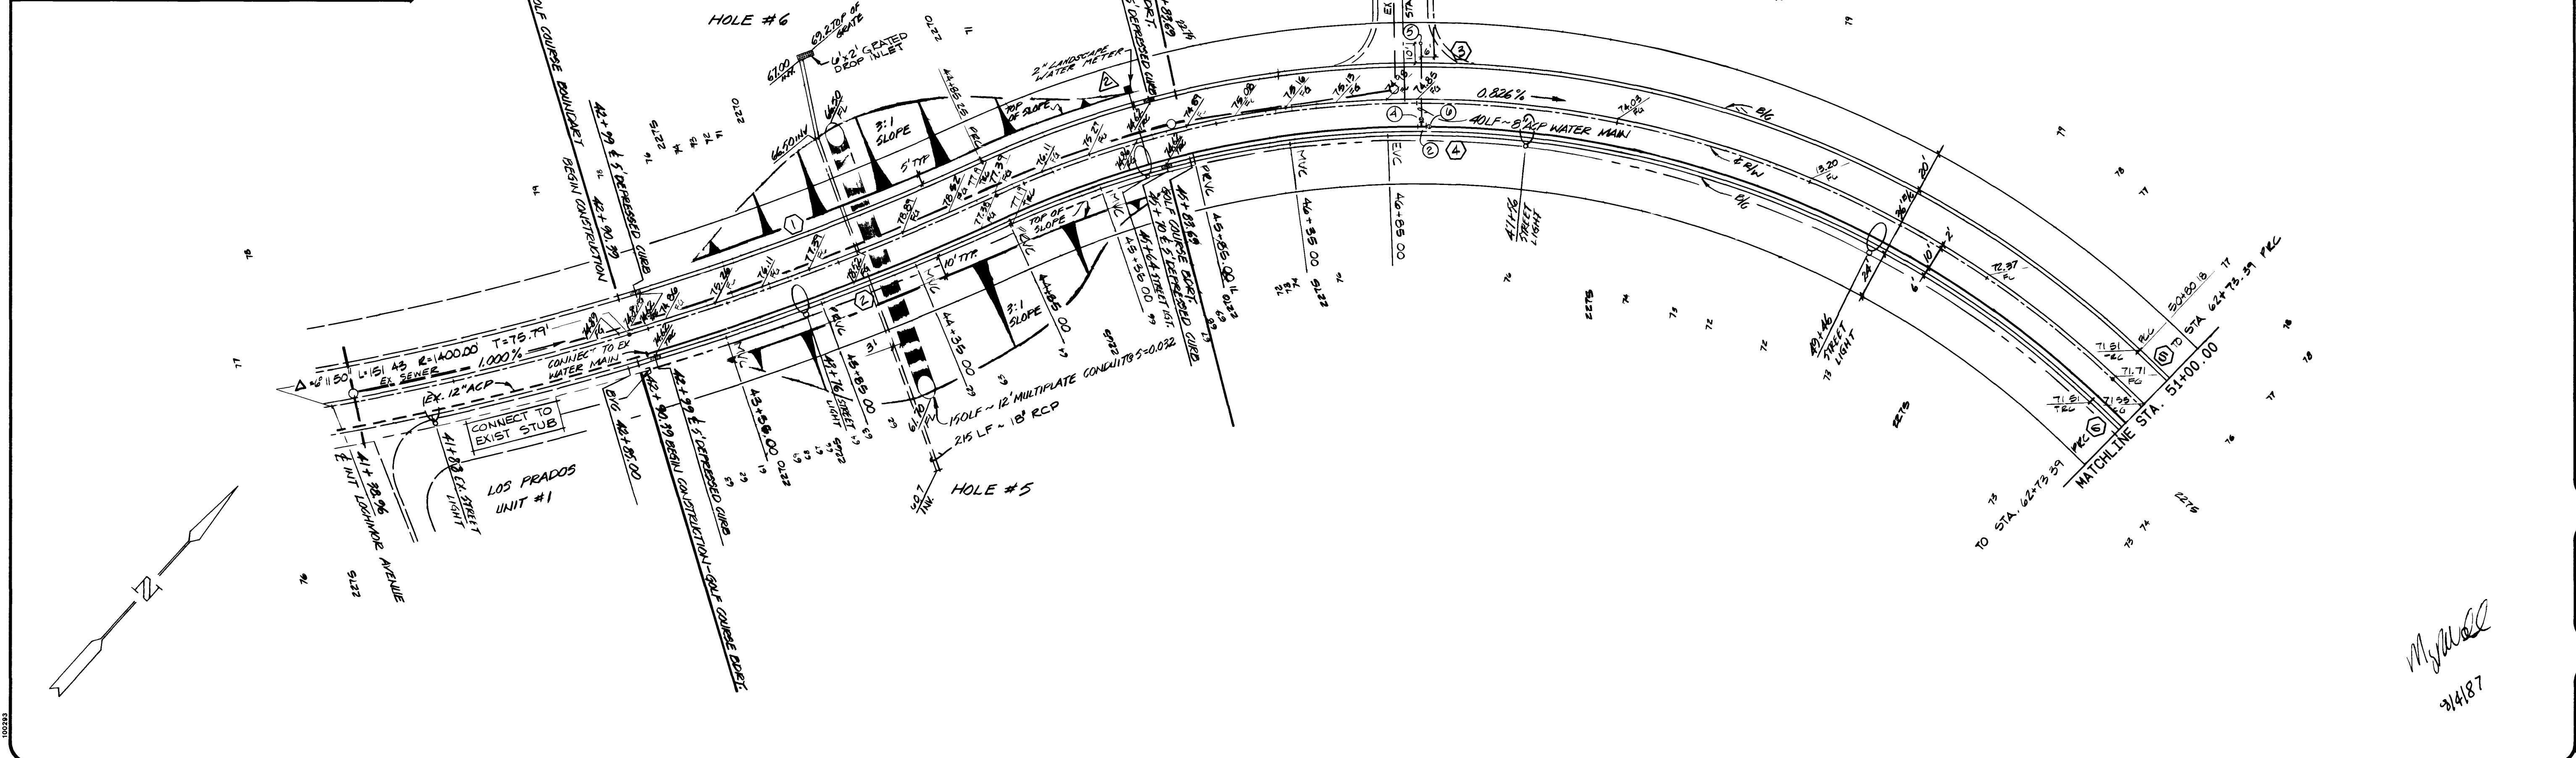

U.S. HOME CITY OF LAS VEGAS

REVISION

REV	DATE	BY	DESCRIPTION
1	9-25-98	KFF	LOCATE SINKS UNDER FUTURE STREETS
2	1-17-99	KFF	REVISE FINISH GRADES
3	6-21-99	KFF	ADD 2 LABORER WATER METER ADD STREET LIGHTS & CONDUIT

CONSULTING ENGINEERS - PLANNERS
2300 PASEO DEL PRADO BUILDING A SUITE 100
LAS VEGAS, NEVADA 89102 PHONE (702) 873-7550

vtn nevada

STREET PLAN & PROFILE
LOS PRADOS CIRCLE - STA. 42+89.39 TO 51+00

PROJECT
LOS PRADOS - PHASE 2

NO NO 3188-LP2-0

BY *GJR*

DATE

HORIZ.: 1"=40'
SCALE VERT.: 1"=8'

SHEET **3** OF 9 SHEETS

