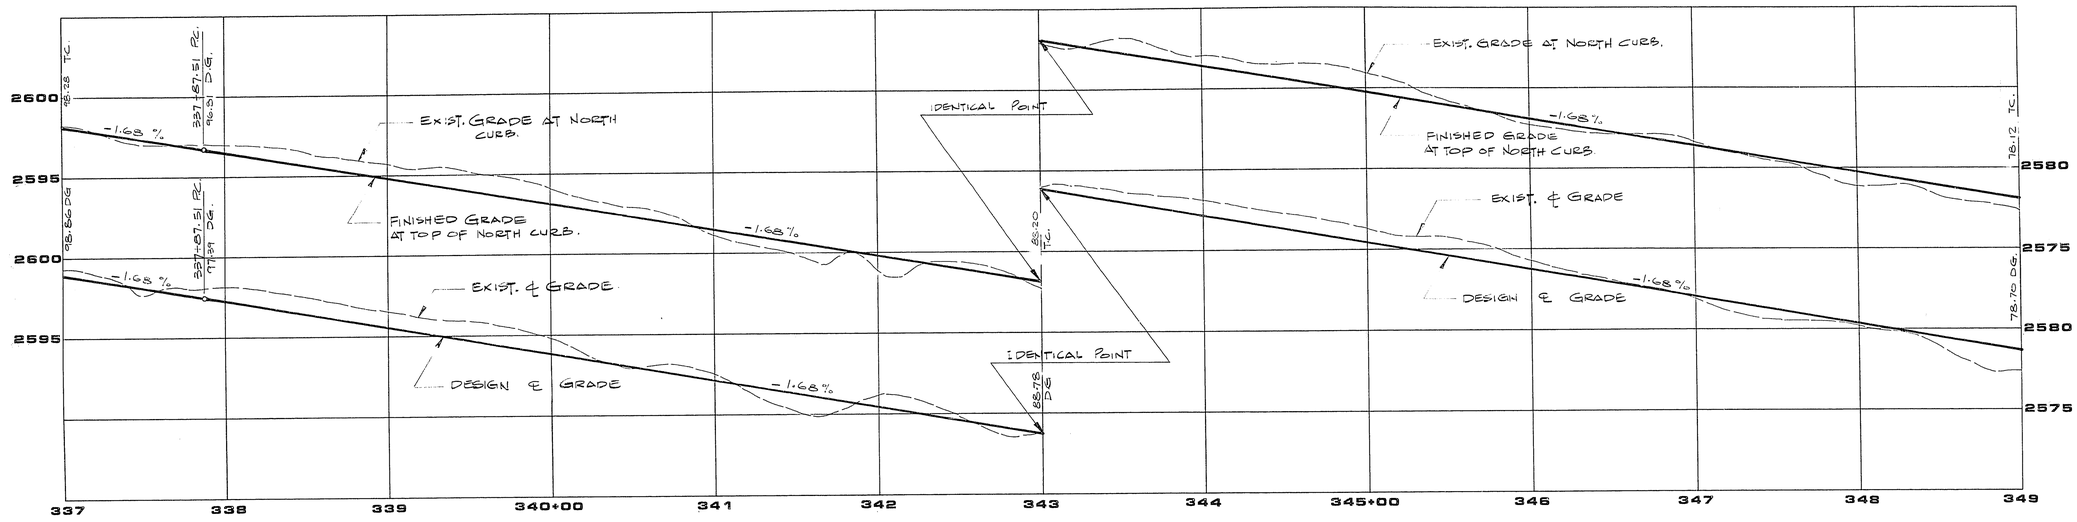

PROFILE
1"=40' HORIZONTAL
1"=4' VERTICAL

LAKE MEAD BLVD.

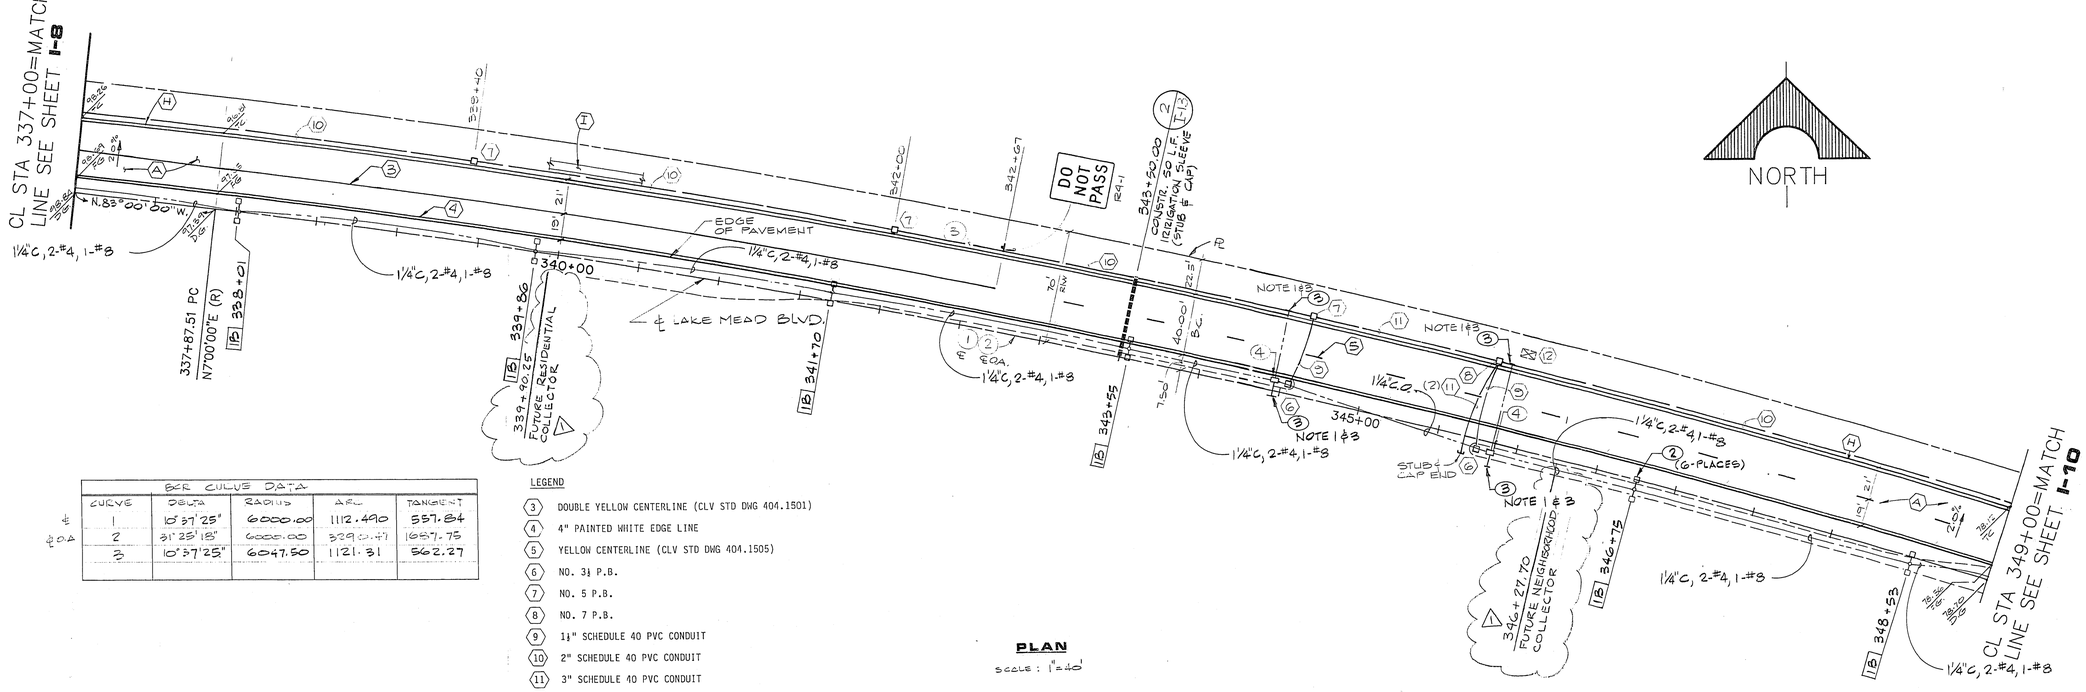

BCR CURVE DATA					
	CURVE	DELTA	RADIUS	ARC	TANGENT
℄	1	10°37'25"	6000.00	1112.490	557.84
℄ O.A.	2	31°25'18"	6000.00	3290.47	1687.75
	3	10°37'25"	6047.50	1121.31	562.27

LEGEND

3. DOUBLE YELLOW CENTERLINE (CLV STD DWG 404.1501)
4. 4" PAINTED WHITE EDGE LINE
5. YELLOW CENTERLINE (CLV STD DWG 404.1505)
6. NO. 3½ P.B.
7. NO. 5 P.B.
8. NO. 7 P.B.
9. 1½" SCHEDULE 40 PVC CONDUIT
10. 2" SCHEDULE 40 PVC CONDUIT
11. 3" SCHEDULE 40 PVC CONDUIT
12. FUTURE TRAFFIC SIGNAL CONTROLLER CABINET

PLAN
SCALE: 1"=40'

JOB NO. 701.013

8/84 DIETERICH-POST 6532B

REV	DATE	DESCRIPTION
1	9/10/85	REVISED INTERSECTING STREETS

RECOMMENDED
R.E. NO. DATE

G.C. WALLACE, INC.
Engineering/Architecture
1555 SOUTH RAINBOW BLVD. LAS VEGAS, NEVADA 89102

DEL WEBB COMMUNITIES, INC.
SUN CITY SUMMERLIN
LAKE MEAD BLVD.
PLAN AND PROFILE
STA. 337+00 TO STA. 349+00

SHEET 11
I-9
OF 23 SHEETS

107Y-4003

9-9-116