

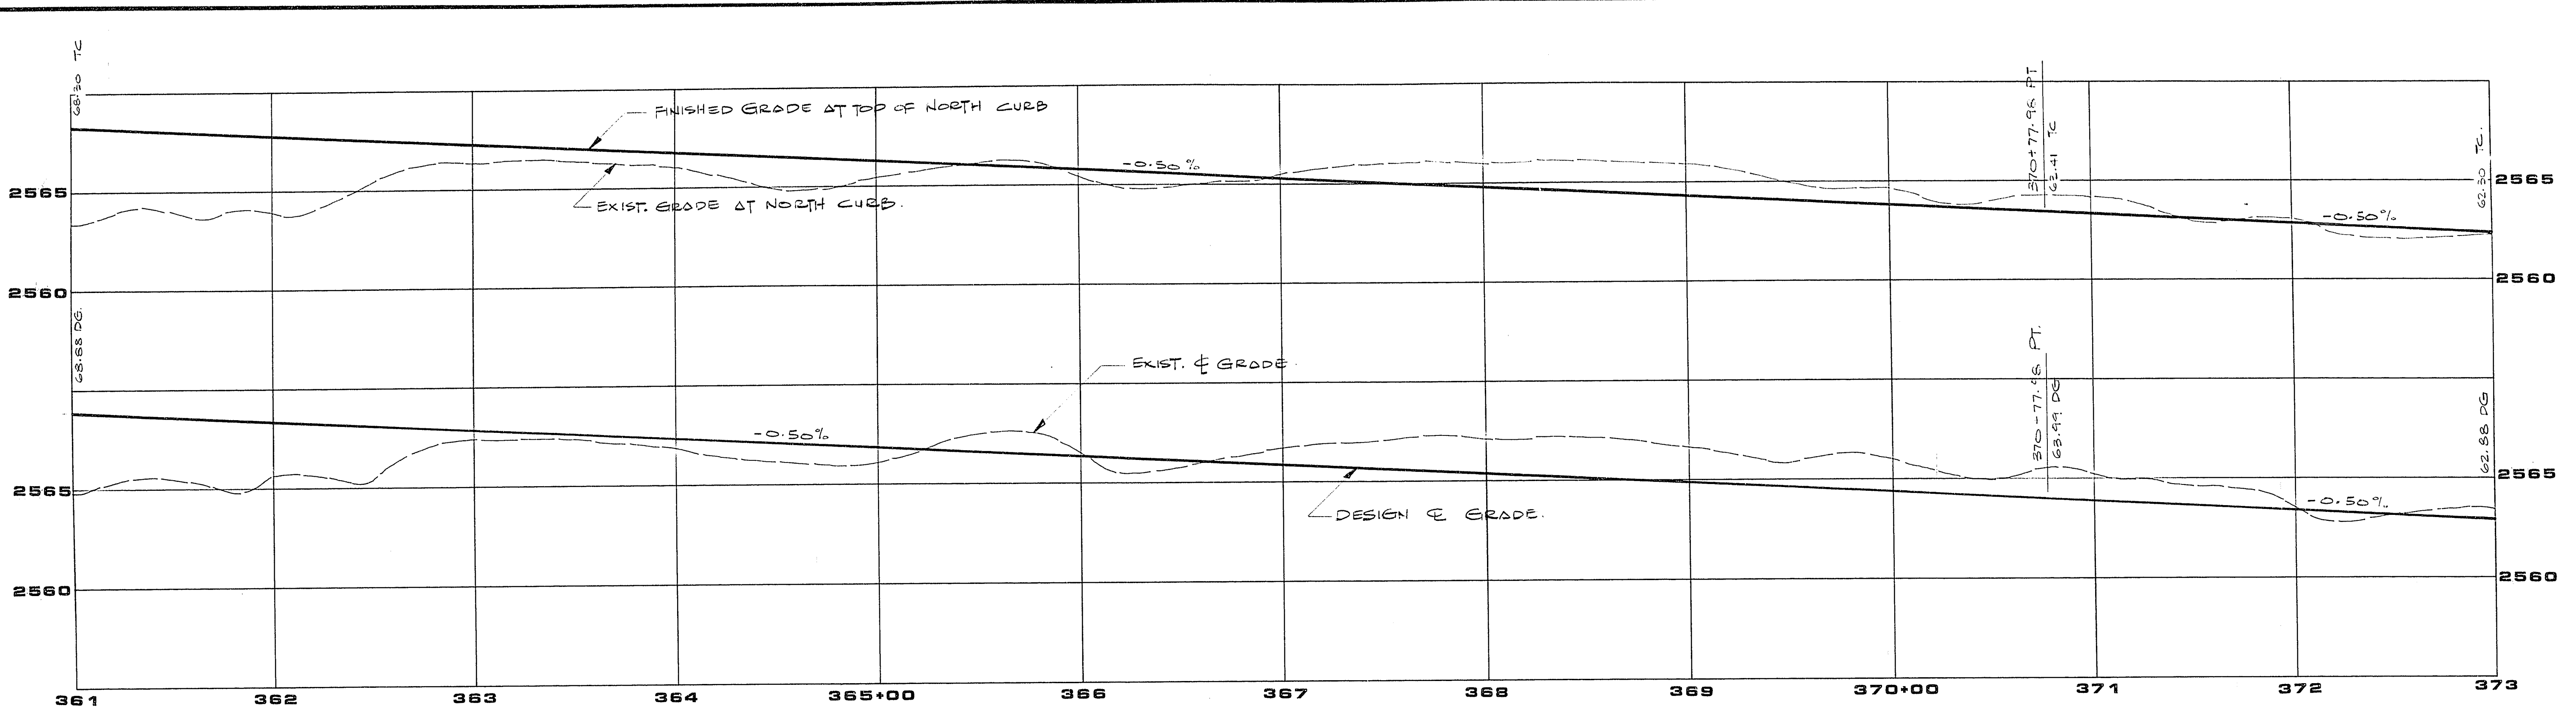


CL STA 361+00=MATCH  
LINE SEE SHEET I-10

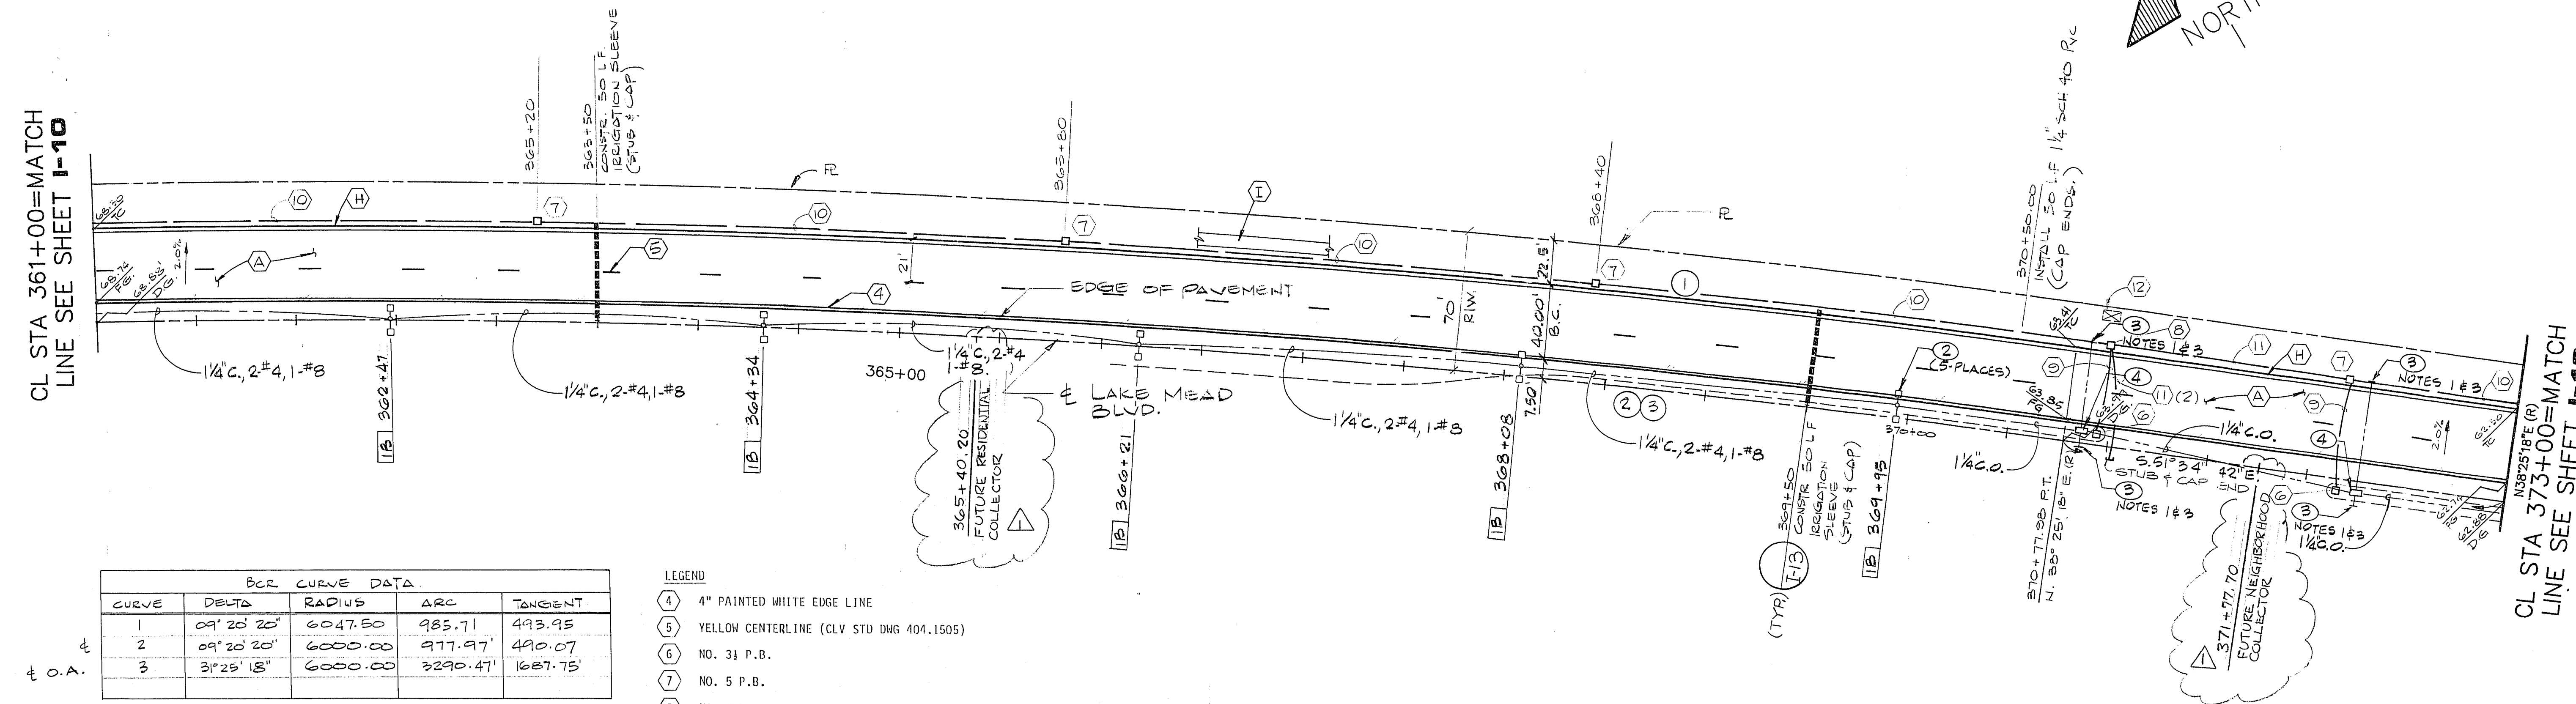

PROFILE  
1"=40' HORIZONTAL  
1"=4' VERTICAL

LAKE MEAD BLVD.

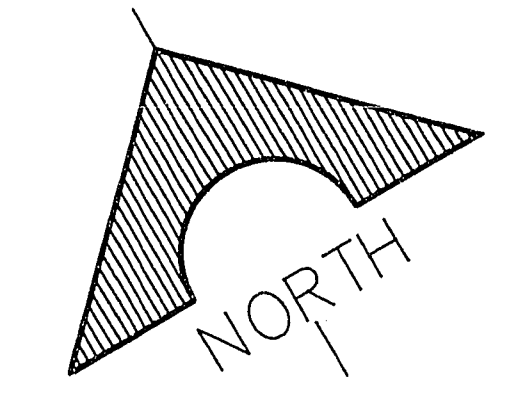

BCR CURVE DATA				
CURVE	DELTA	RADIUS	ARC	TANGENT
1	09° 20' 20"	6047.50	985.71	493.95
2	09° 20' 20"	6000.00	977.97	490.07

- LEGEND
- ④ 4" PAINTED WHITE EDGE LINE
  - ⑤ YELLOW CENTERLINE (CLV STD DWG 404.1505)
  - ⑥ NO. 3 P.B.
  - ⑦ NO. 5 P.B.
  - ⑧ NO. 7 P.B.
  - ⑨ 1 1/2" SCHEDULE 40 PVC CONDUIT
  - ⑩ 2" SCHEDULE 40 PVC CONDUIT
  - ⑪ 3" SCHEDULE 40 PVC CONDUIT
  - ⑫ FUTURE TRAFFIC SIGNAL CONTROLLER CABINET

PLAN  
SCALE: 1"=40'

CL STA 373+00=MATCH  
LINE SEE SHEET I-12

RECOMMENDED	DATE	DESCRIPTION
<i>[Signature]</i>	12/16/10	REVISED INTERSECTIONS, STREETS.
REV	DATE	
1	12/16/10	
G.C. WALLACE, INC. Engineering/Architecture 1555 SOUTH RAINBOW BLVD. LAS VEGAS, NEVADA 89102		
DEL WEBB COMMUNITIES, INC. SUN CITY SUMMERLIN LAKE MEAD BLVD. PLAN AND PROFILE STA. 361+00 TO STA. 373+00		
SHEET 13 1-11 OF 23 SHEETS		