

NOTES:

1. CONDUIT FILL SHOWN HERE DOES NOT INCLUDE GROUND CONDUCTOR, SUCH CONDUCTOR IS REQUIRED FOR 120/2-10V. CIRCUITS IN NON METALLIC DUCT.
2. 3/4" T.M. WIRING SHOWN PROVIDES 3 SPARE PAIR.
3. NEVADA POWER CO. SERVICE CONDUIT AND FACILITIES TO BE INSTALLED IN ACCORDANCE WITH NEVADA POWER CO. REQUIREMENTS AS SHOWN ON N.P.C. DRAWING 432-3460 SHEETS 1 & 2 OF 2.
4. FOR INSTALLATION OF STREET LIGHTS STANDARDS REFERENCE SMT. C-B.


REV	DATE	BY	DESCRIPTION
2-95	Δ.B.	REVISION FOR 5HP SUMP PUMP (JAT)	
8-95	Δ.B.	REVISIONS OF OFFSITE CONDUIT PER N.P.C.	
11-04	Δ.B.	ADD MOV. POWER, STATUS & CONTROLS (CLV)	
11-04	Δ.B.	CHANGE STREET LIGHT WIRING & CONDUIT (CLV)	

SCALE: 1"=30'	DESIGNED: B. LATCH	SUBMITTED: <i>Shirley C. Alcorn</i> 4920 6-20-84
	DRAWN: D. GILBRETH	R.P.E. NO. DATE
	CHECKED: S. RINSWORTH	RECOMMENDED: <i>Richard J. Helms</i> 2315 6/27/84
		R.P.E. NO. DATE

JAMES M. MONTGOMERY CONSULTING ENGINEERS, INC.
 100 EAST SARAH AVENUE, LAS VEGAS, NEVADA 89104

APPROVED: _____	DATE _____
APPROVED: <i>Charm J. Walker</i> 4412 6-28-84	DATE _____
R.P.E. NO.	DATE

LAS VEGAS VALLEY WATER DISTRICT		SHEET
2300 ZONE NORTH RESERVOIR		E1
ELECTRICAL PLAN		OF 39 SHEETS

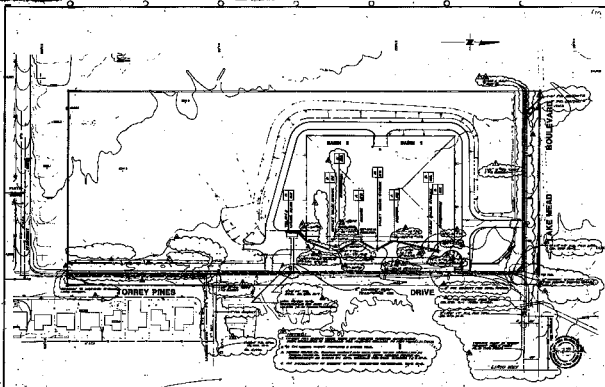


