




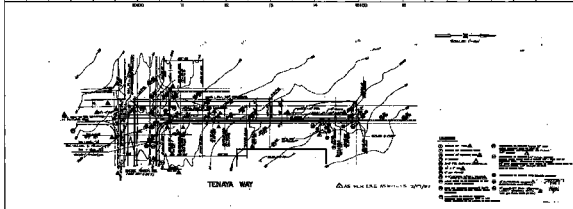


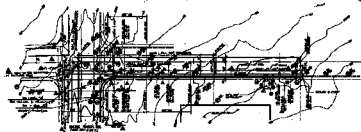

TENARA WAY


