NOTE:

1. MADE ELECTRODE SHALL BE IN ACCORDANCE W/ARTICLE 250-83 OF THE NATIONAL ELECTRICAL CODE
2. TOP OF SLOPE IS DOWN AND AWAY FROM THE STANDARD FOR DRAINAGE

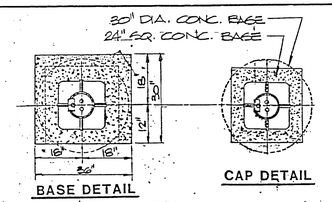

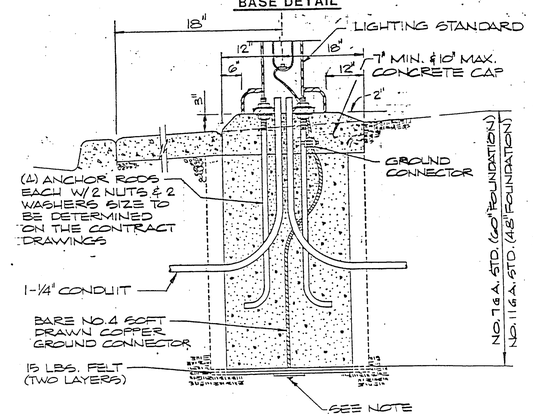

TYPICAL STREET LIGHT DETAIL

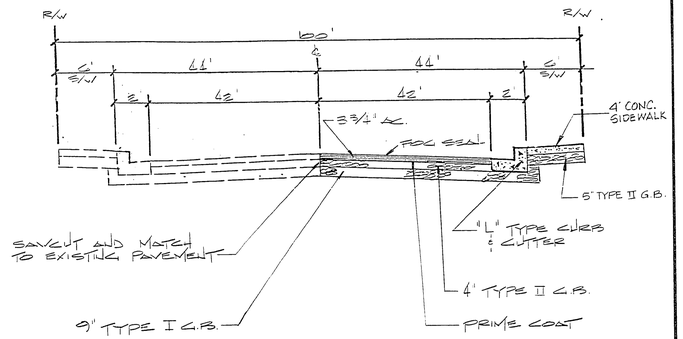

TYPICAL 100' HALF-STREET SECTION

SMOKE RANCH ROAD: STA. - 14+64 TO 20+00

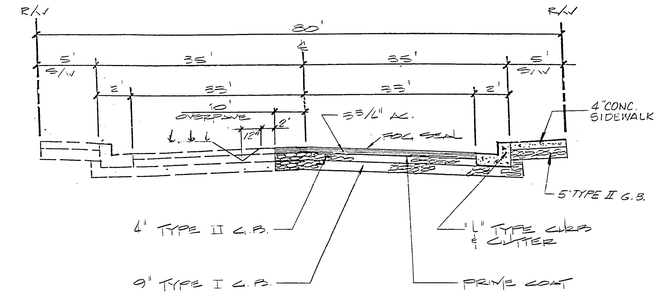

TYPICAL 80' HALF-STREET SECTION

TENAYA WAY

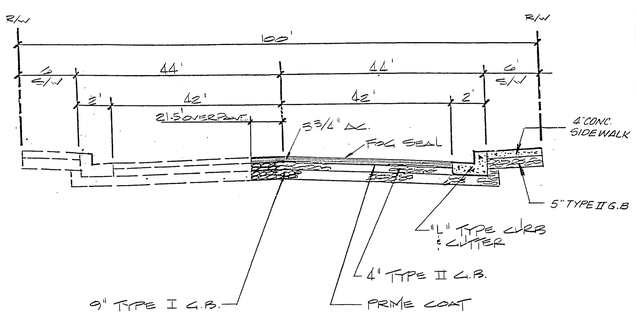

TYPICAL 100' HALF-STREET SECTION

SMOKE RANCH ROAD: STA. - 9+90 TO 12+36

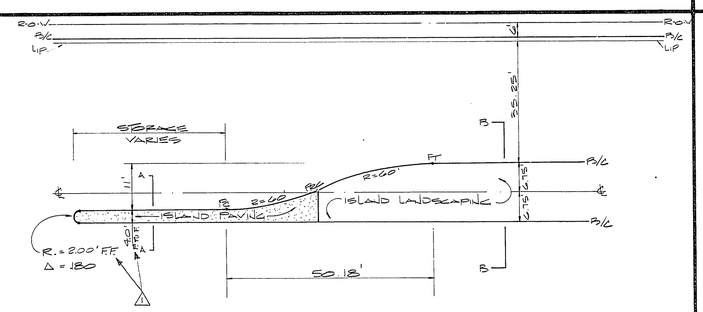

PLAN VIEW

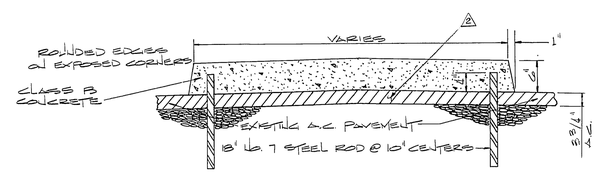

SECTION A - A

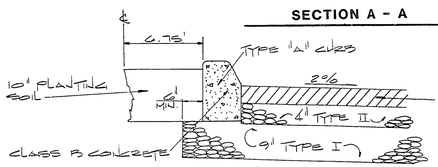

SECTION B - B

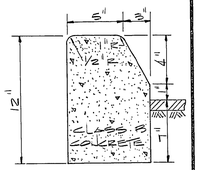

"A" CURB SECTION

TYPICAL ISLAND DETAILS

WHEN PERMITTED OR REQUIRED BY ORDINANCE OR AGREEMENT, HALF STREET CONSTRUCTION SHALL BE IN ACCORDANCE WITH THE FOLLOWING DIAGRAM.

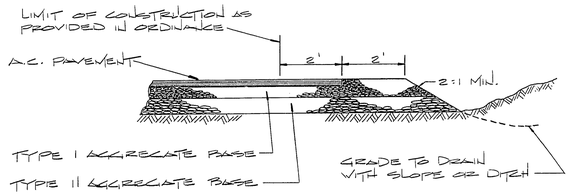

WHEN CONSTRUCTION ADJOINS PREVIOUSLY CONSTRUCTED HALF-STREET IMPROVEMENTS WITH ACCEPTABLE BASE, THE CONSTRUCTION JOINTS SHALL BE AS SHOWN IN THE FOLLOWING DIAGRAM.

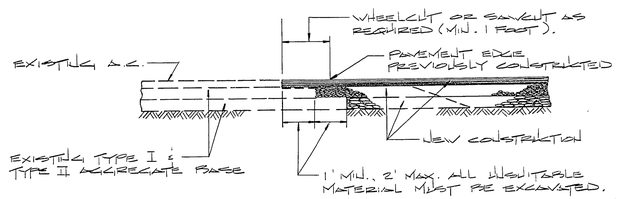

TYPICAL HALF-STREET CONSTRUCTION DETAILS

REV	DATE	BY	REVISION
1	2/13/86	DJK	REVISE ISLAND DIMENSION
2	2/13/86	DJK	REVISE PAVING UNDER TACK-ON ISLAND

ENGINEERS & SURVEYORS INC.
7022 W. CHARLESTON BLVD.
LAS VEGAS, NEVADA 89117
PHONE: 702 / 363-6415

SUBMITTED BY: PAUL VALENTINE

TITLE: DETAIL SHEET

PROJECT: LAS VEGAS TECHNOLOGY CENTER

WO NO.	86/206
BY	B.G.
DATE	1/86
SCALE	NONE

SHEET 11 OF 12 SHEETS — REVISED

BID. NO. 86.0832.12 2-3-86 107-V1372