REV	DATE	BY	REVISION
1	2-11-86	PC	REMOVE 18" PVC & REPLACE W/16" TEE
2	2-11-86	PC	RELOCATE STREET LIGHTS
3	2-11-86	PC	REVISE NOTE
4	2-11-86	PC	ADD EXIST. 4" P.E. LINE

ENGINEERS & SURVEYORS
7022 W. CHARLESTON BLVD.
LAS VEGAS, NEVADA 89117
PHONE: 702 / 363-8415

SUBMITTED AXIL E. MAUPIN

LEGEND

1. SAWCUT EXISTING AC PAVING AT CENTERLINE REMOVE EXISTING AC PAVING NORTH OF CENTERLINE MATCH NEW AC PAVING TO EXISTING FINISH GRADE AT CENTERLINE (STATION 24+00 TO 24+50)
7. INSTALL 16" BUTTERFLY VALVE
11. REMOVE EXISTING AC PAVING
13. PROVIDE SERVICE CONDUITS, 1¼" ELEC. CONDUIT AND 1" PVC (SCH. 40) LANDSCAPE WATER
14. INSTALL 1" METER & SERVICE FOR FUTURE LANDSCAPE
15. INSTALL 16" TEE 1
22. ANODE BOXES TO BE ADJUSTED TO NEW FINISH GRADE ELEVATION
25. 3¼" PULL BOX
A. EXISTING 39" WATER MAIN
B. EXISTING 10" SEWER MAIN
26. CONTRACTOR TO IMPROVE TRENCH 36" DEEP ALONG PROPERTY LINE TO EDGE OF IMPROVEMENT. CONTRACTOR TO PLACE 4-4" CONDUIT. 2

CURVE DATA TABLE

NO.	Δ	R	L	T
2	180°00'00"	1.25	3.93	~
3	24°43'26"	60.00	25.89	13.15

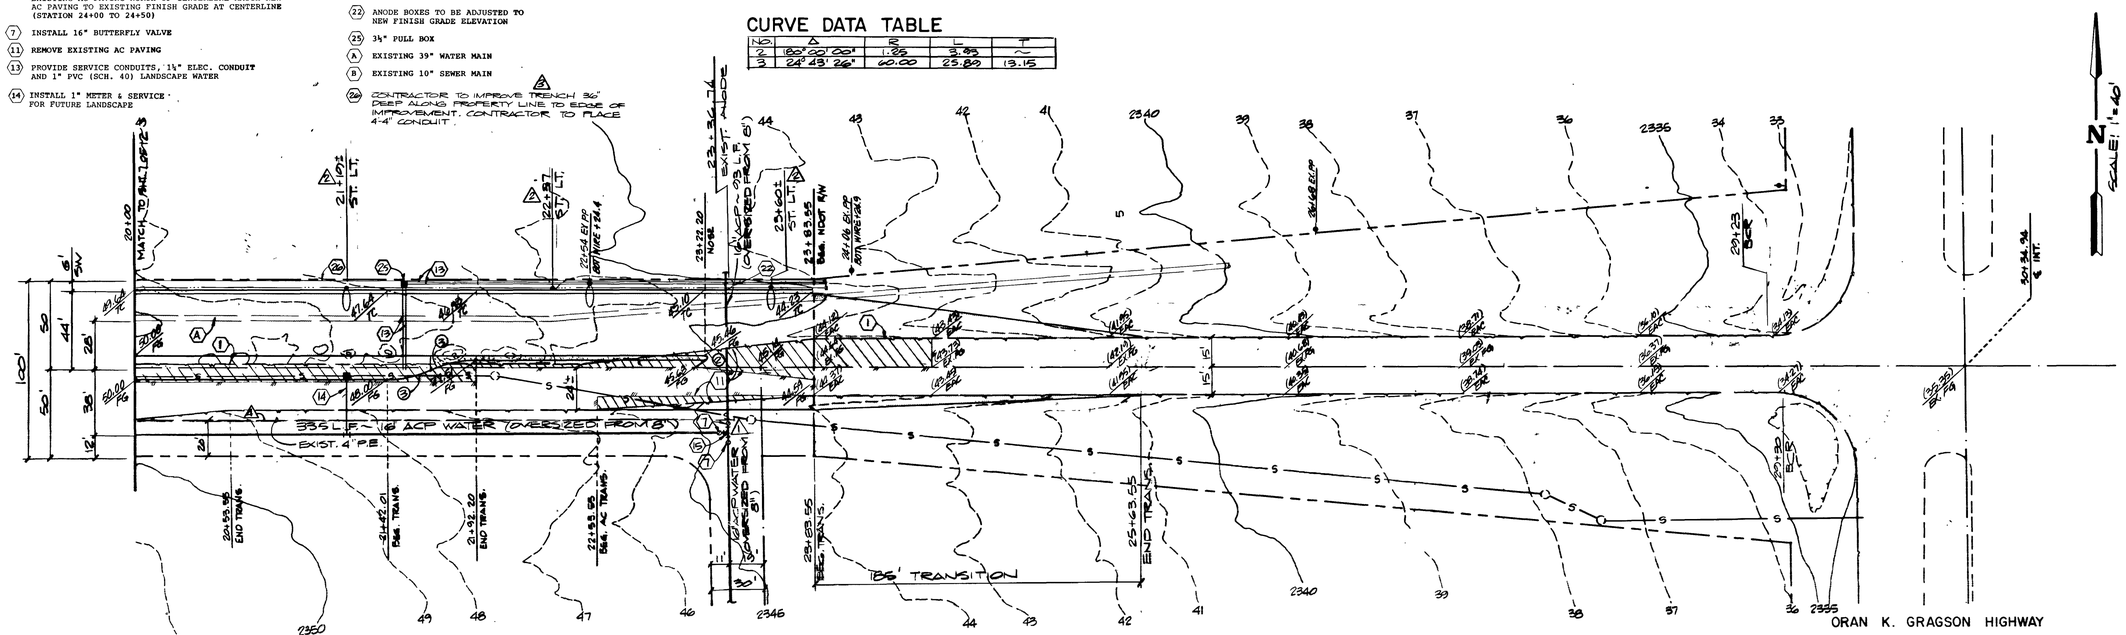

SMOKE RANCH ROAD

VOID
NOT AWARDED

TITLE: IMPROVEMENT PLAN
SMOKE RANCH RD. (ALTERNATE) STA. 20+00 TO 30+34.94

PROJECT: LAS VEGAS TECHNOLOGY CENTER

WO NO.	851206
BY	P.V. / P.C
DATE	1/86
SCALE	HORIZ. 1"=40' VERT. 1"=4'

SHEET 8 REVISED OF 12 SHEETS

153

BID NO. 86.0832.12 213-01 107- V1372

LEGEND

CURVE DATA TABLE

SMOKE RANCH ROAD

VOID
NOT AWARDED

IMPROVEMENT PLAN

LAS VEGAS TECHNOLOGY CENTER

8