

DESIGNED
BY
CHECKED
DATE
SCALE
NO. 100
BY
DATE
NO. 100


IMPROVEMENT PLAN

ENGINEERS & SURVEYORS
INCORPORATED
10555 W CHARLESTON BLVD

REV	DATE	BY	REVISION

DEGRADED TO
100V

SMOKE BRANCH ROAD

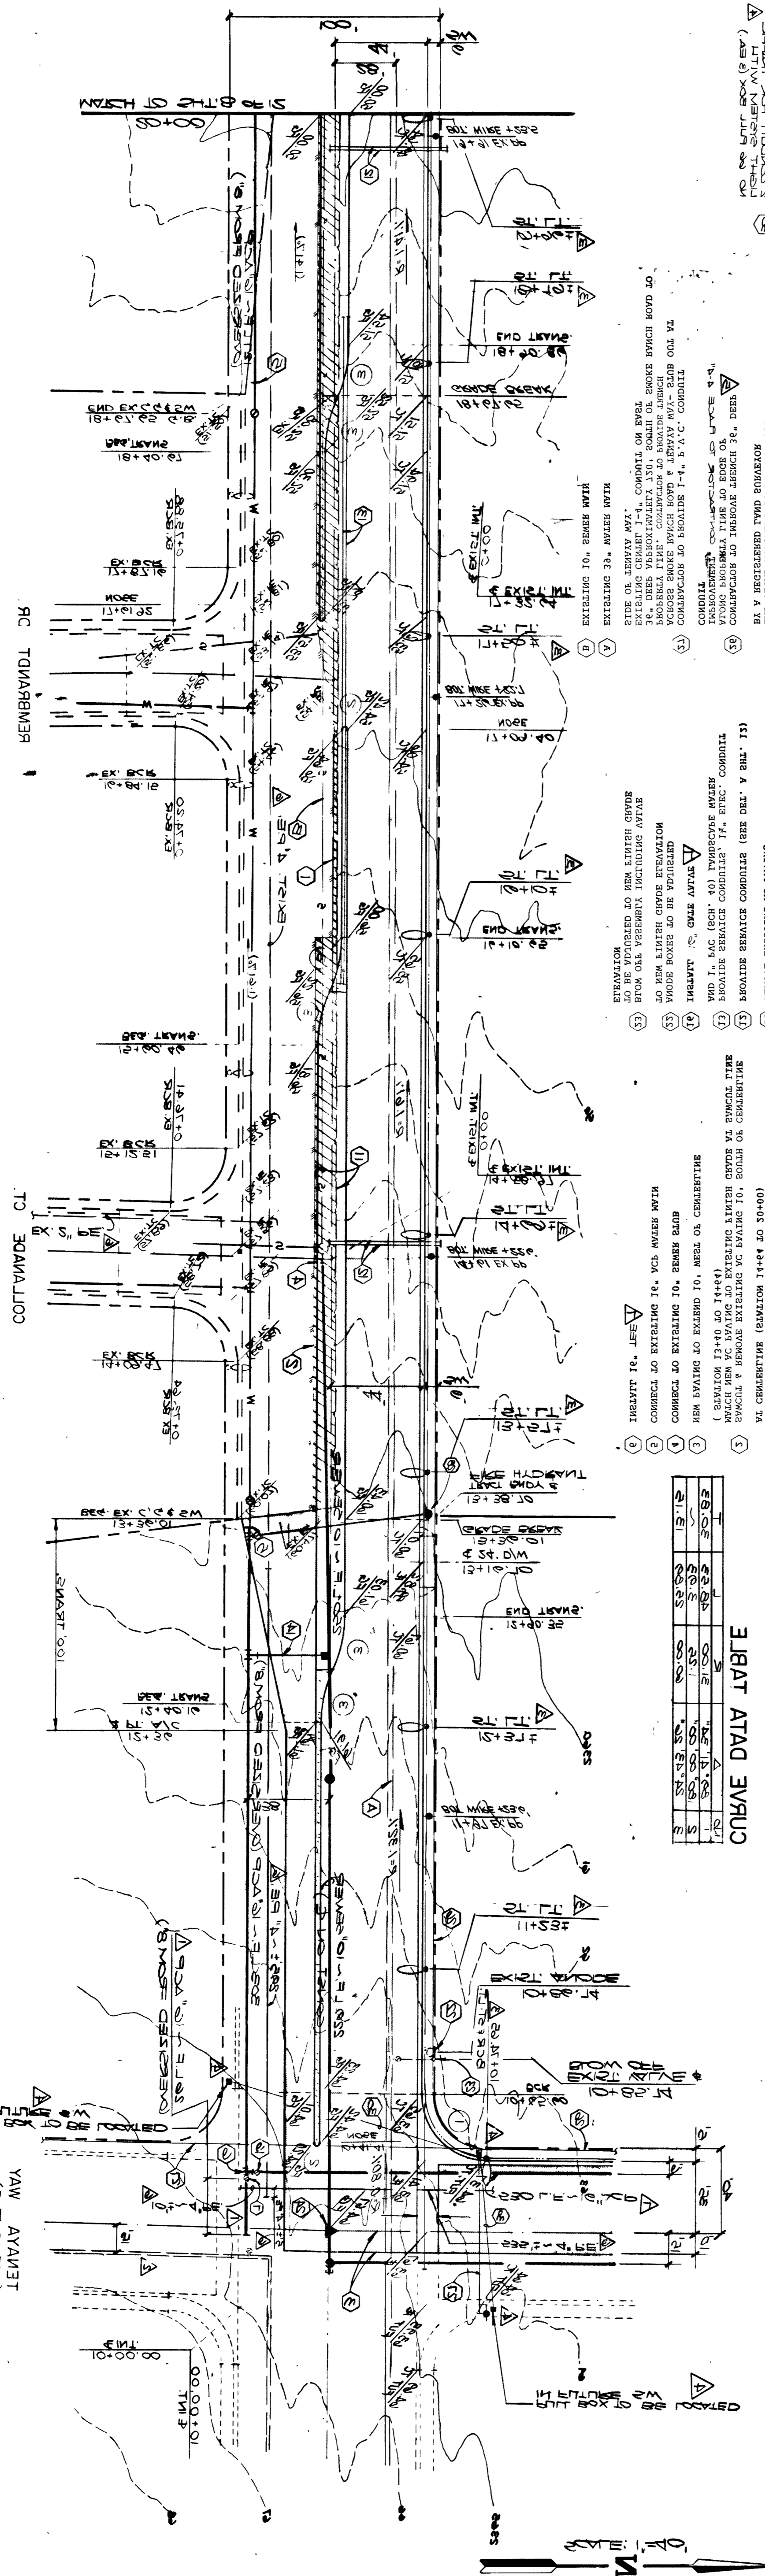


