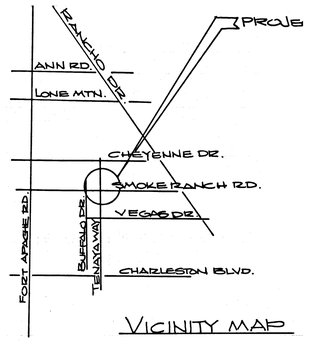

VICINITY MAP

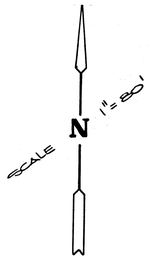

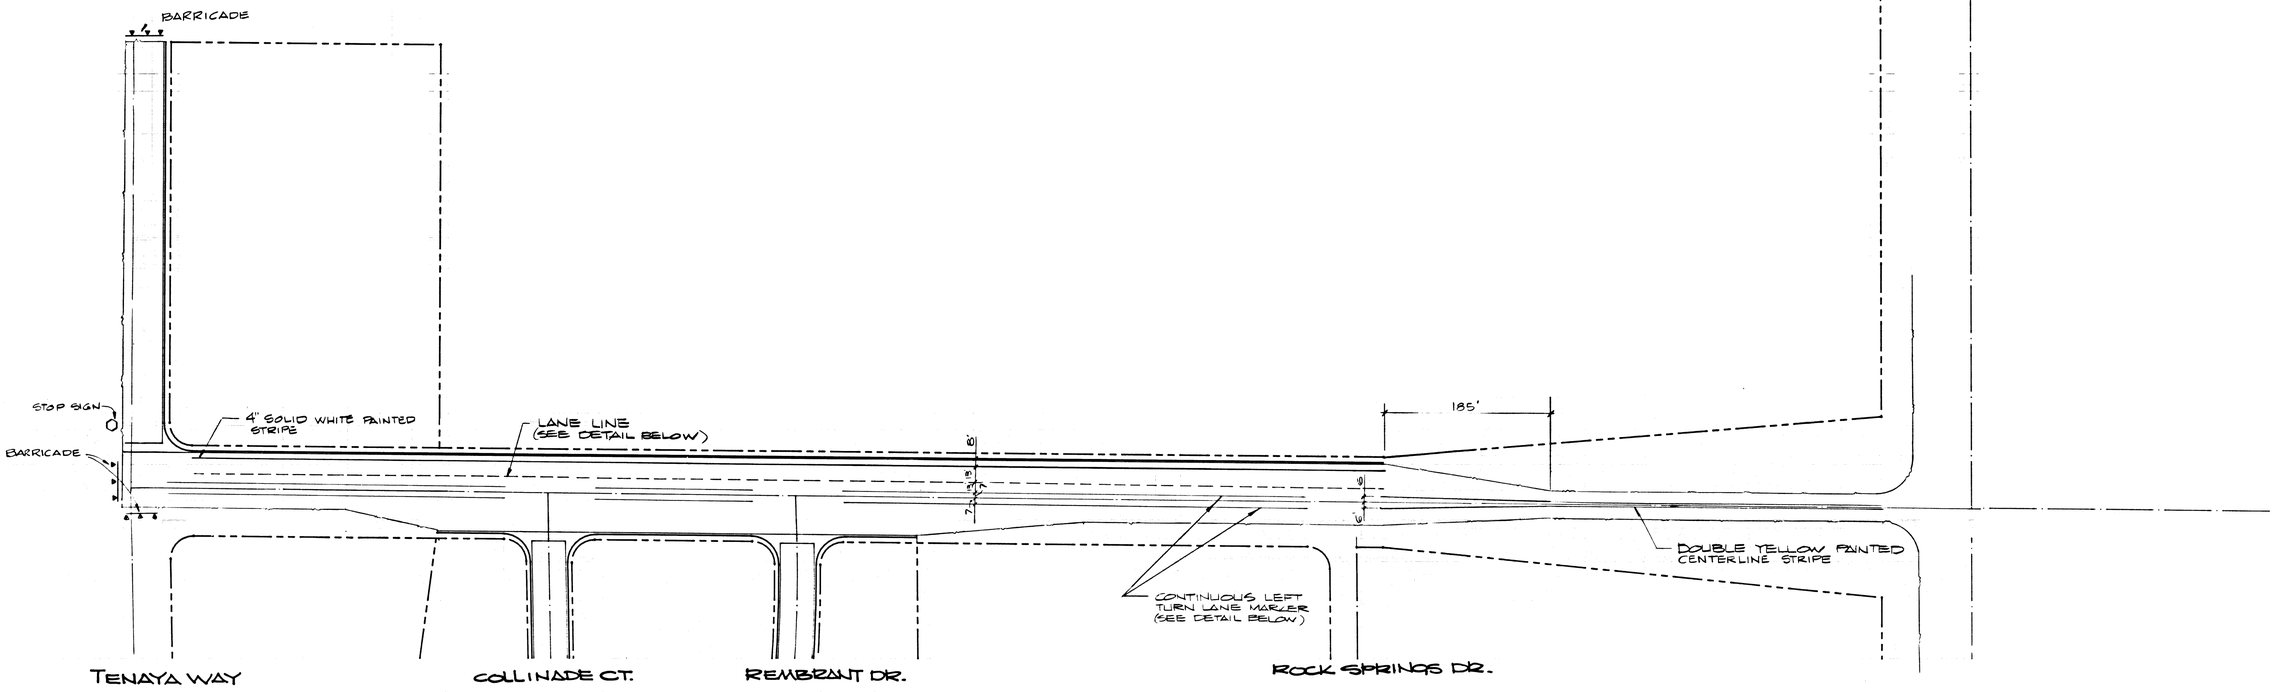

SMOKE RANCH ROAD

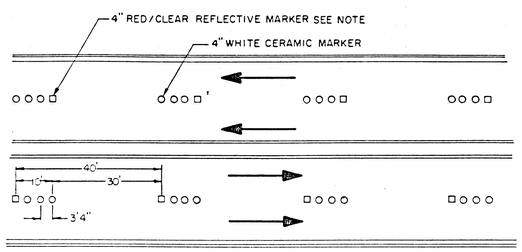

LANE-LINE

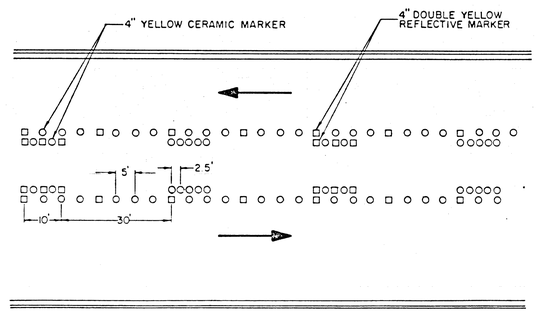

CONTINUOUS LEFT TURN LANE

AS BUILT

REV	DATE	BY	REVISION

ENGINEERS & SURVEYORS INCORPORATED
7022 W. CHARLESTON BLVD.
LAS VEGAS, NEVADA 89117
PHONE: 702 / 363-6415

SUBMITTED BY: BRAUNTINE

TRAFFIC DELINEATION PLAN

LAS VEGAS TECHNOLOGY CENTER

891206
FE
1/30-6
1" = 30'

9
12

BID. NO. 86. 0832.12 2-3-70 107-V1372A