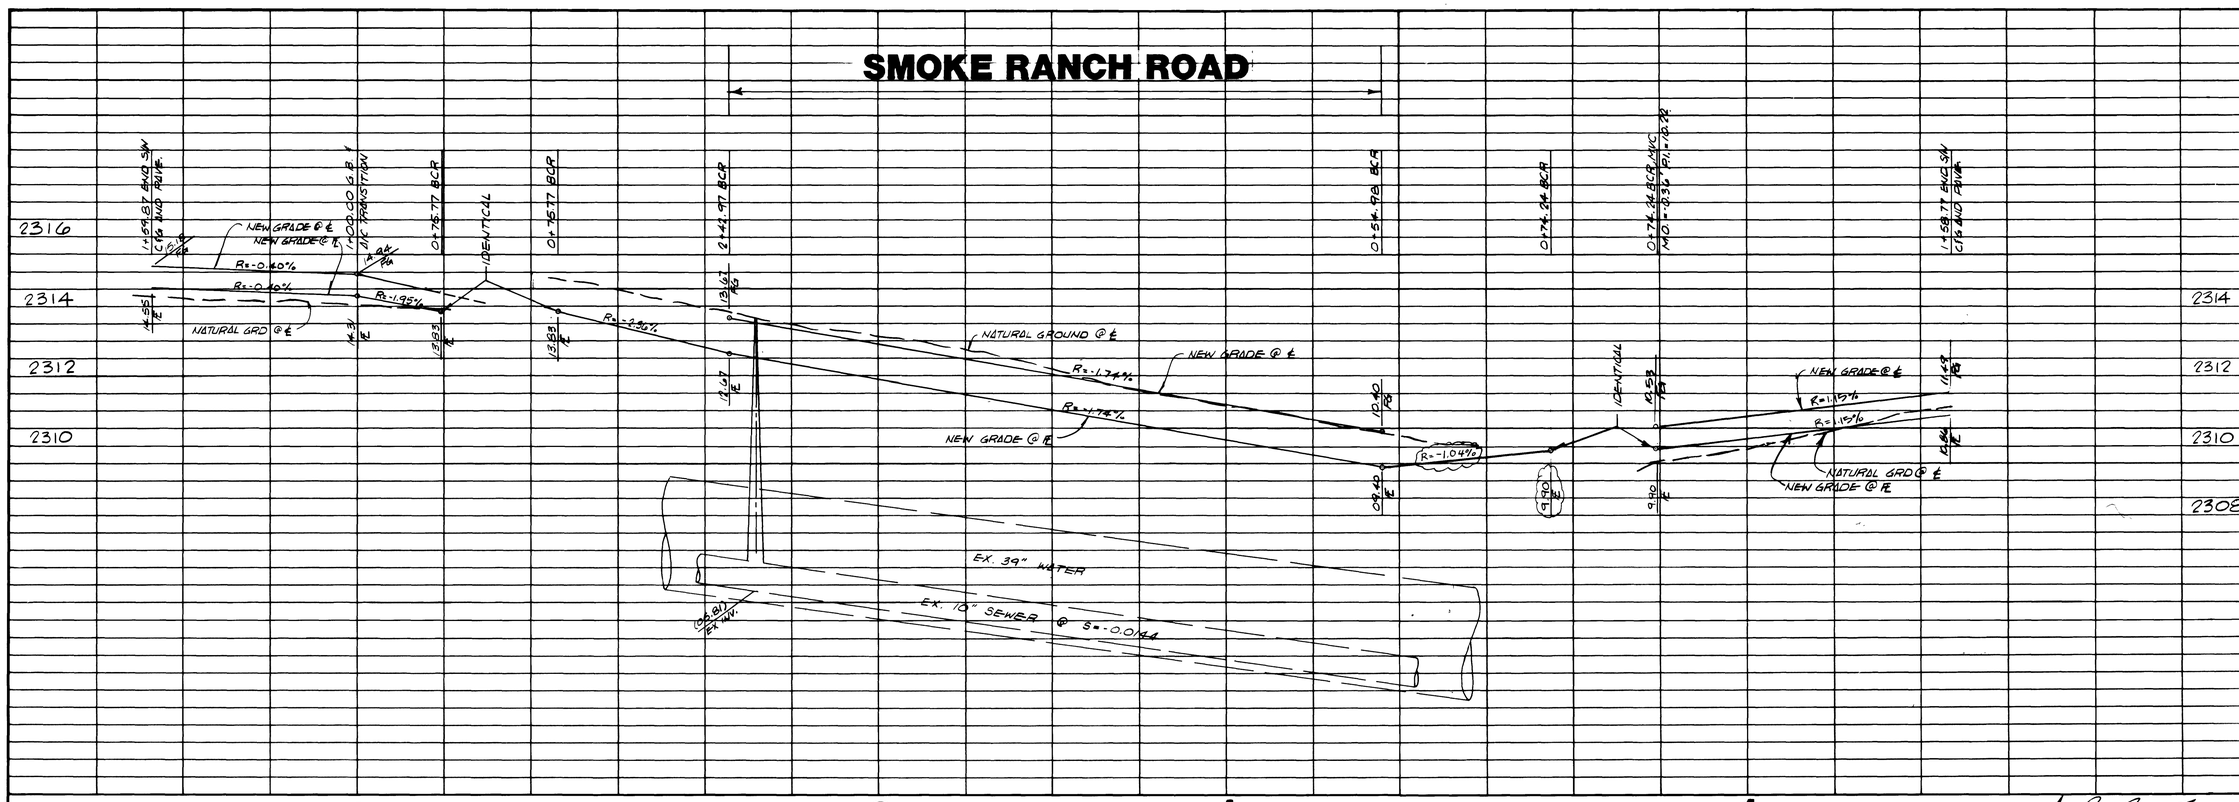

1 2 1 1

NEVADA POWER CO. 3-26-96 DATE

BCR CURVE DATA

No.	Δ	R	L	T
1	90°46'51"	31.00'	49.12'	31.43'
2	89°13'09"	31.00'	48.27'	30.58'

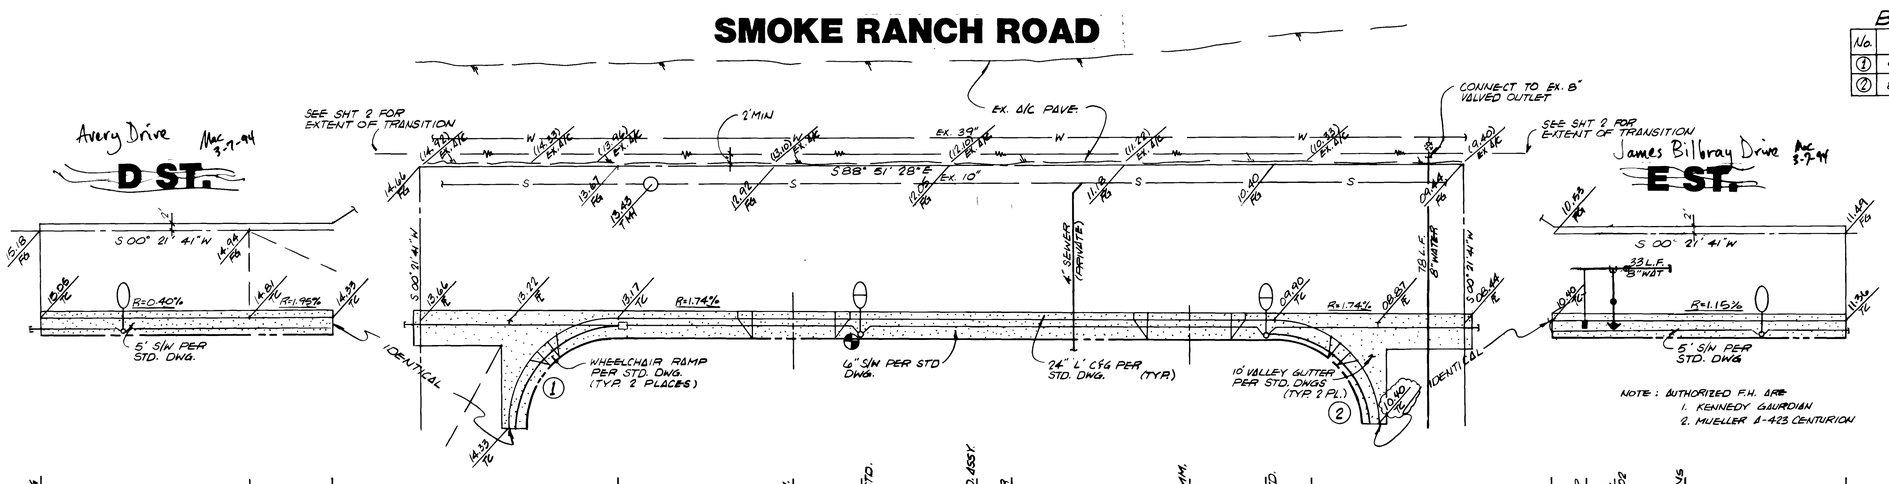

1+59.87 END S/W, C/G AND PAVEMENT

1+00.00 GRADE BR T/A/C TRANSITION

0+75.77 BCR

2+42.97 BCR

1+93.00 ℄ 24" COMM. DWY PER STD DWG.

1+75.00 ℄ 250 W HPS ST. LGT PER STD. DWGS.

1+40.00 ℄ FIRE HYD ASSY PER STD. DWG.

1+30.00 ℄ 3/4" WATER SERVICE

0+79.00 ℄ 24" COMM. DWY PER STD. DWG.

0+56.00 ℄ 250 W HPS ST. LGT. PER STD. DWGS.

0+54.98 BCR

0+74.24 BCR

0+78.00 ℄ 3/4" WATER SERVICE

0+90.00 ℄ FIRE HYD. ASSY. PER STD. DWG. 402

1+12.00 CROWN TRANS

1+58.77 END S/W C/G AND PAVEMENT

1" = 20'

Avoid cutting underground utility lines. It's costly.

Call before you Dig. 1-800-227-2600 UNDERGROUND SERVICE (USA)

REVISION	DATE	BY
No.		

STATE OF NEVADA — MARK A. JOHNSON — CIVIL — 10262

2/26/96

SOUTHWEST ENGINEERING
CONSULTING ENGINEERS • PLANNERS
2801 W. CHARLESTON BLVD.
LAS VEGAS, NEVADA 89102
(702) 877-9700

TITLE: OFFSITE STREET PLAN & PROFILE

PROJECT: LITTLE PLAYMATE PRE-SCHOOL

W.O. No.	
BY	MJ
DATE	2/96
SCALE	1" = 20'
SHEET	3
OF	3 SHEETS

2-3-4

107-V1399

 

 

2-3-9

107-11399