
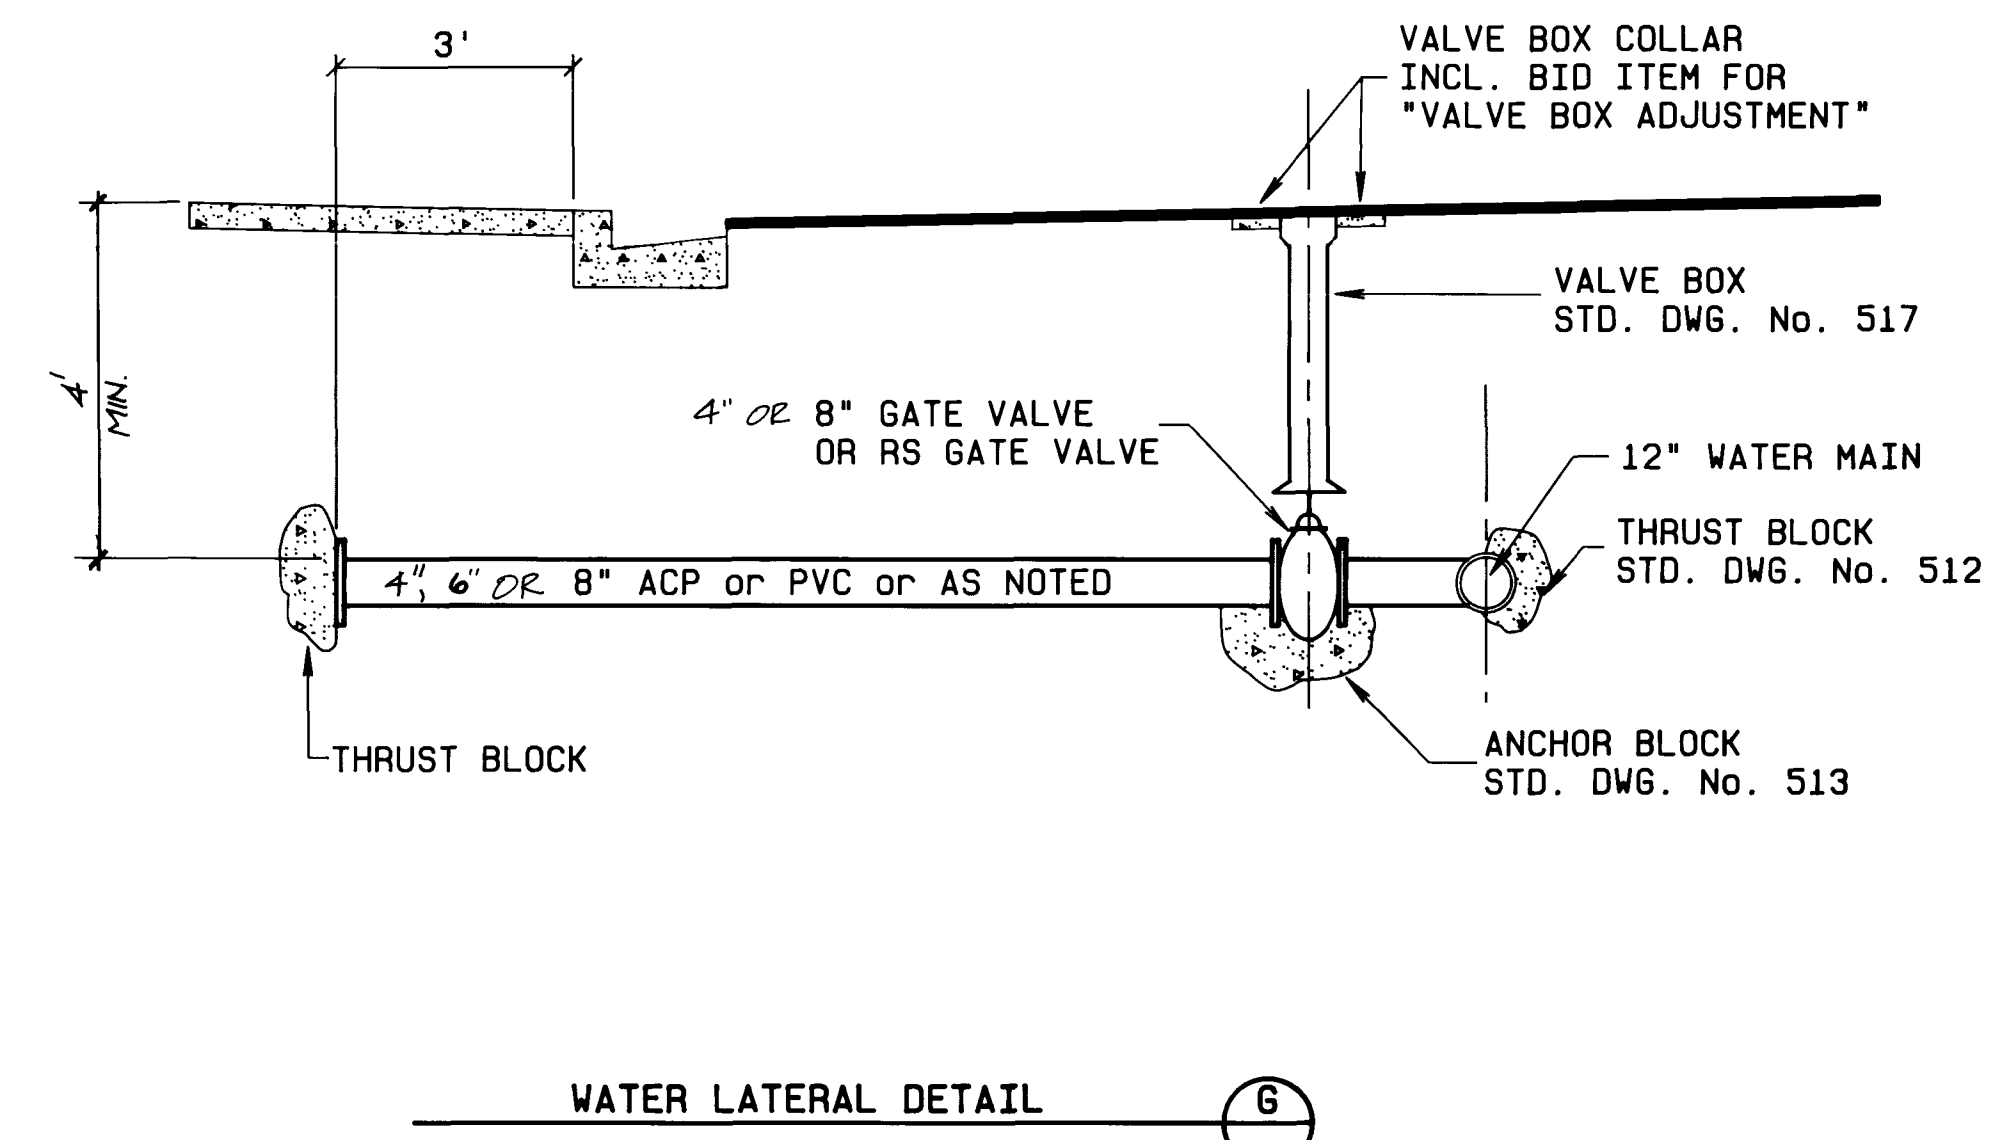
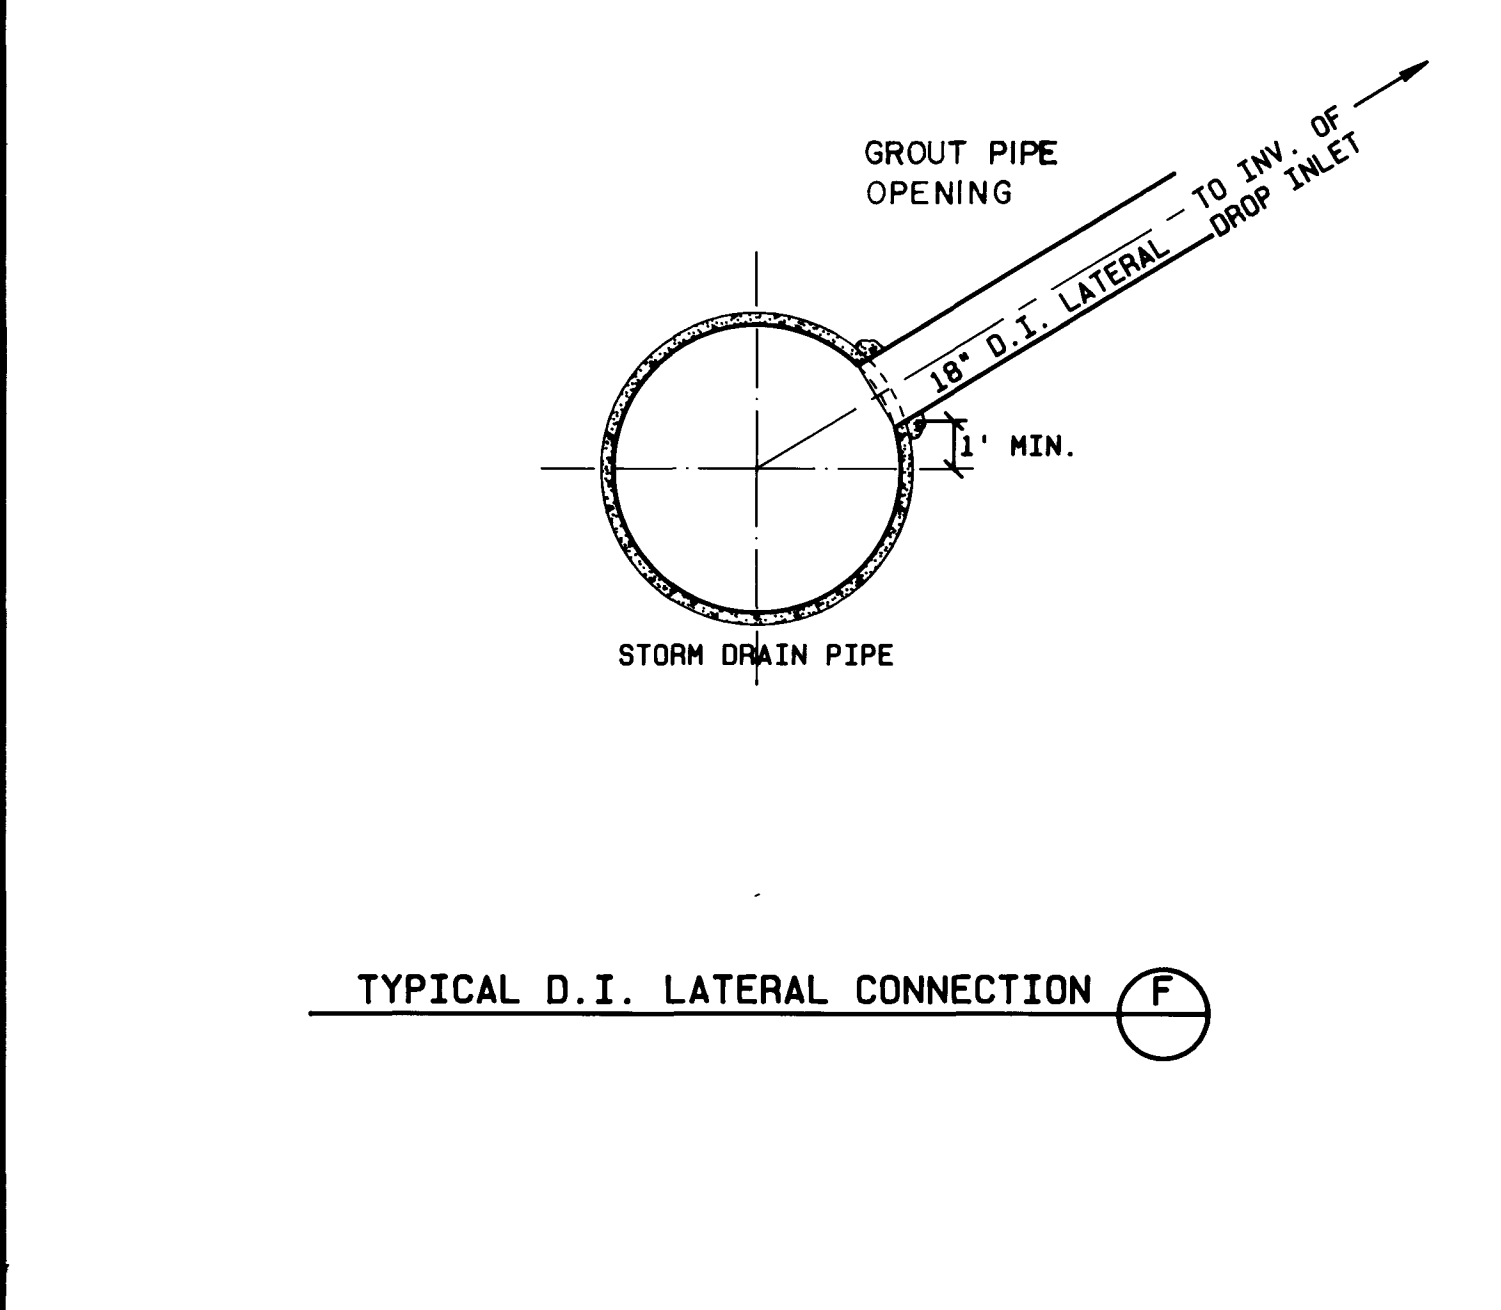
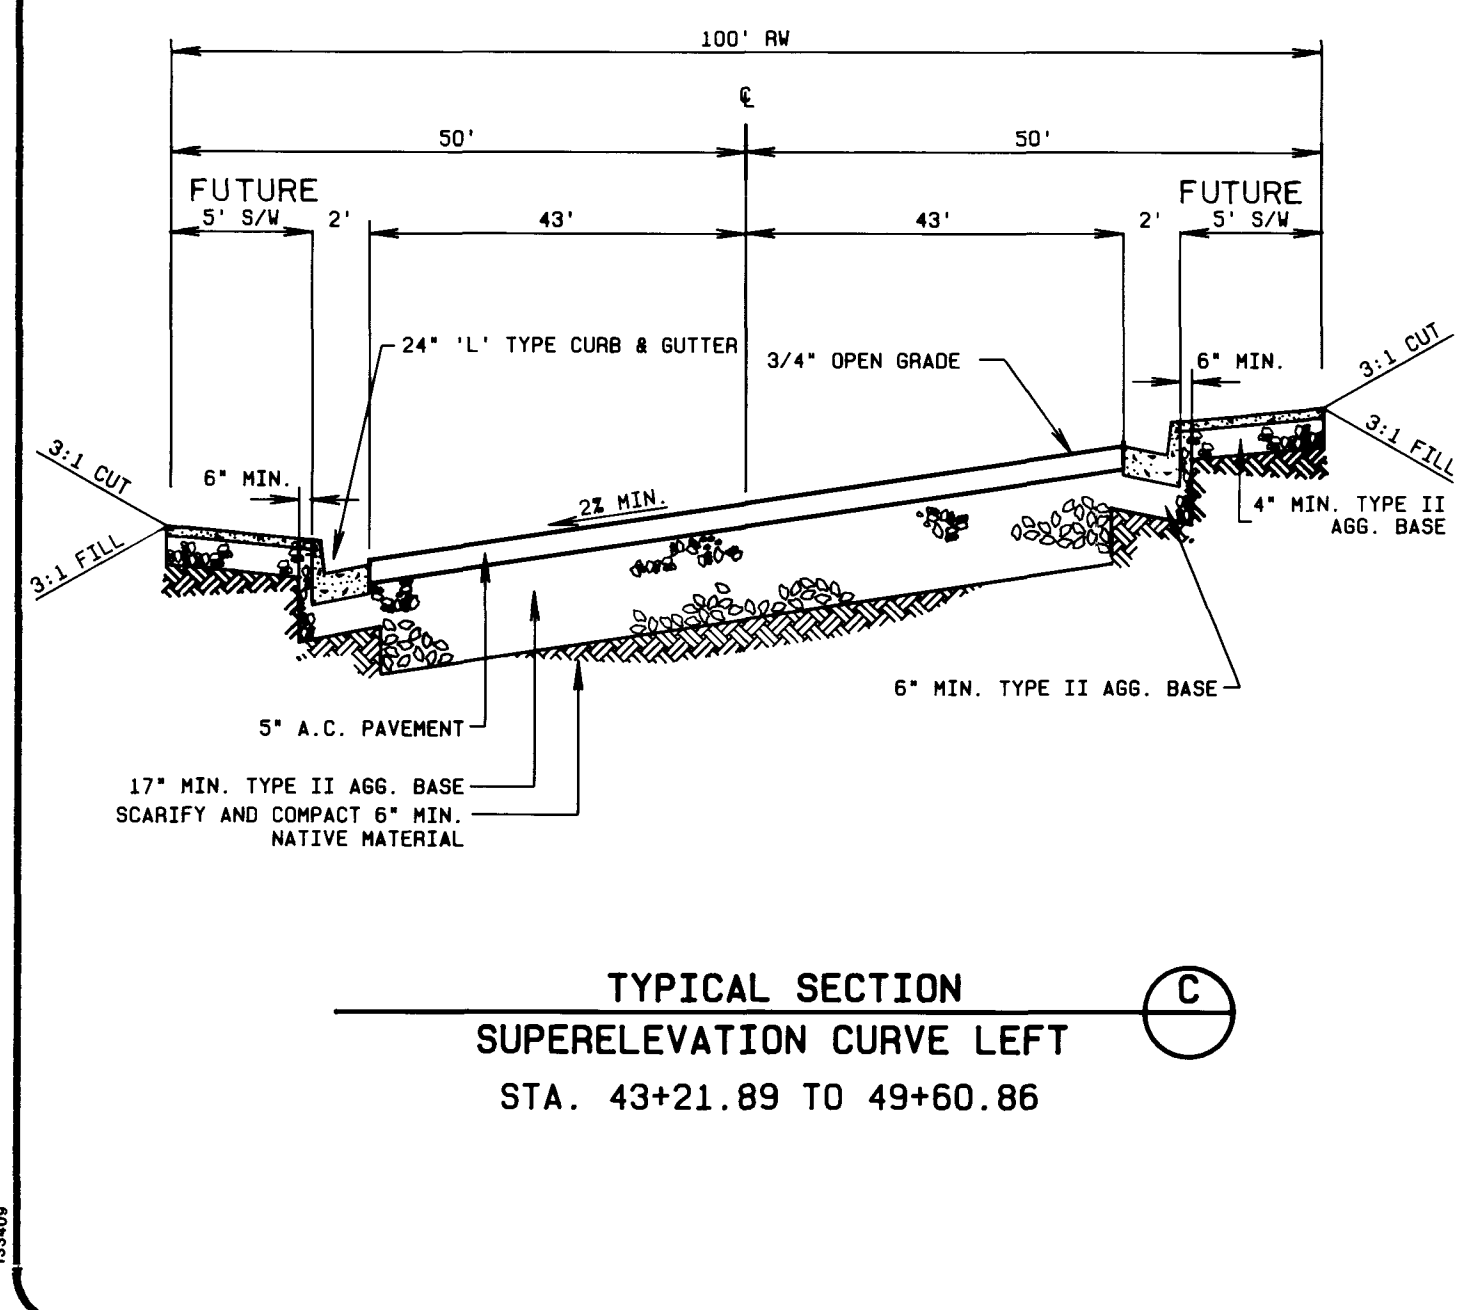
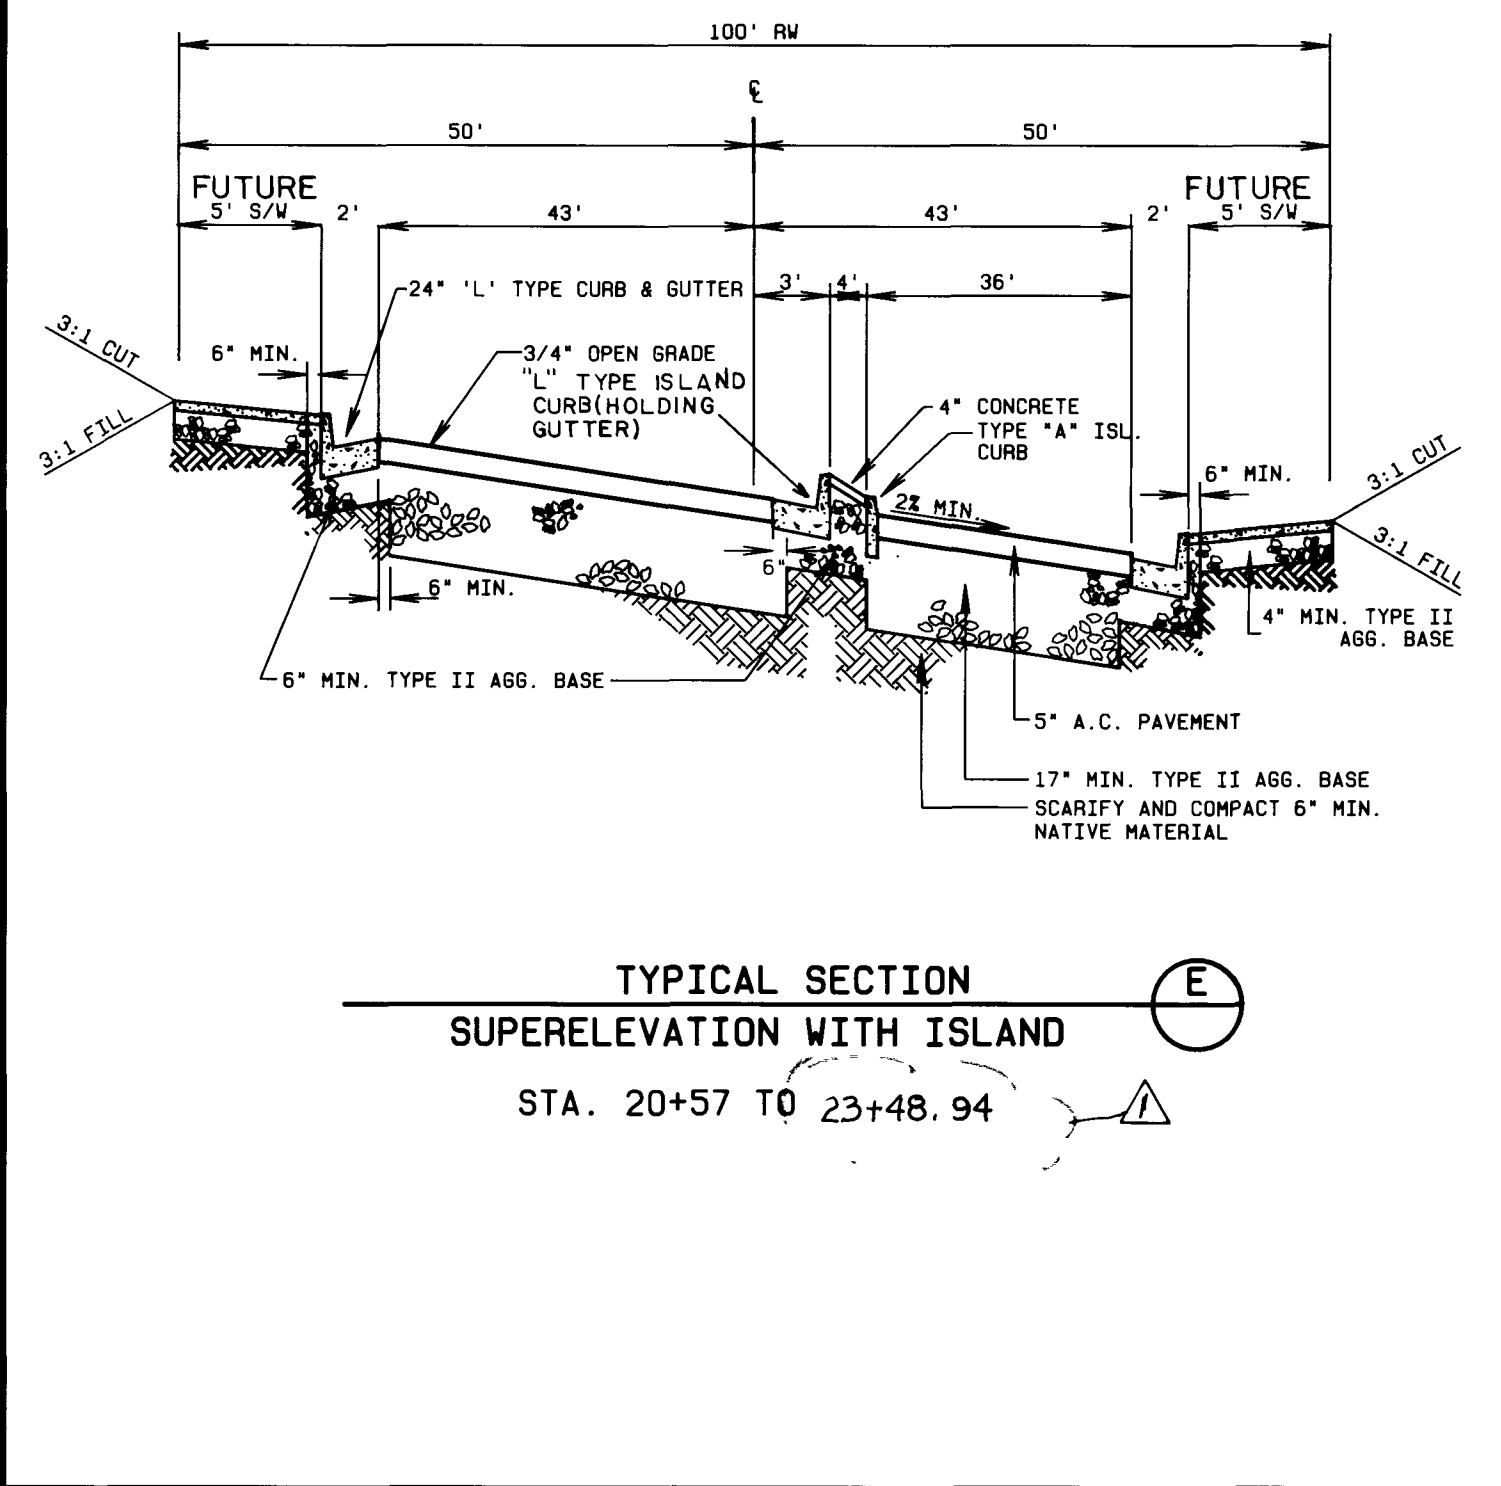


NOTE: NEW SIDEWALK NOT INCLUDED IN THIS CONTRACT

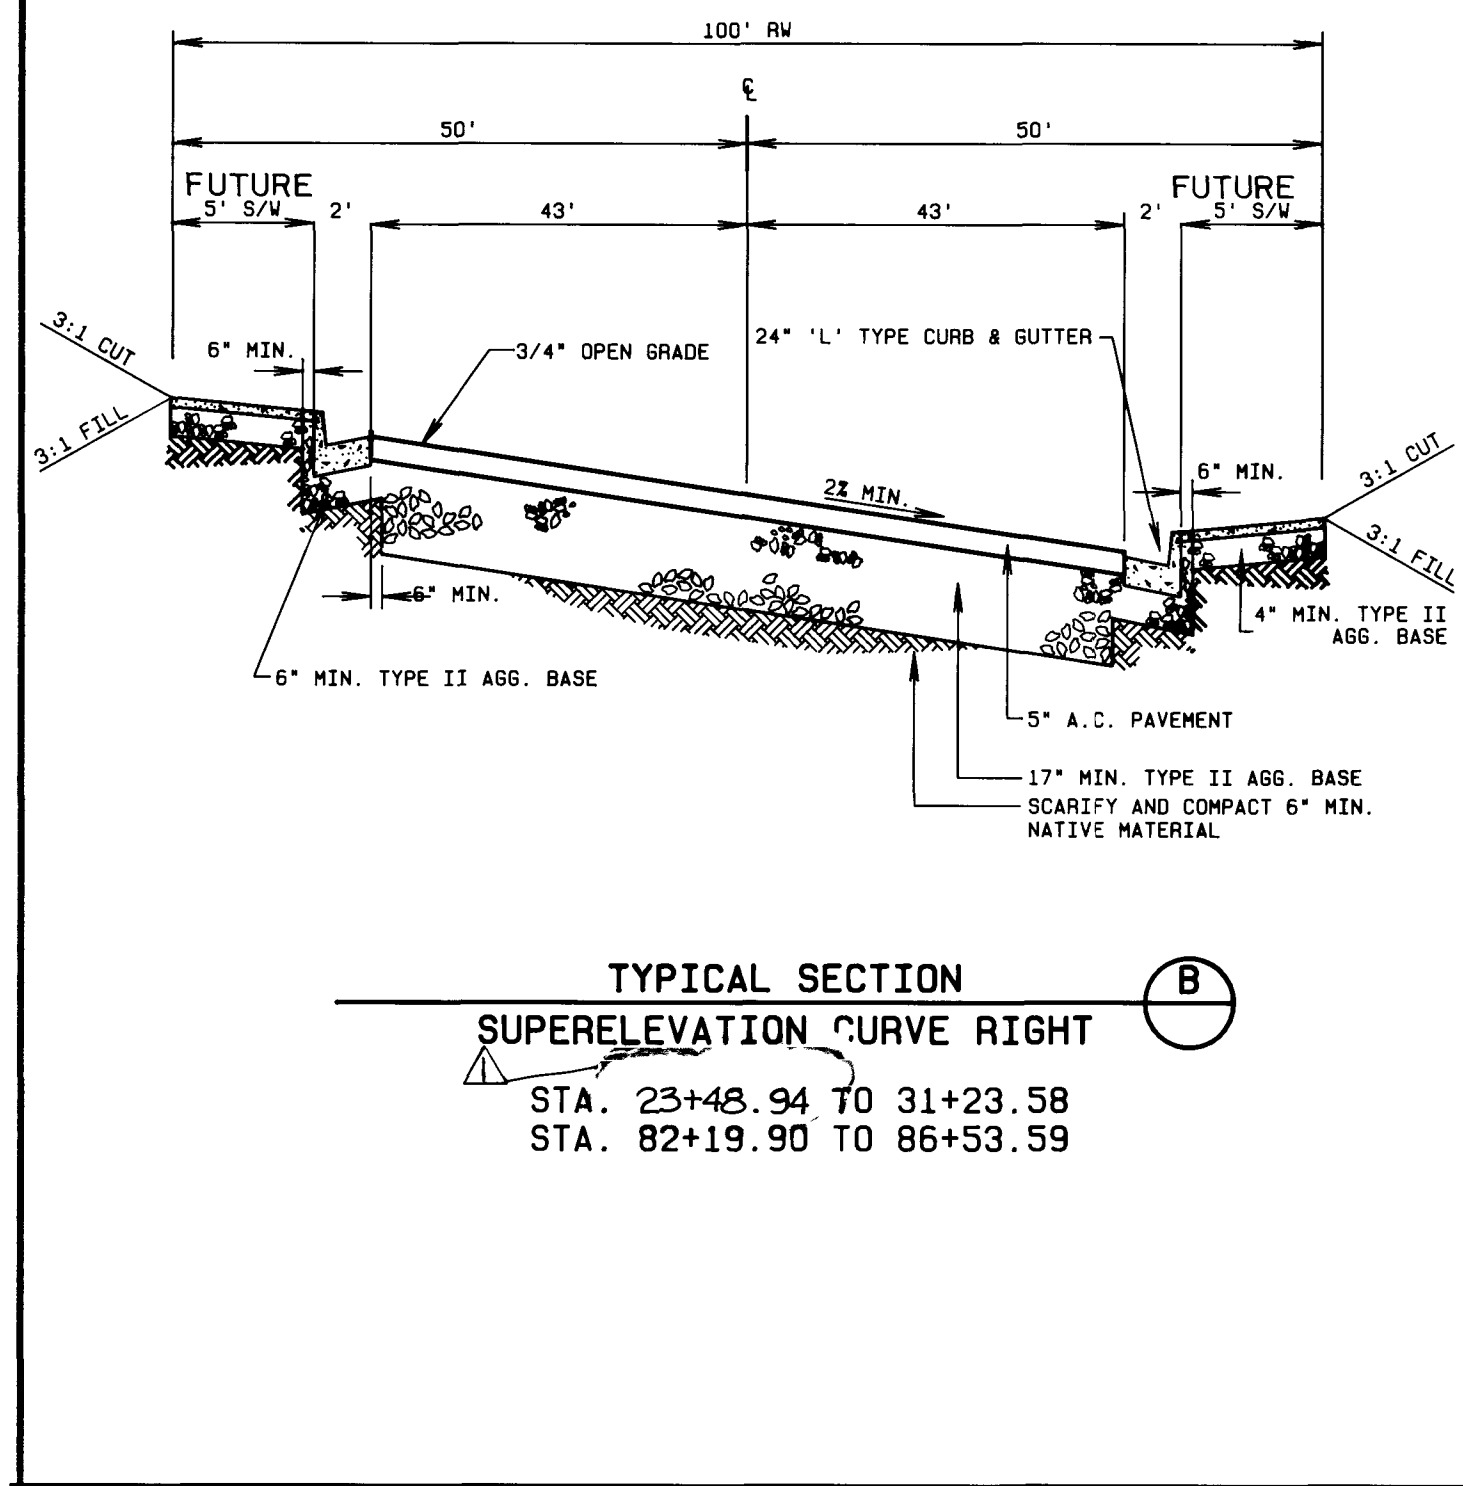

REV.	DATE	BY	REVISION

PROJECT: CITY OF LAS VEGAS, LAS VEGAS, NEVADA

PLANNERS - ENGINEERS CONSULTING  
2300 PASEO DEL PRADO, BUILDING A, SUITE 100  
LAS VEGAS, NEVADA 89102 PHONE (702) 873-7550


vtm nevada


TITLE: TYPICAL STREET SECTIONS AND DETAILS

PROJECT: LAKE MEAD BOULEVARD RANCHO TO TONOPAH


NO. NO. 3661  
BY D. L. A.  
DATE 9/10/90  
SCALE NONE

SHEET 3 OF 34 SHEETS

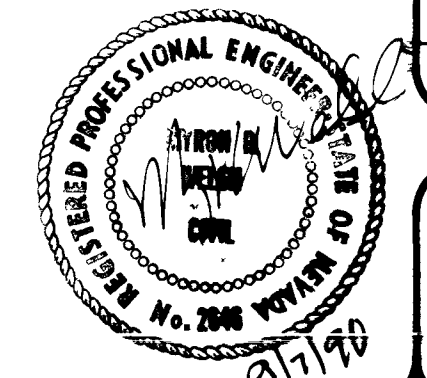


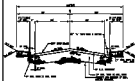



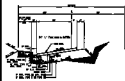



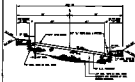


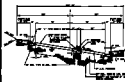



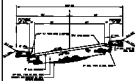





TYPICAL 3'-0" DIAM. MANHOLE

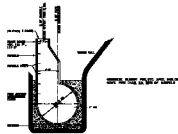



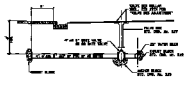



TYPICAL STREET SECTIONS  
 AND DETAILS  
 LAKE MEAD BOULEVARD  


