

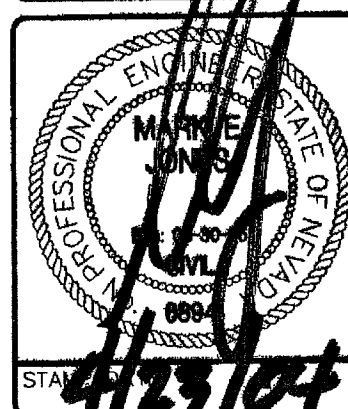
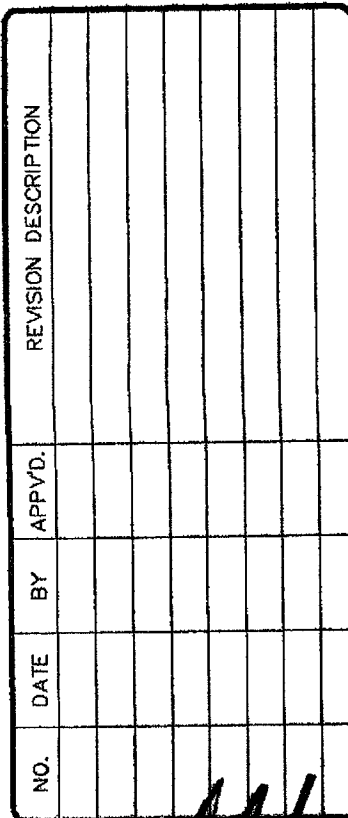


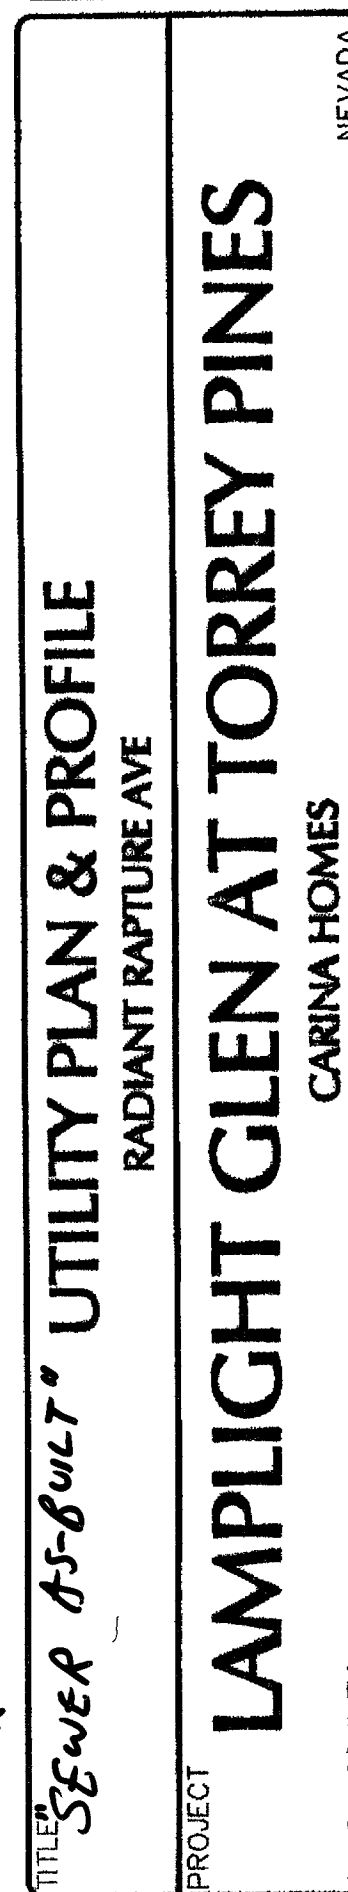

3610 North Rancho Drive
Las Vegas, Nevada 89130
Telephone: (702) 640-9700
fax: (702) 648-4143

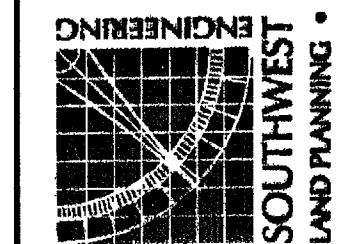

Note: All sewer pipe material is SDR35 PVC pipe.


WORK ORDER NO. 021230
DESIGN BY: TEAM 2
DATE: 8/5/03
SCALE: 1"=50'
CADFILE: tpws1pp5
SHEET 19 OF 19 SHEET
DWG NO. HTE#03-4241

EXISTING UTILITY LOCATIONS SHOWN HEREON ARE APPROXIMATE ONLY. IT SHALL BE THE CONTRACTOR'S RESPONSIBILITY TO DETERMINE THE EXACT VERTICAL AND HORIZONTAL LOCATION OF ALL EXISTING UNDERGROUND UTILITIES PRIOR TO COMMENCING CONSTRUCTION. NO REPRESENTATION IS MADE THAT ALL EXISTING UTILITIES ARE SHOWN HEREON. THE ENGINEER ASSUMES NO RESPONSIBILITY FOR UTILITIES NOT SHOWN OR UTILITIES NOT SHOWN IN THEIR PROPER LOCATION.

AVOID CUTTING UNDERGROUND UTILITIES IT'S COSTLY.

CALL
before you
Dig

1-800-227-2600
UNDERGROUND SERVICE (USA)

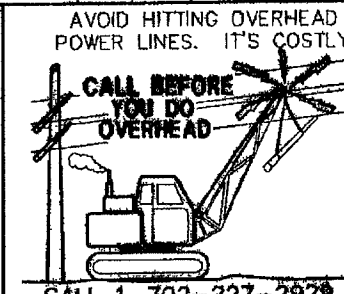

AVOID OTHER UNDERGROUND
TRAFFIC SIGNAL SYSTEMS
AND STREET LIGHT SYSTEM CONFLICTS
IT'S COSTLY

CALL BEFORE
YOU DIG
UNDERGROUND

Call before you dig
UnderGround
1-702-455-7511
CLARK COUNTY TRAFFIC OPERATIONS
AND 1-702-229-6611

CLARK COUNTY VERTICAL CONTROL v.2003
CITY OF LAS VEGAS RIVET AND ROUND PLATE IN CONCRETE PAD
±120' EAST OF GRAND TETON AND MAVERICK.
STATION 8LV90
14NNE6

ELEVATION= 720.144 METERS (NAVD88)
2362.67 FEET

NORTH 89°38'21" WEST BEING THE SOUTH LINE OF THE SOUTHEAST QUARTER (SE 1/4) OF THE NORTHEAST QUARTER (NE 1/4) OF SECTION 14, TOWNSHIP 19 SOUTH, RANGE 60 EAST, M.D.M., CLARK COUNTY, NEVADA, AS SHOWN BY MAP IN THE OFFICE OF THE CLARK COUNTY, NEVADA RECORDER IN FILE 109 OF SURVEYS PAGE 51.

10744826-1