
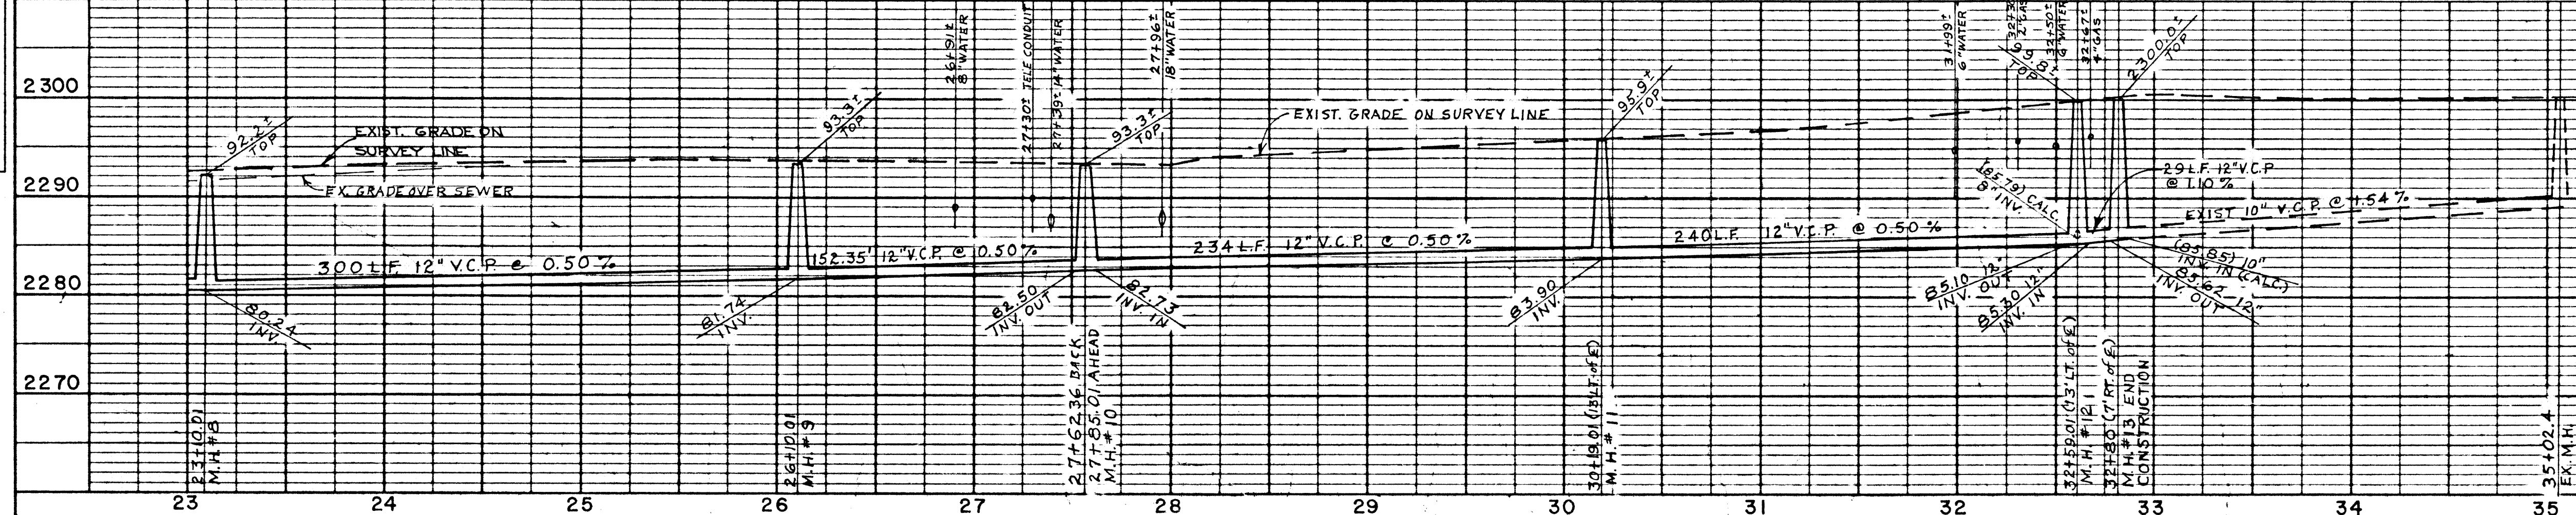
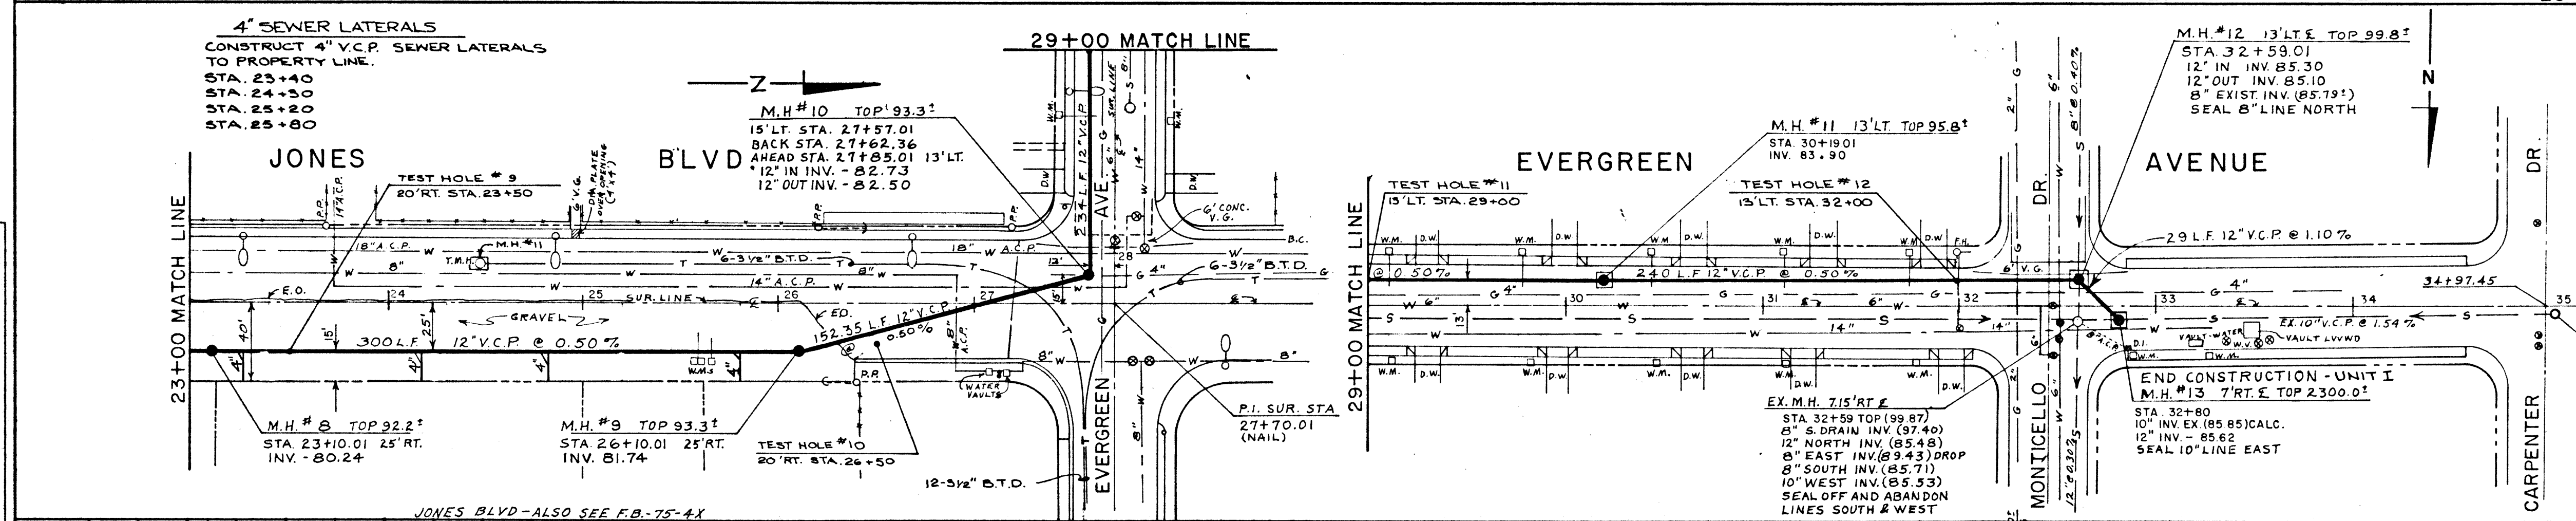
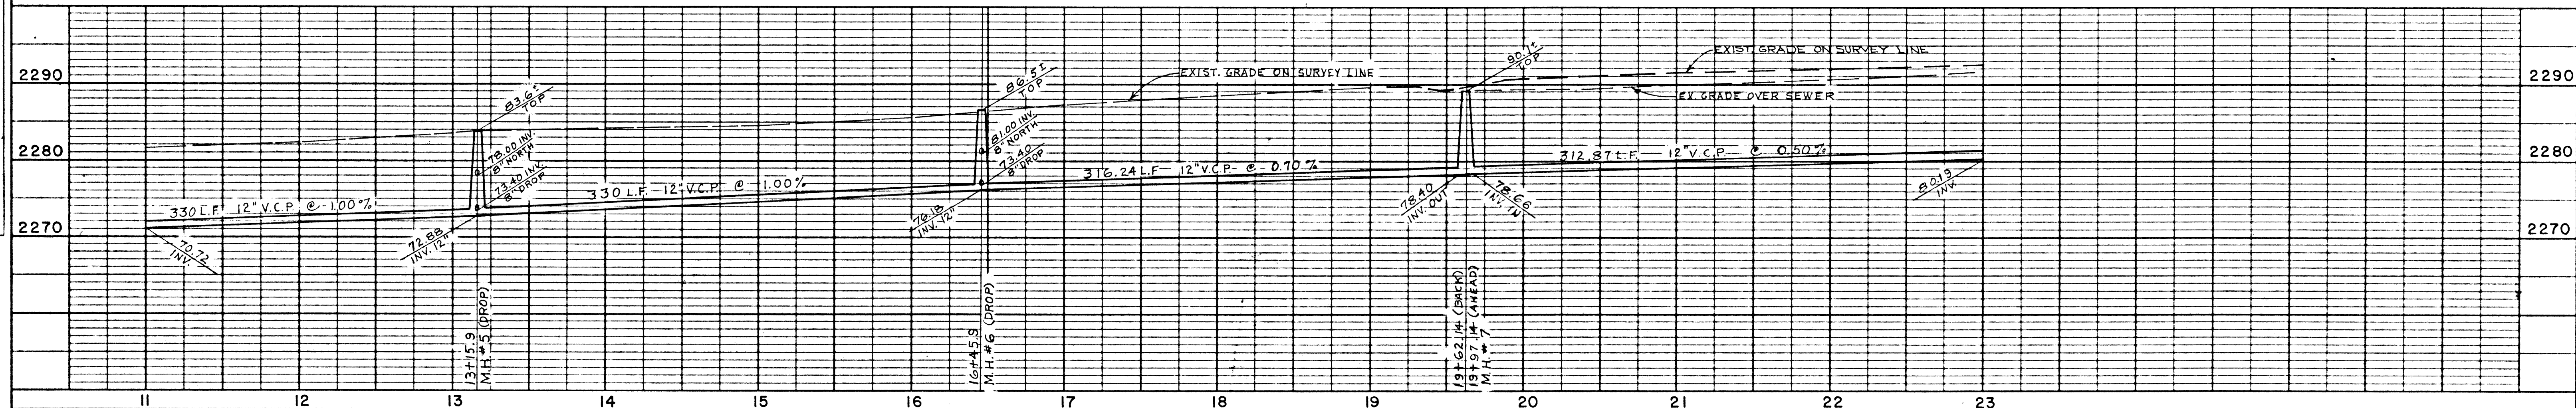


PLAN
SURVEYED
NOTE BOOK
ALIGNED
CHECKED
BY
DATE

PROFILE
SURVEYED
NOTE BOOK
CHECKED
BY
DATE

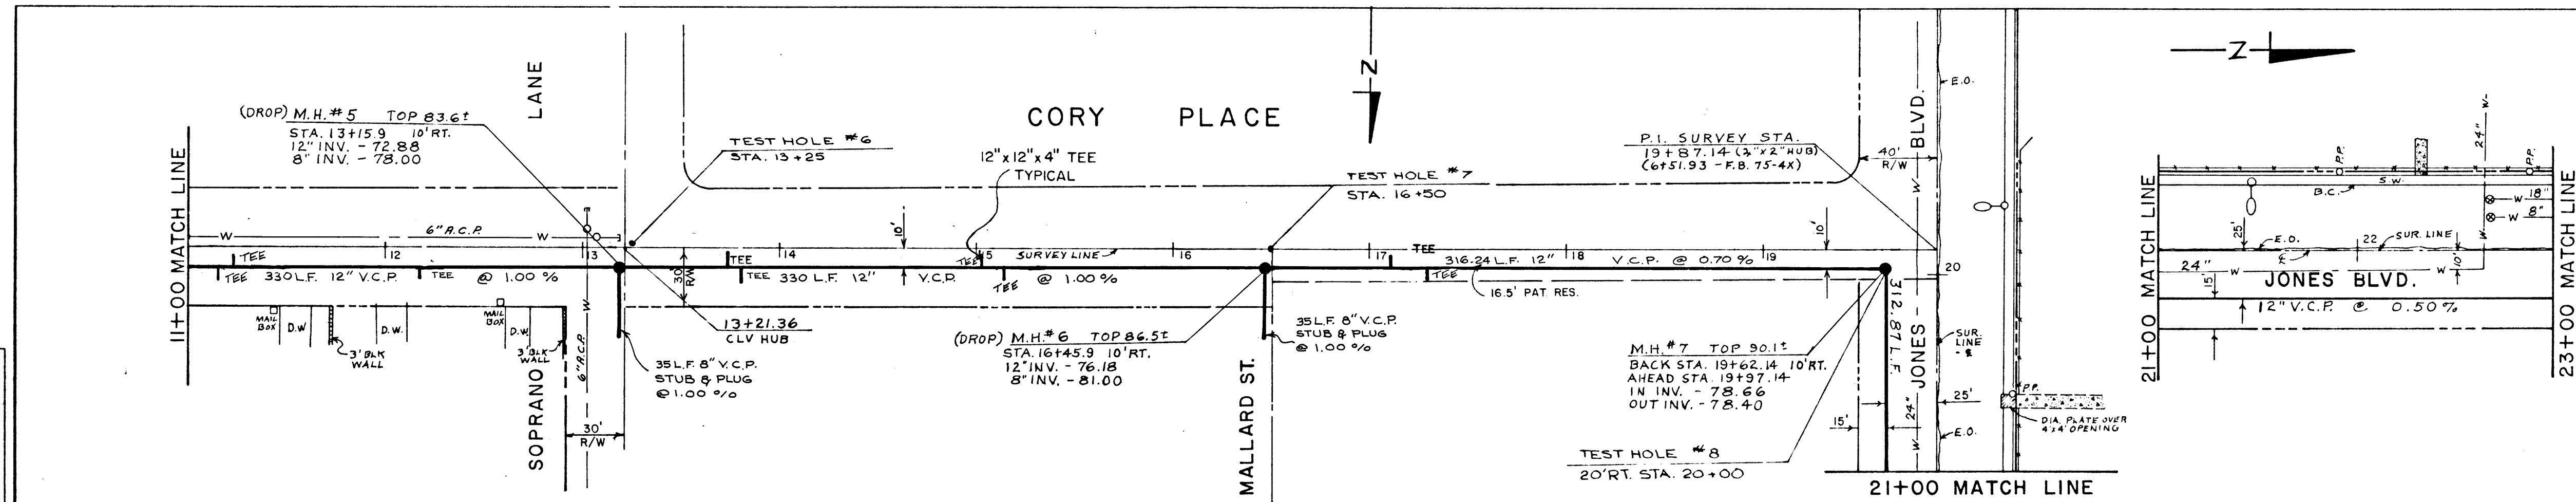

APPROXIMATE QUANTITIES - THIS SHEET UNIT I			
ITEM	DESCRIPTION	UNIT	QUANTITY
630.008	8" V.C.P. (2 STUB)	L. F.	70
630.012	12" V.C.P.	L. F.	2131
630.204	4' DIA. ECC. MANHOLE (7)	V. F.	87.1
630.214	4' DIA. ECC. (DROP) MANHOLE (2)	V. F.	21.1
630.004	4" V. C. P. (LATERAL) (4)	L. F.	60
630.112	12 X 12 X 4 V. C. P. TEE	E. A.	9
501.100	CONC. MANHOLE COLLAR	E. A.	3

BENCH MARK
B.M. 06036 C2
N.E. COR. CHARLESTON + JONES
ELEVATION - 2288.04

EX. M.H. 4.8' RT.
STA. 35+02.4
TOP (103.87)
INV. 10" EAST (89.27)

SEWER ROUTE ON CORY PLACE CHANGED TO 10' NORTH OF E. (WAS 2' S.)				J.H.E.	10-13-78	APPROVAL
REVISIONS						
CITY OF LAS VEGAS, NEVADA DEPARTMENT OF PUBLIC SERVICES ENGINEERING DIVISION						
JONES & CORY SEWER DIVERSION AND SMALL TRACTS SEWERS						
W.D. NO. 4250	E.B. NO. 77-78	DATE	DRAWING NO.			
32.14	1-150'	5-10'	307-V508			
DES. D. MCGONEGLE			FILE NO.			
DR. ESCOBAR - ELLISON			1-27-78			
APPROVED BY DIRECTOR OF PUBLIC SERVICES			S.I.D. 425			
			SHEET 3 OF 10			

BID No. 78.23 CONTRACT No. C.L.V. 1523