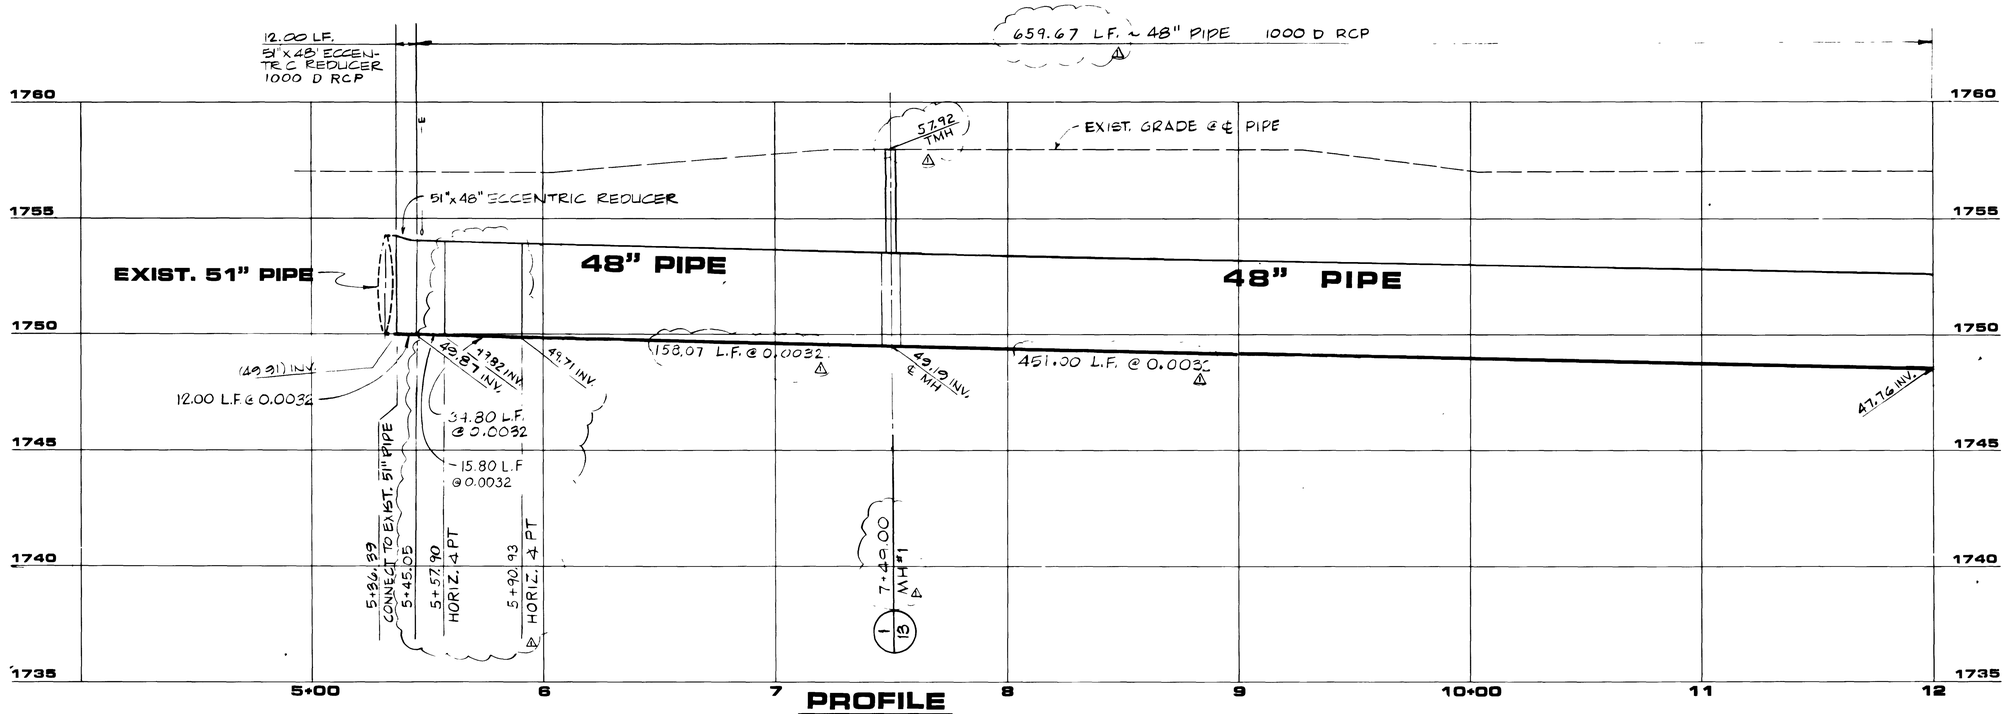

PROFILE

SCALE: HORIZ 1" = 30'
VERT 1" = 3'

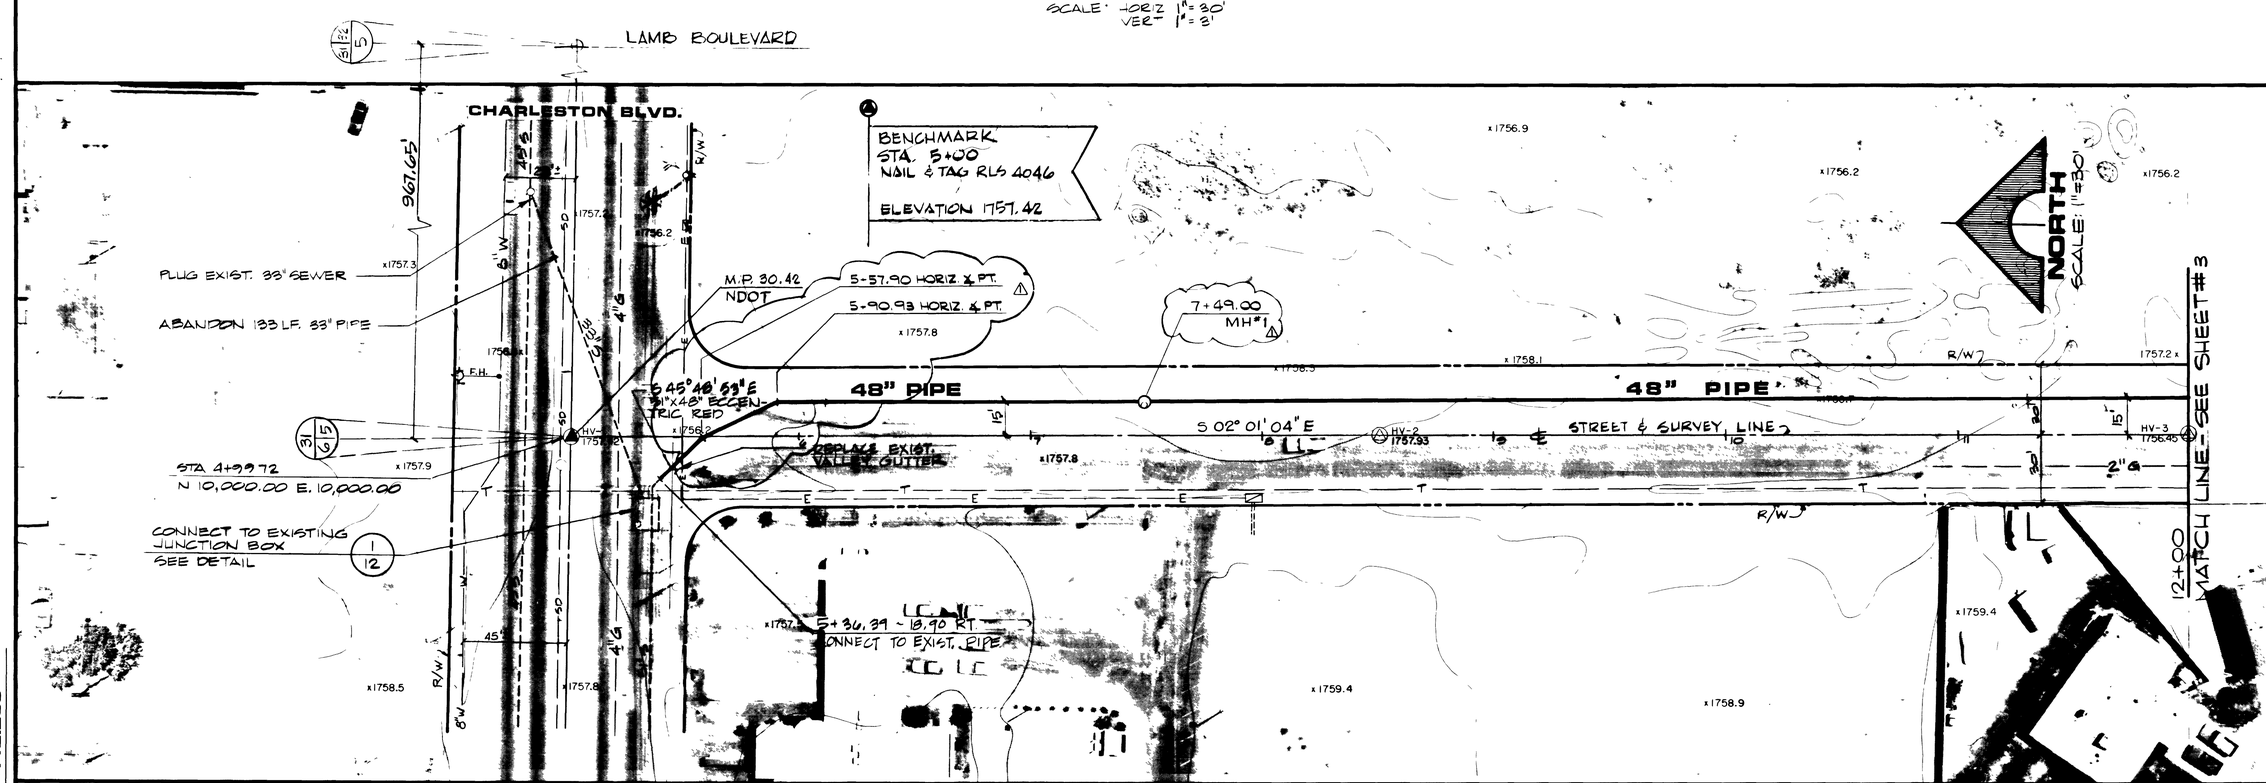

BROADALBIN DRIVE

RECORD DRAWING 307-V602

REV	DATE	DESCRIPTION
△	12/18/87	RECORD DRAWING

RECOMMENDED
R.E. NO. DATE

G. C. WALLACE
Consulting Engineers, Inc.
1100 East Sahara Ave. · Las Vegas, Nevada 89104 · 732-3330

DEPARTMENT OF ENGINEERING SERVICES
LAMB BLVD. RELIEF SEWER
PLAN & PROFILE 5+00 TO 12+00

SHEET 2 OF 13 SHEETS

JOB NO. 412.200

C.A.N. 050484

93

23-1-97

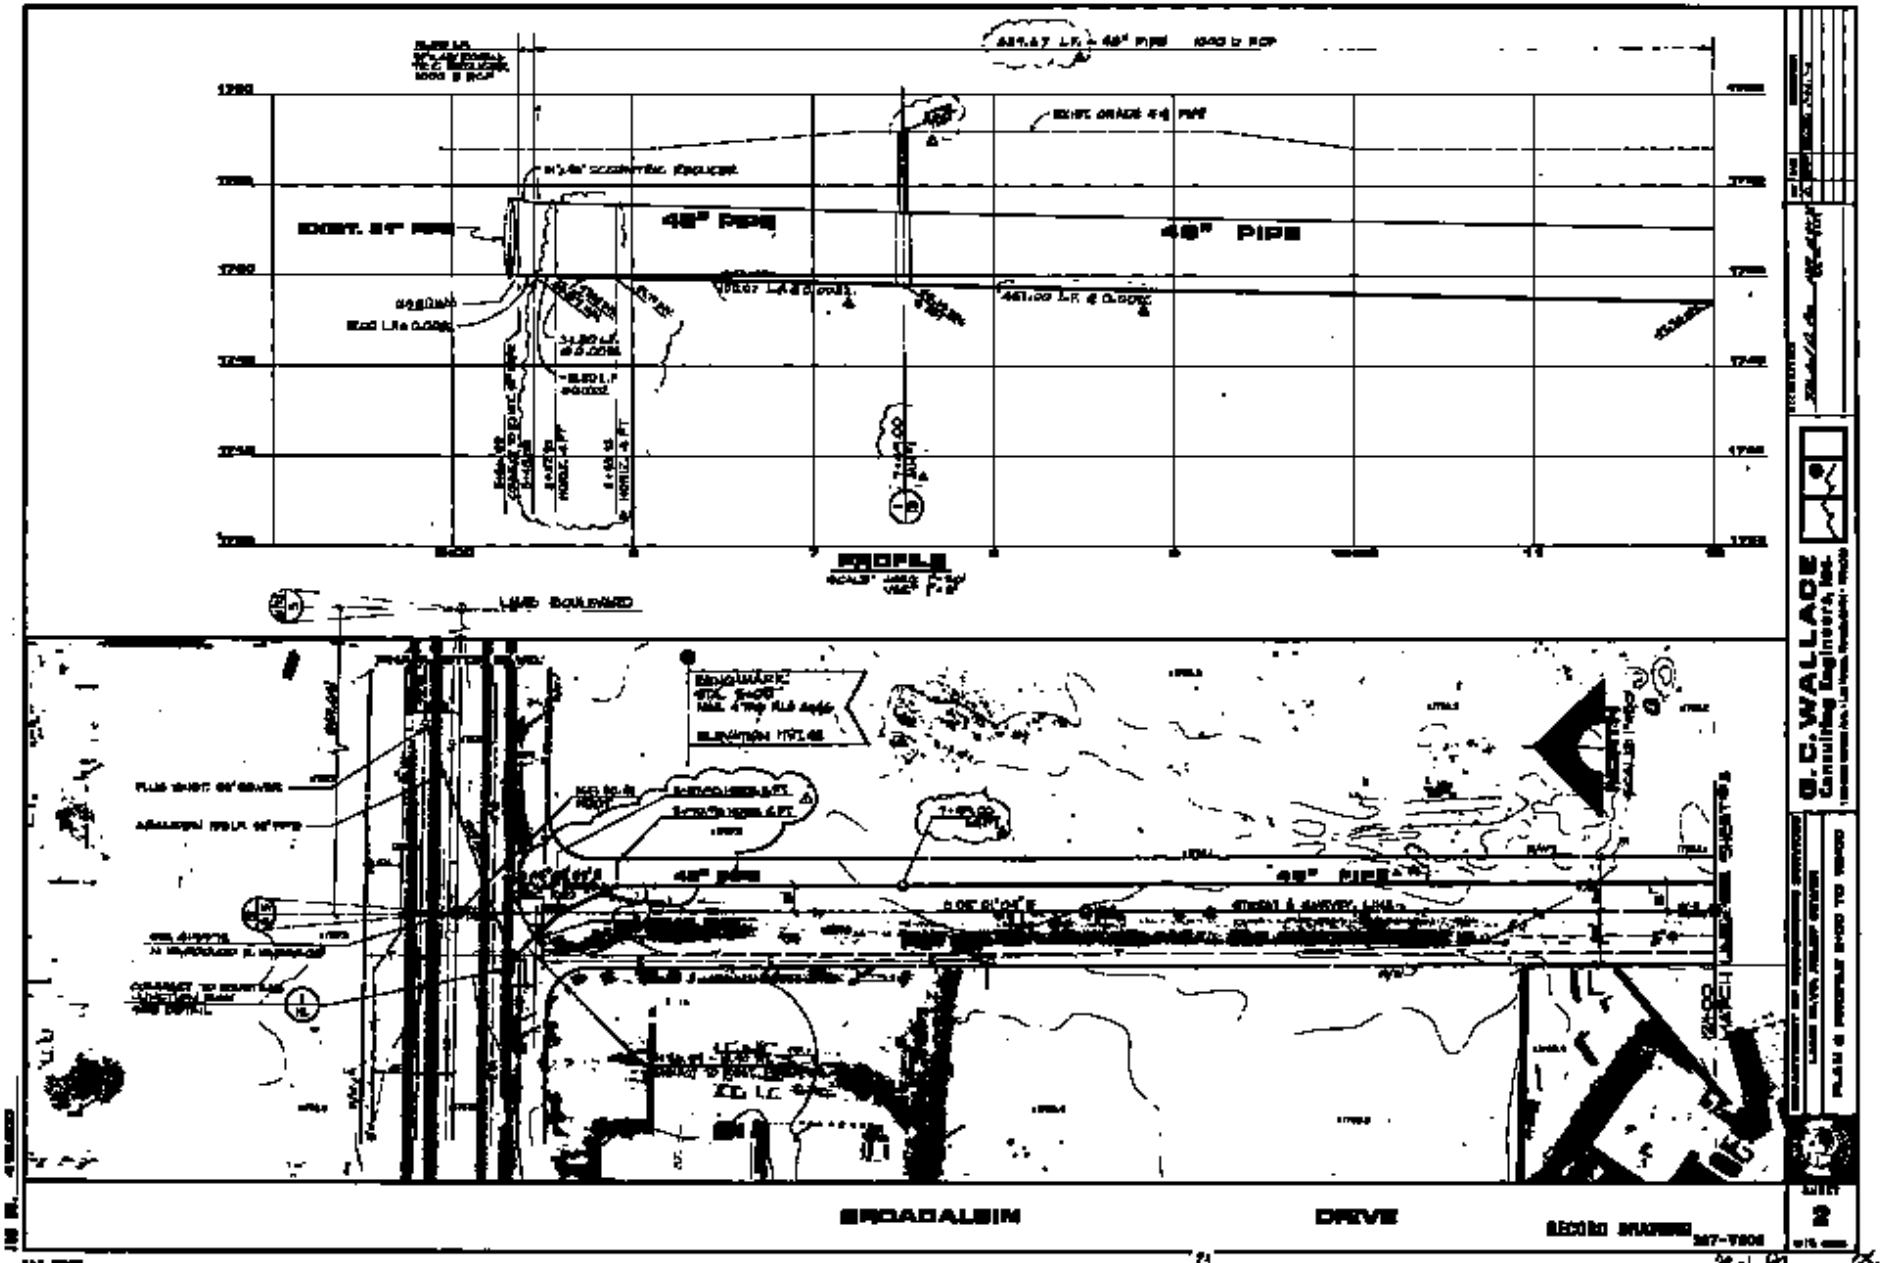
48" PIPE
48" PIPE
PROFILE
48" PIPE
48" PIPE
BROADALBIN
DRIVE
G.C. WALLACE
Consulting Engineers, Inc.
2

23-1-97