
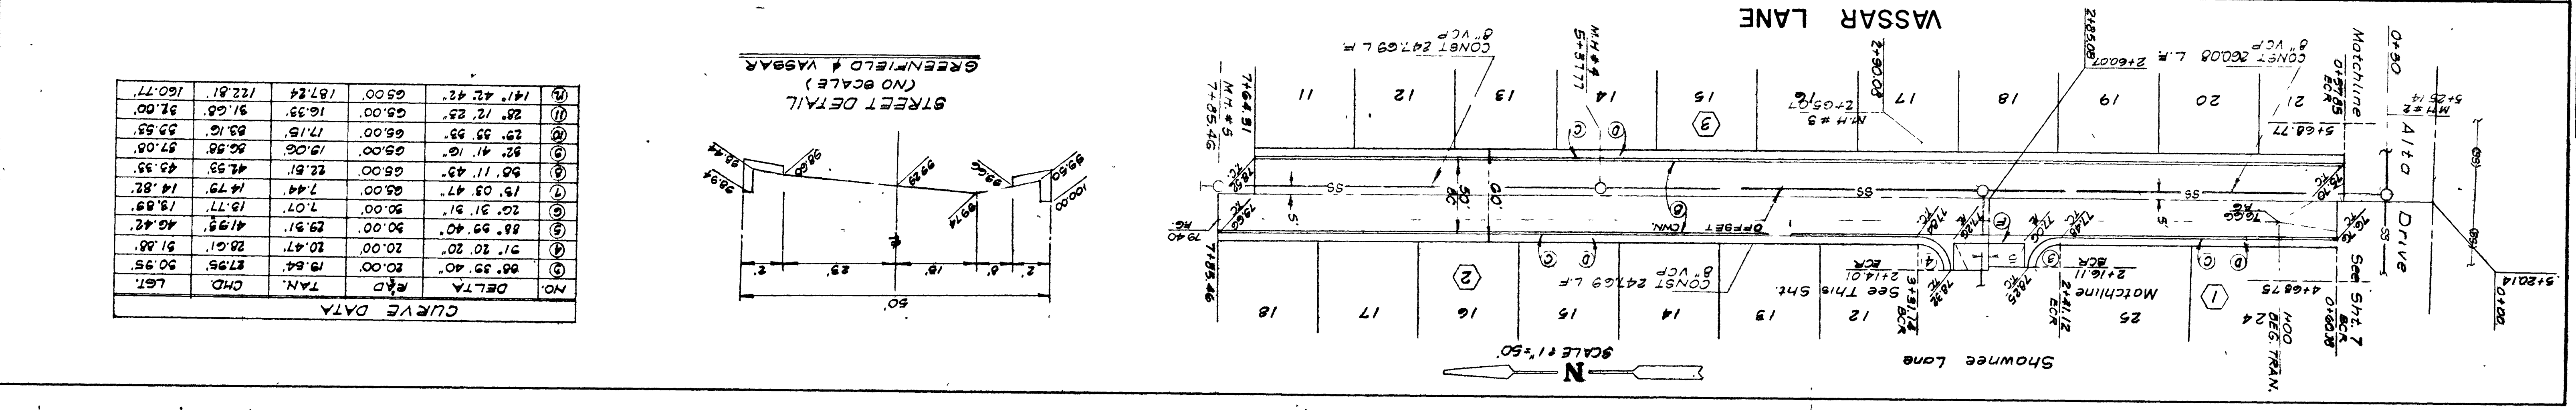
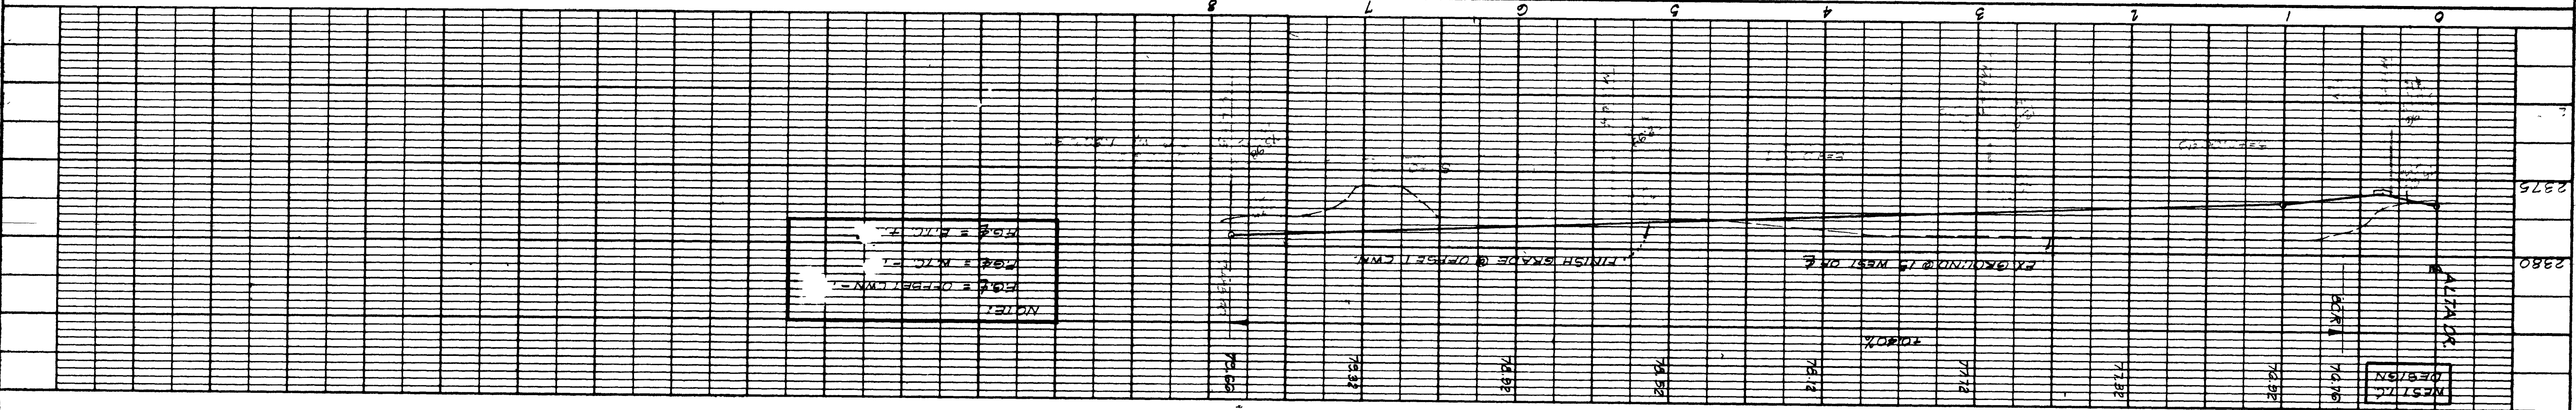
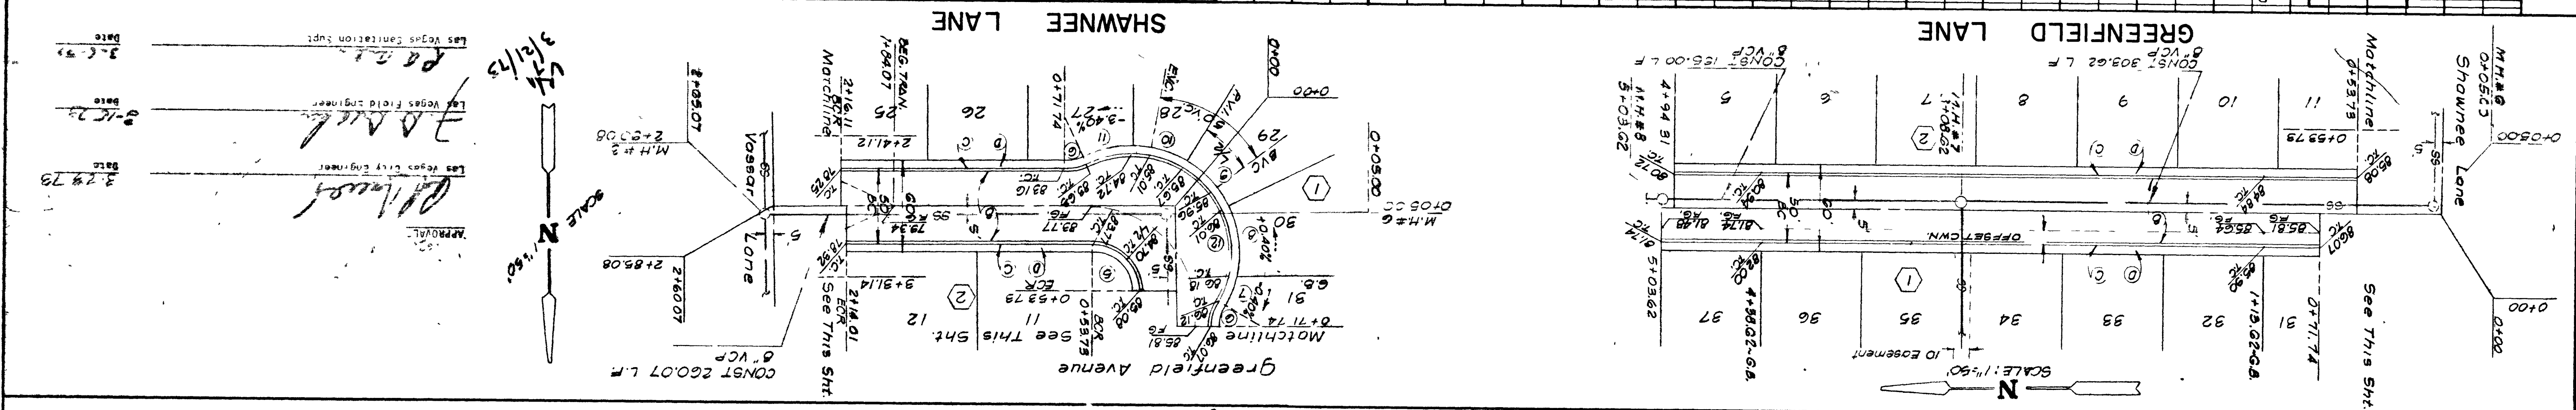





DATE	BY	REVISION	NOTED	DATE	BY	REVISION	NOTED

DATE	BY	REVISION	NOTED	DATE	BY	REVISION	NOTED

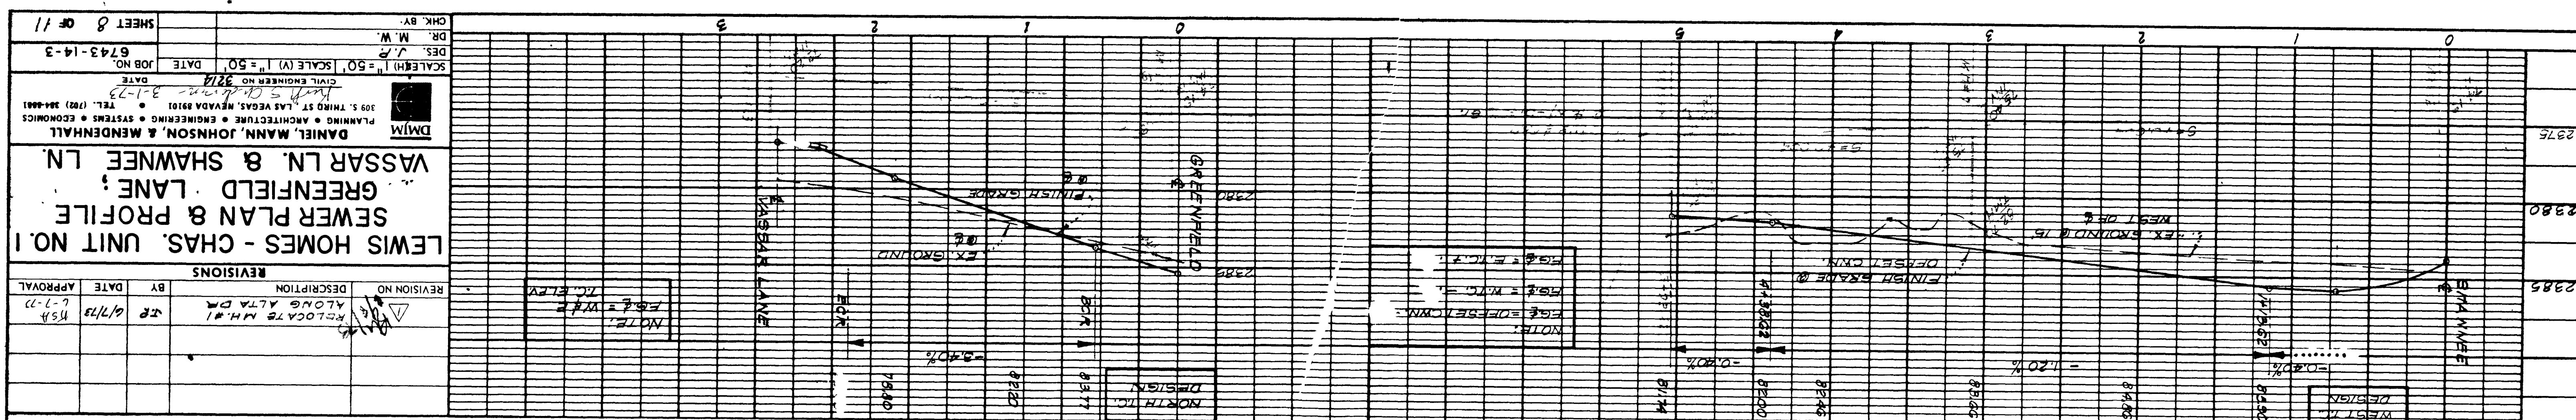

NO.	DELTA	TAN.	CHD.	LT.


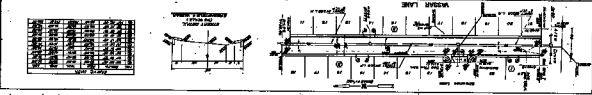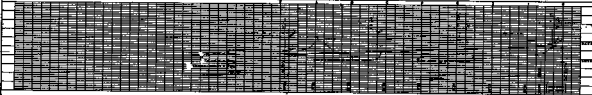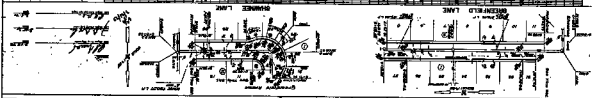

