
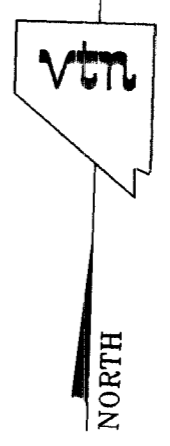


NOTE: CONTRACTOR SHALL VERIFY HORIZONTAL AND VERTICAL LOCATION OF EXISTING UTILITIES AND NOTIFY THE DESIGN ENGINEER IMMEDIATELY OF ANY DISCREPANCIES PRIOR TO CONSTRUCTION.

NOTE:
ALL MH STATIONING IS BASED ON SEWER LENGTHS FROM MANHOLE TO MANHOLE.
ALL MANHOLES ARE 48" SIZE MANHOLES PER STD.DWG# SD-1. UNLESS OTHERWISE SPECIFIED.

NOTE:
MANHOLES TEN (10') FEET OR DEEPER ARE REQUIRED TO HAVE LOCKING MANHOLE COVERS.

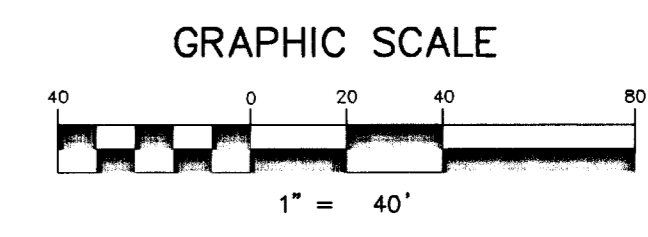

BENCHMARK
PROJECT VERTICAL DATUM: NAVD88
CLARK COUNTY BENCHMARK # 1C00-654
NAVD88 ELEV: 792.992 METERS (2601.67 FEET)
(CONVERSION FACTOR 3937/1200 = US SURVEY FEET)

DESCRIPTION:
RIVET AND SQUARE ALUMINUM IN A CONCRETE MONUMENT 50 FEET NORTH AND 25 FEET WEST OF GRAND CANYON DRIVE AND ALEXANDER ROAD.


BASIS OF BEARINGS:
NORTH 00 42'58" EAST, BEING THE EAST LINE OF THE NORTHEAST QUARTER (NE 1/4) OF SECTION 12, TOWNSHIP 20 SOUTH, RANGE 59 EAST, M.D.M., CLARK COUNTY, NEVADA, AS SHOWN ON THAT CERTAIN MAP ON FILE IN THE OFFICE OF THE COUNTY RECORDER, CLARK COUNTY, NEVADA IN FILE B1 OF SURVEYS, AT PAGE 44.

Avoid overhead power line contact
Avoid cutting underground utility lines. It's costly.

Call before you OVERHEAD
1-702-593-6111

Call before you Dig
1-800-227-2600

NOTE: SEE PAGE C3 FOR NOTES

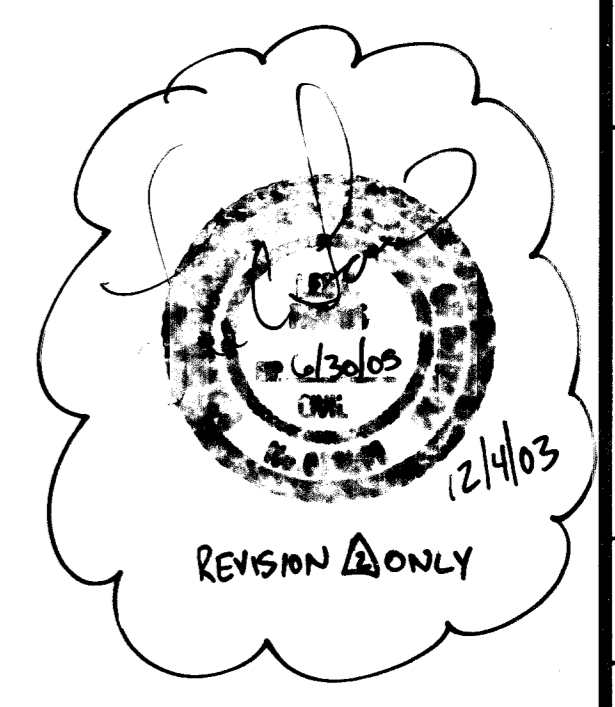

7	6	5	4	3	2	1
				REVISION	DATE	BY
				1	4-18-02	MTG
				2	12-2-03	REF
				3	5-21-04	E.C.
				4		
				5		
				6		
				7		

WARMINGTON HOMES
6787 WEST TROPICANA #20A
LAS VEGAS, NV. 89103
(702)-248-9450

SEWER PLAN & PROFILE
DELRAY BEACH AVENUE
STA: 20+2160 TO 26+08.52

LONE MOUNTAIN CONDOMINIUMS

CITY OF LAS VEGAS
2727 SOUTH RAINBOW BOULEVARD LAS VEGAS, NEVADA 89146-5148
PH: (702) 973-7550 FAX (702) 362-2597

nv
nevada
CONSULTING ENGINEERS • PLANNERS • LAND SURVEYORS

DRAWN BY: _____ MAY '01
DESIGNED BY: _____ MAY '01
CHECKED BY: _____
PROJECT NO: 5829
SCALE: 1"=40' HORIZ.
1"=40' VERT.

PROFESSIONAL ENGINEER
KENNETH F. MCDONNON
CIVIL
NO. 10539
STATE OF NEVADA
1-22-02

SHEET **SS9**
26 OF 29 SHEETS
DRAWING NO. 3074-4690

38097 40287 6027 69327
M. J. ...