



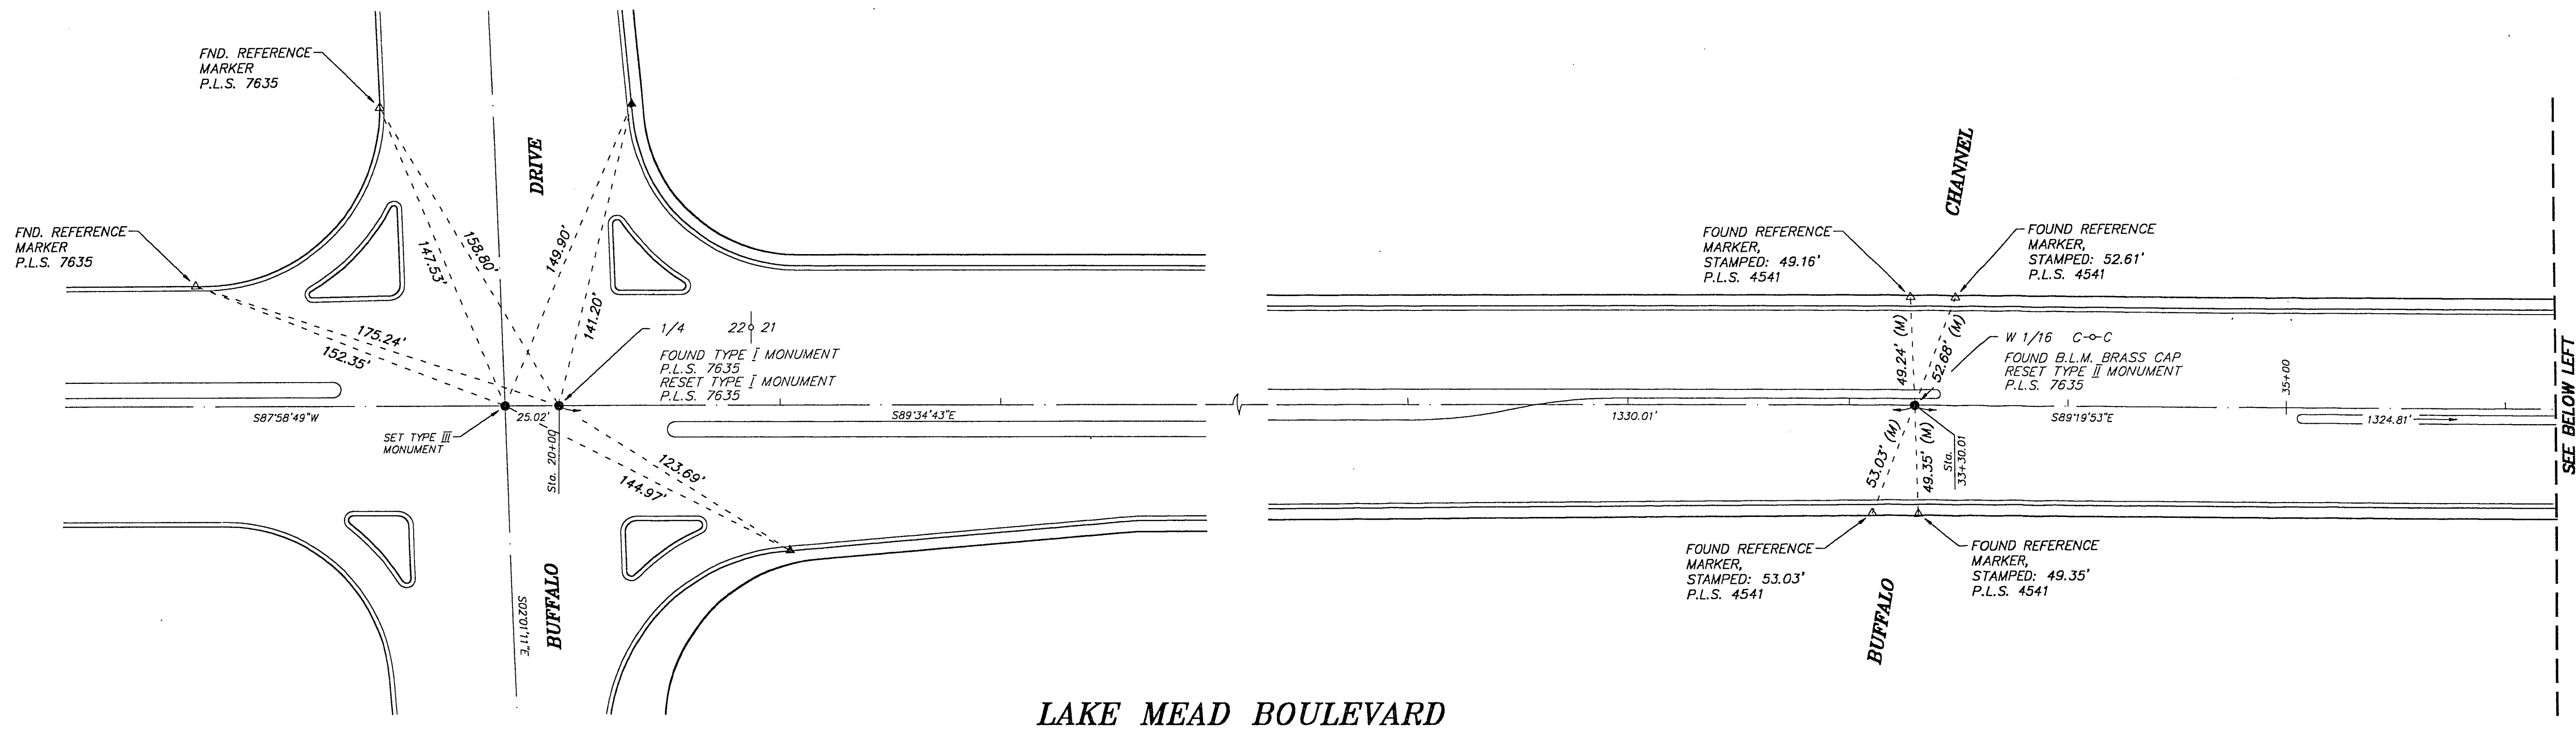

LAKE MEAD BOULEVARD

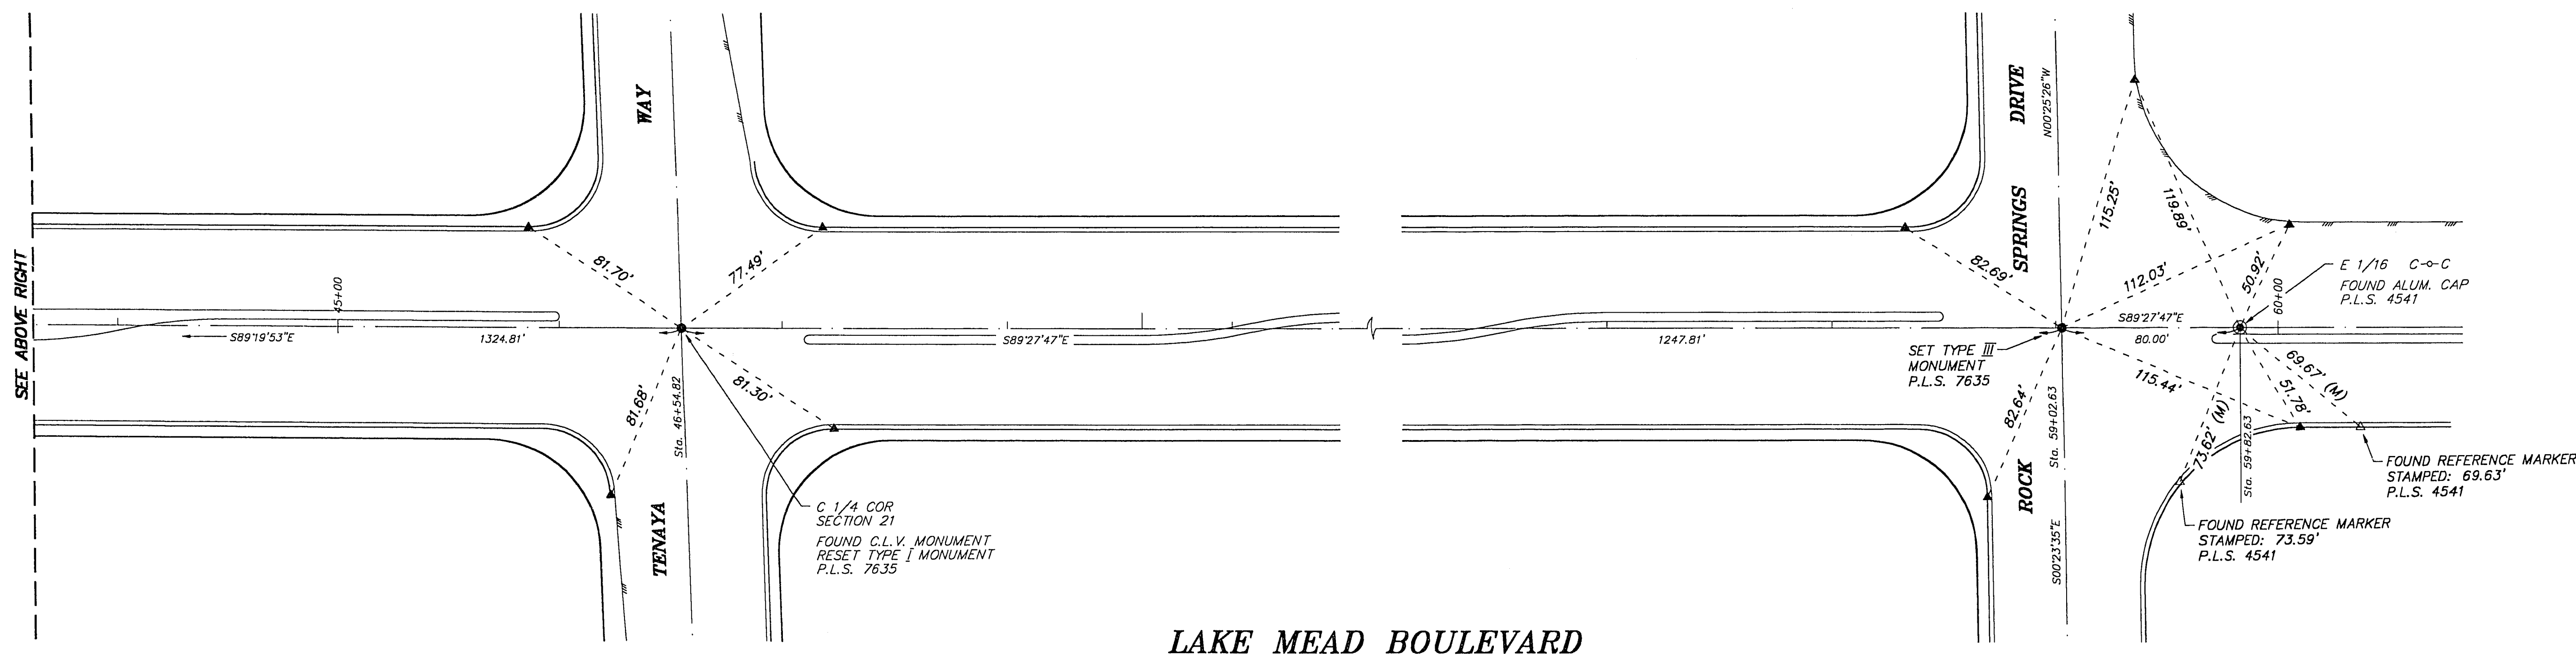


LAKE MEAD BOULEVARD

SURVEYOR'S CERTIFICATE

I, R. GUY DOTY, A PROFESSIONAL LAND SURVEYOR REGISTERED IN THE STATE OF NEVADA, DO HEREBY CERTIFY THAT THE MONUMENTS HAVE BEEN SET AND TIES ESTABLISHED AS SHOWN HEREON.

R. GUY DOTY
PROFESSIONAL LAND SURVEYOR
NEVADA CERTIFICATE NO. 7635

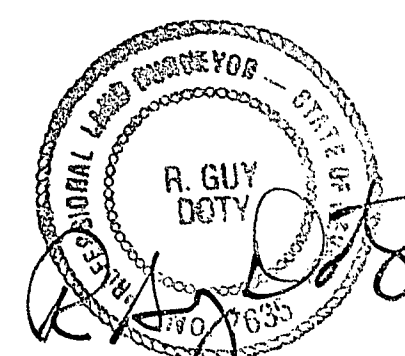

1-31-95

LEGEND

- STREET CENTERLINE
- SET MONUMENTATION, AS SHOWN AND DESCRIBED: P.L.S. 7635
- ⊙ FOUND MONUMENTATION, AS SHOWN & DESCRIBED
- △ FOUND REFERENCE MARKER, AS SHOWN & DESCRIBED
- ▲ SET 2" ALUMINUM REFERENCE MARKER IN TOP OF CURB W/ STAMPED TIE DISTANCE - P.L.S. 7635
- CONCRETE CURB & GUTTER
- EDGE OF ASPHALT PAVING

MONUMENTATION TIE MAP FOR

LAKE MEAD BOULEVARD
S.I.D. 1414

FROM
BUFFALO DRIVE
TO
ROCK SPRINGS DRIVE



GUY DOTY SURVEYING
P. O. Box 148 Logandale, NV 89021
Tele: Ofc: 397-8250 Hm: 398-3250 Mobile: 498-9900

SHEET 1 OF 1

9-2-14 Tie Map for 107-V2096