
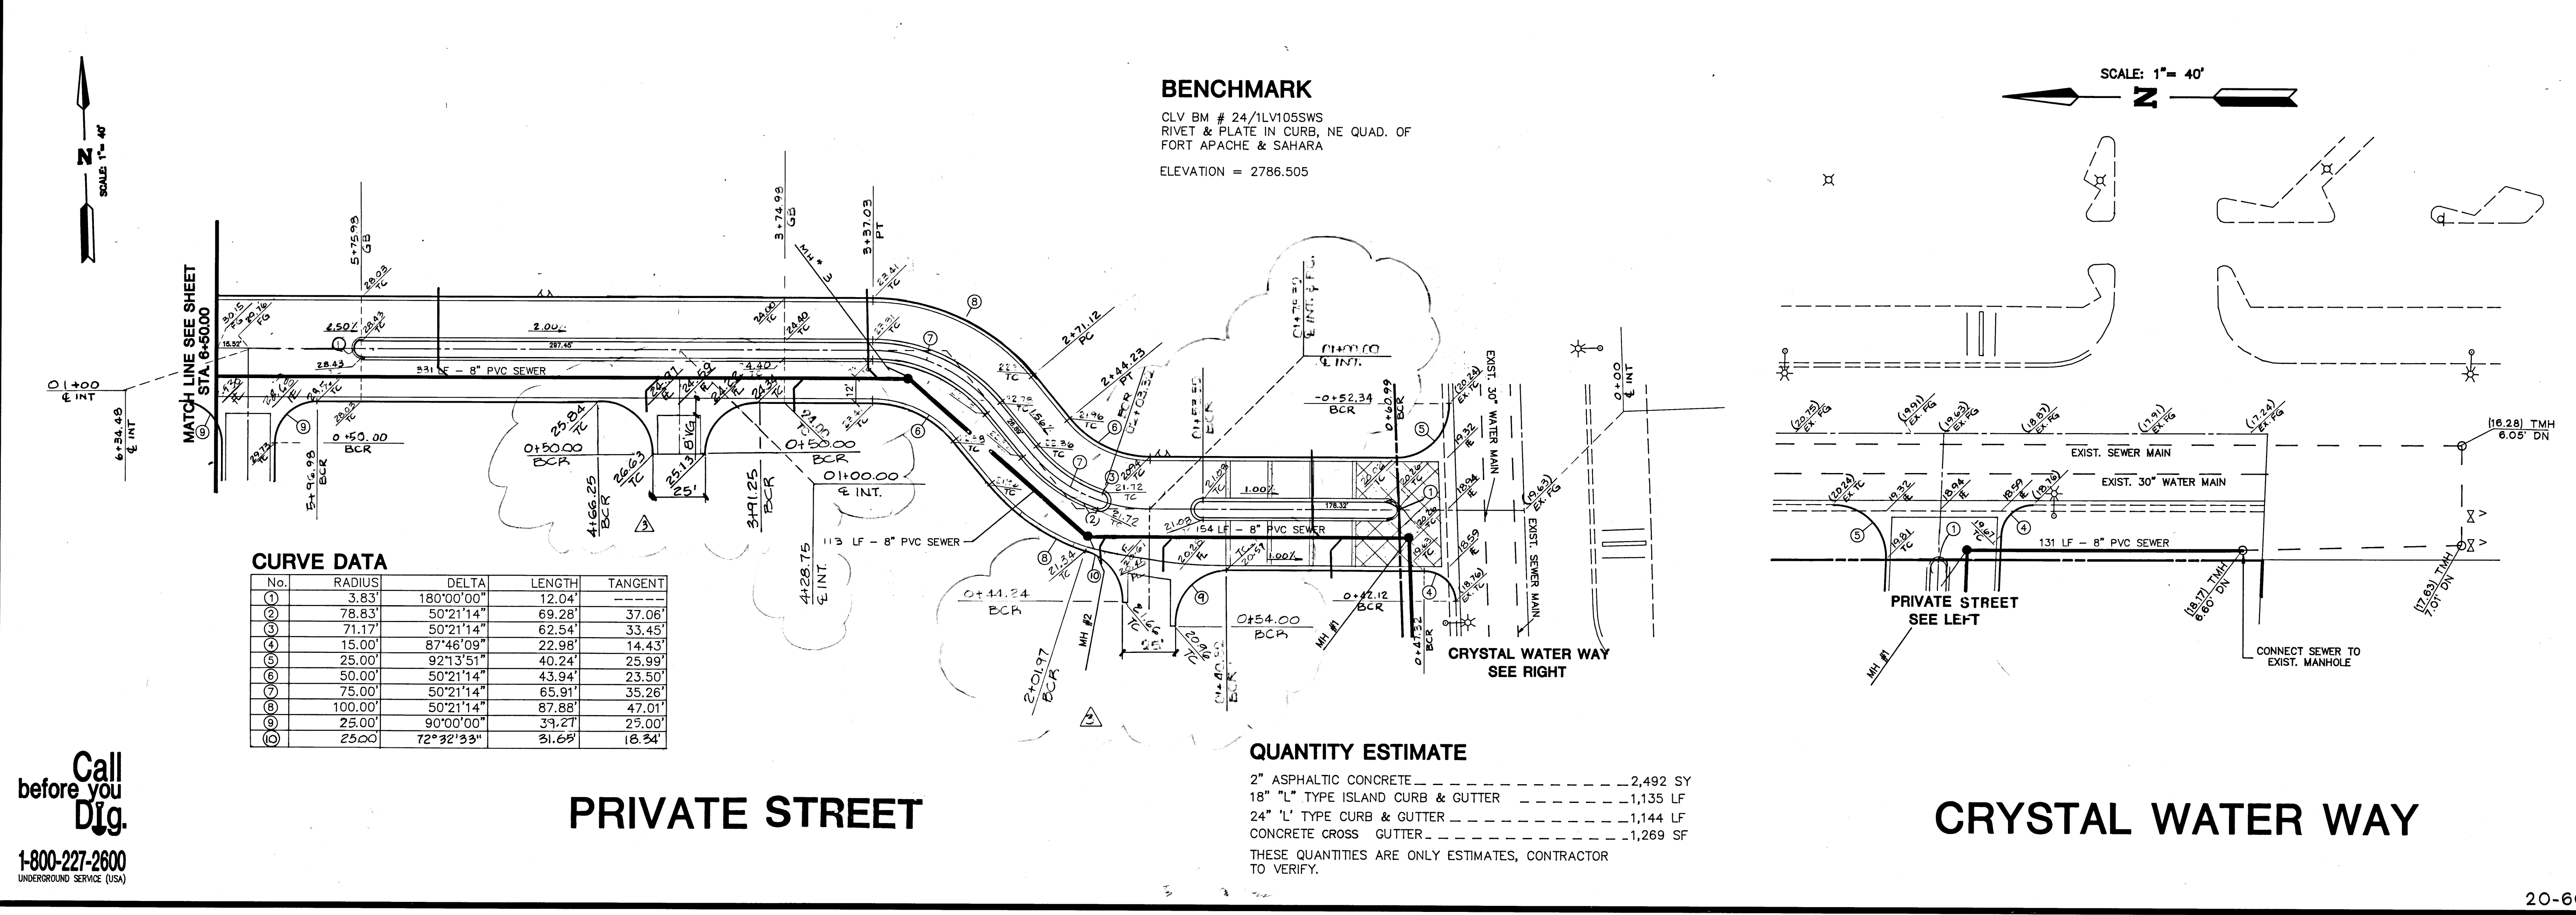


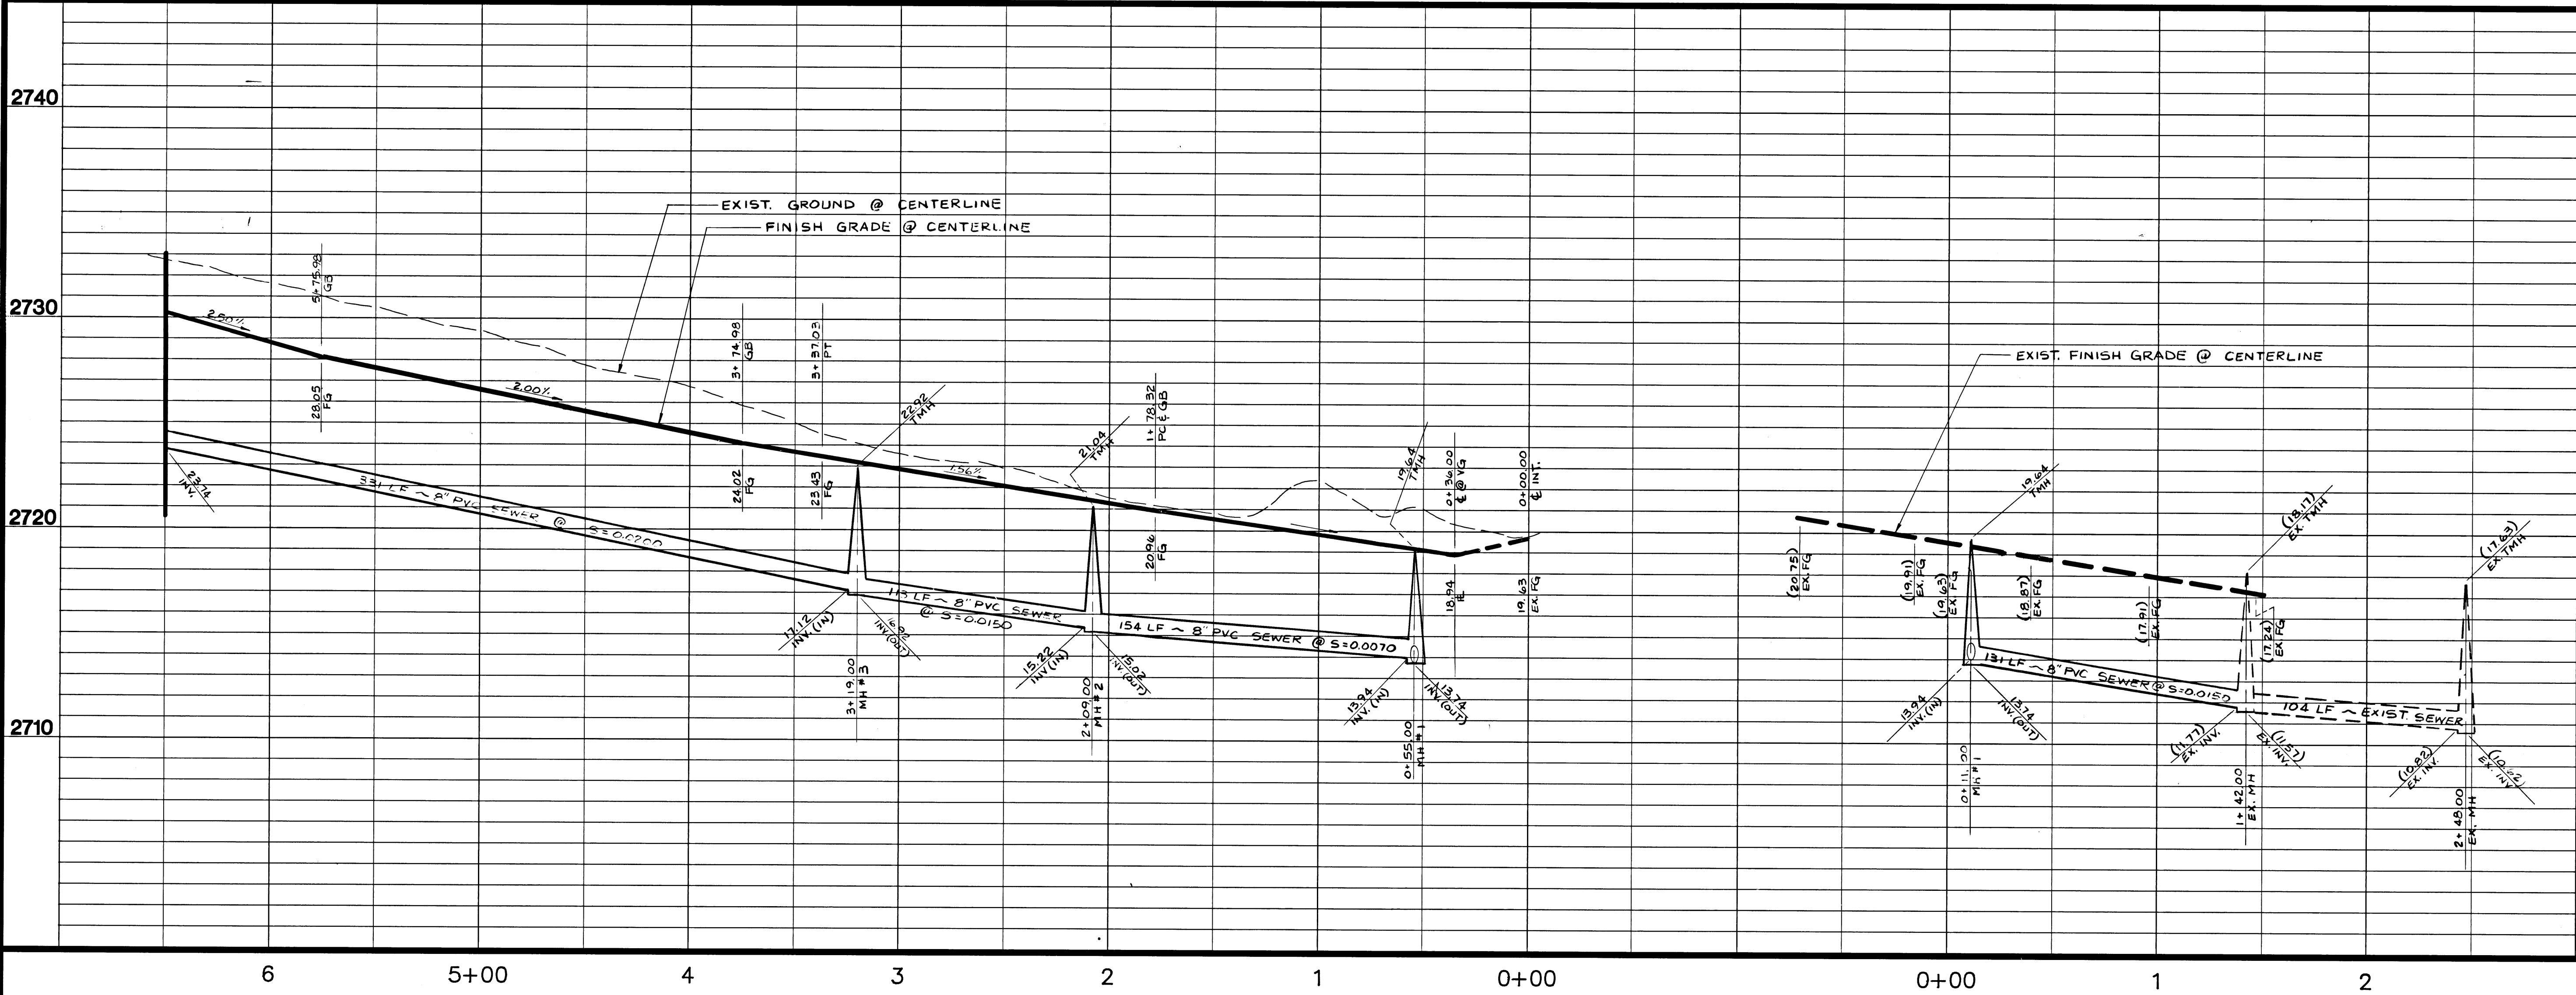

CURVE DATA

No.	RADIUS	DELTA	LENGTH	TANGENT
1	3.83'	180°00'00"	12.04'	---
2	78.83'	50°21'14"	69.28'	37.06'
3	71.17'	50°21'14"	62.54'	33.45'
4	15.00'	87°46'09"	22.98'	14.43'
5	25.00'	92°13'51"	40.24'	25.99'
6	50.00'	50°21'14"	43.94'	23.50'
7	75.00'	50°21'14"	65.91'	35.26'
8	100.00'	50°21'14"	87.88'	47.01'
9	25.00'	90°00'00"	39.27'	25.00'
10	25.00'	72°32'33"	31.65'	18.34'

QUANTITY ESTIMATE

2" ASPHALTIC CONCRETE ----- 2,492 SY

18" "L" TYPE ISLAND CURB & GUTTER ----- 1,135 LF

24" "L" TYPE CURB & GUTTER ----- 1,144 LF

CONCRETE CROSS GUTTER ----- 1,269 SF

THESE QUANTITIES ARE ONLY ESTIMATES, CONTRACTOR TO VERIFY.

2740

2730

2720

2710

2740

2730

2720

2710

APPROVAL

DATE

BY

REVISION

1

3-27-94

TB


2

3-28-94

RA


3

8-9-95

DB

ADDED 2" DRIVEWAYS & GRADES

STREET & SEWER PLAN & PROFILE

(PRIVATE STREET)

LAKES BUSINESS CENTER

ENGINEER

STATE OF NEVADA

REGISTERED PROFESSIONAL ENGINEER

DANNY S. MCGADDEN

NO. 83818

3-25-94

ESI ENGINEERS AND SURVEYORS INC.

PLANNERS • CONSULTING ENGINEERS • SURVEYORS

708 W. CHARLESTON BLVD. • LAS VEGAS, NEVADA 89107 • 702-210-8020

W.O. #

210-8020

BY

T.B.

DATE

FEB. 1994

SCALE

1" = 40'

20-60-08

107-V2196

Call before you Dig.

1-800-227-2600

UNDERGROUND SERVICE (USA)